



PERMIT NO.

CITY OF NEW BEDFORD
SEWER AND/OR STORM DRAIN PERMIT

DATE 11/13/07

24026

This certifies that permission is granted to

Steven Resendes 41 Spinnaker Way Westport 5086543148
Property Owner Address Tel

#282 Princeton (S.S.)

To connect a sewer and/or storm drain located at stub at prop line 200' W x Brook St.

Assessor's Plot 113 Lot 183, to the sewer and/or storm drain in Princeton Street

To be laid in accordance with the conditions in this application and the City of New Bedford ordinances.

TYPE OF USE: RESIDENTIAL COMMERCIAL INDUSTRIAL FLOW 330 G.P.D.

If applicant other than actual property owner, attach Letter of Authorization from Property Owner.

Name..... Tel.....
Mailing Address.....

The Bonded Contractor/Drain Layer authorized to perform this work is:

J.S. Luy Inc. 12 Ventura Dr. Dartmouth 508.995.3535
Name Address Tel

Type of Pipe Required: adr 3.5 pvc

PERMIT EXPIRES ONE YEAR AFTER DATE OF ISSUE

- Requires separate connections for sewage and storm drain where applicable. Storm water cannot be discharged to a sanitary sewer.
- All work must be inspected and approved by a D.P.I. inspector before backfilling.
- If this connection is to be part of a private service shared jointly with other building owners, attach copy of Recorded Joint Maintenance Agreement.
- Permits can be issued to Industrial and/or Commercial Applicants only upon receipt and approval by the Commissioner of Public Infrastructure of required plans and supplemental information.
- In addition, a City-issued Industrial User Discharge Permit and/or a Sewer Extension/Connection Permit issued by the Commonwealth of Massachusetts D.E.P. shall be required by the City for Industrial Discharge into the sewer system.

Industrial User Discharge Permit No..... Date.....

Comm. Mass. Sewer Conn./Ext. Permit No..... Date.....

A Filing and Inspection Fee of \$ 150.00 plus an Entrance Fee of \$..... where applicable, must accompany this application.

Bank# Chase Check# 1010 Date 11/13/07 Receipt# 7584

Other requirements: 24 hr. inspection 508.979.1527

Connection made to Sewer Part of jointly-shared private line YES NO
Storm Drain

Applicant agrees to abide by the above terms, as well as all pertinent ordinances of the City of New Bedford, and such other special rules as the Commissioner of Public Infrastructure and/or City Engineer may deem necessary

Luiz M. Andrade
Acting City Engineer mn

[Signature]
Signature of Property Owner or Representative


INSPECTOR'S REPORT

INSPECTED BY: Bob Bichel
DATE: 11/26 & 11/27/2007
COMMENTS:

APPROVED

DISAPPROVED

SIGNATURE

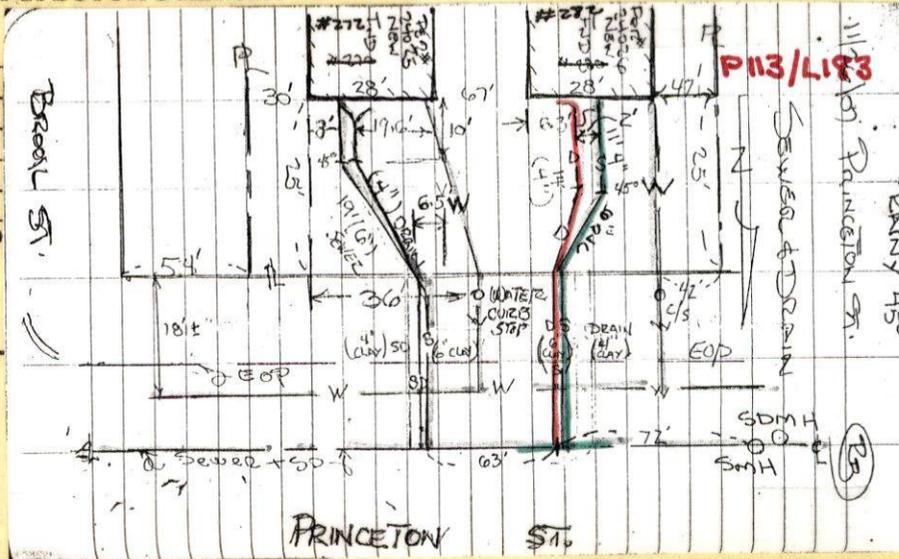

See attached.



PERMIT NO.
24026

CITY OF NEW BEDFORD
SEWER AND/OR STORM DRAIN PERMIT

DATE 11/13/07

This certifies that permission is granted to

Steven Resendes 41 Spinnaker Way Westport 5086543148
Property Owner Address Tel.

To connect a sewer and/or storm drain located at... stub at prop line 200' ex x Beach St.
Assessor's Plot 11.3 Lot 183, to the sewer and/or storm drain in... Princeton Street

To be laid in accordance with the conditions in this application and the City of New Bedford ordinances.

TYPE OF USE: RESIDENTIAL COMMERCIAL INDUSTRIAL FLOW 330 G.P.D.

No Bonded Contractor needed - Private Property

If applicant other than actual property owner, attach Letter of Authorization from Property Owner.

Name..... Tel.....

Mailing Address.....

The Bonded Contractor/Drain Layer authorized to perform this work is: water on/g

J.S. Lutz Inc. 12 Ventura Dr. Dartmouth 508 995 3535
Name Address Tel.

Type of Pipe Required: sdr 3.5 pvc

PERMIT EXPIRES ONE YEAR AFTER DATE OF ISSUE

- Requires separate connections for sewage and storm drain where applicable. Storm water cannot be discharged to a sanitary sewer.
- All work must be inspected and approved by a D.P.I. inspector before backfilling.
- If this connection is to be part of a private service shared jointly with other building owners, attach copy of Recorded Joint Maintenance Agreement.
- Permits can be issued to Industrial and/or Commercial Applicants only upon receipt and approval by the Commissioner of Public Infrastructure of required plans and supplemental information.
- In addition, a City-issued Industrial User Discharge Permit and/or a Sewer Extension/Connection Permit issued by the Commonwealth of Massachusetts D.E.P. shall be required by the City for Industrial Discharge into the sewer system.

Industrial User Discharge Permit No..... Date.....

Comm. Mass. Sewer Conn./Ext. Permit No..... Date.....

A Filing and Inspection Fee of \$ 150 plus an Entrance Fee of \$..... where applicable, must accompany this application.

Bank# Chase Check# 1010 Date 11/13/07 Receipt# 7584

Other requirements: 24 hr inspection 508.9.7.91.5.2.7

Connection made to Sewer Part of jointly-shared private line YES NO
Storm Drain

Applicant agrees to abide by the above terms, as well as all pertinent ordinances of the City of New Bedford, and such other special rules as the Commissioner of Public Infrastructure and/or City Engineer may deem necessary

Quate M. Andrade
Acting City Engineer *mn*


[Signature]
Signature of Property Owner or Representative

INSPECTOR'S REPORT

INSPECTED BY: _____
DATE: _____
COMMENTS: _____

APPROVED _____ DISAPPROVED _____

SIGNATURE

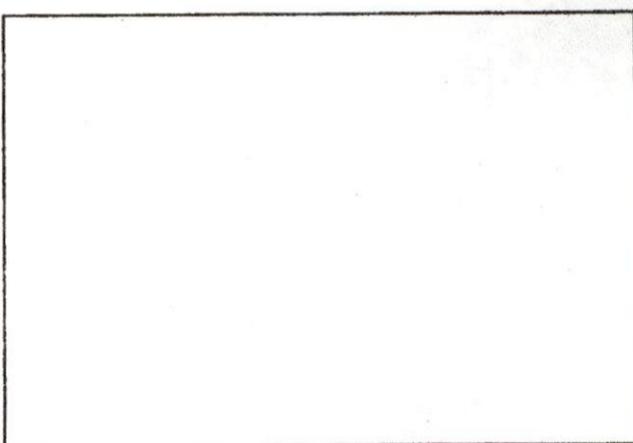

SKETCH PLAN



CITY OF NEW BEDFORD

999

NO. 200407

LICENSE NO. _____

DATE 10/15 2007

FOUNDATION PERMIT

MSBC Sect. 111.8 - Any permit issued shall be deemed abandoned and invalid unless the work authorized by it shall have been commenced within six (6) months after its issuance.

This certifies that Douglas Chaesy, owner/contractor

has permission to install foundation 28x24

on Princeton St. Plot 113, lot 183

providing that the person accepting this permit shall in every respect conform to the terms of the application therefor on file in this office; to the provisions of the Statute of the Commonwealth and to the By-Laws of the City of New Bedford relating to the Inspection, Erection, Enlarging, Altering, Raising, Moving, Repairing or Tearing Down of a Building.

WIRING INSPECTOR

PLUMBING INSPECTOR

BUILDING INSPECTOR

YOUR AREA INSPECTOR IS: Tom Welch

ROUGH FINISH

- Tel. 979-1540 Between 8:00 AM - 9:00 AM

NOTICE: NOTIFY INSPECTOR 48 HOURS
IN ADVANCE OF APPLYING
SHEATING OR LATHING

OCCUPANCY PERMIT REQUIRED BEFORE OCCUPANCY
No Building or Structure shall be used or occupied until the Certificate of Use and Occupancy shall have been issued by the Building Commissioner - MSBC. Sect. 120.1 - N.B. Zoning Ord. Sect. 9-269

THIS CARD MUST BE DISPLAYED IN A CONSPICUOUS PLACE ON THE PREMISES
AND NOT TORN DOWN OR REMOVED UNTIL COMPLETION OF WORK

SUBJECT TO MASSACHUSETTS STATE
BUILDING CODE REQUIREMENTS

[Signature]

BUILDING INSPECTOR

STEVE REZANDES

(508) 659-3148

Re: City of
Princeton
Water line

Princeton

Princeton St.
 Bob Bichel
 Storm drain @ line
 & sewer property line
 Sewer permit
 (a) Water source
 (a)

2 SERVICES

Map for
to first m

Street

Do Not use Address

Put this info in
Requirement Section.

See Area: it need to know more

40	40
RES. B	

40	80	40
RES. B		

40	40	40	40
RES. B			

4032
40

VINGTON

RES. B		RES. B		RES. B		RES. B		RES. B	
80.02	80.02	80.02	120.03	35.01					
73	75	77	79	82					
22.54	22.79	23.04	35.03	10.26					
6136	6205	6273	9539	2795					
80.02	80	80	120	35					
80.00									
126	128	129	130	131	132	134	136	137	138
124	11.36	11.43	11.49	11.55	23.29	21.94	10.64	11.94	12.03
10.00	3094	3111	3128	3145	6342	5973	2897	3250	3274
	40	40	40	40	80	75.00	18.7	40	40
	RES. B								

ST.

RES. B					
37	40.02	40.02	60.03	60.0	
83	84	85	86	87	
1085	11.94	12.03	18.31	18.3	
2954	3250	3274	4983	4983	
36.25	40	40	60	60.0	
136	137	138	139		
10.64	11.94	12.03	24.32		
2897	3250	3274	6620		
18.7	40	40	80		

NCETON

RES. B		RES. B		RES. B		RES. B		RES. B	
40	80	40	40	40	40	40	40	54.48	
180	181	183	184	185	186	187	188		
11.75	23.50	11.75	11.75	11.75	11.75	11.75	16.14		
3200	6400	3200	3200	3200	3200	3200	4394		
40	80	40	40	40	40	40	55.36		
RES. B									

BROOK

RES. B				
55.52	40	40	40	40
191	192	193	194	195
16.18	11.75	11.75	11.75	11.75
4406	3200	3200	3200	3200
54.63	40	40	40	40

109



Inspector

PERMIT NO.

CITY OF NEW BEDFORD
SEWER AND/OR STORM DRAIN PERMIT

DATE 11/13/07

24026

This certifies that permission is granted to

Steven Resendes 41 Spinnaker Way Westport 508.54.3148
Property Owner Address 282 Princeton St. Tel.

To connect a sewer and/or storm drain located at stub at prop line 200' ex. x Birch St.
Assessor's Plot 11.3 Lot 183, to the sewer and/or storm drain in Princeton Street

To be laid in accordance with the conditions in this application and the City of New Bedford ordinances.
TYPE OF USE: RESIDENTIAL COMMERCIAL INDUSTRIAL FLOW 330 G.P.D.

If applicant other than actual property owner, attach Letter of Authorization from Property Owner.
Name Mailing Address
The Bonded Contractor/Drain Layer authorized to perform this work is:
J.S. Lutz, Inc. 12 Ventura Dr. Dartmouth 508.995.3535
Name Address Tel.
Type of Pipe Required: sdr 35 PVC

PERMIT EXPIRES ONE YEAR AFTER DATE OF ISSUE

- Requires separate connections for sewage and storm drain where applicable. Storm water cannot be discharged to a sanitary sewer.
 - All work must be inspected and approved by a D.P.I. inspector before backfilling.
 - If this connection is to be part of a private service shared jointly with other building owners, attach copy of Recorded Joint Maintenance Agreement.
 - Permits can be issued to Industrial and/or Commercial Applicants only upon receipt and approval by the Commissioner of Public Infrastructure of required plans and supplemental information.
 - In addition, a City-issued Industrial User Discharge Permit and/or a Sewer Extension/Connection Permit issued by the Commonwealth of Massachusetts D.E.P. shall be required by the City for Industrial Discharge into the sewer system.
- Industrial User Discharge Permit No. Date

Comm. Mass. Sewer Conn./Ext. Permit No. Date
A Filing and Inspection Fee of \$150.00 plus an Entrance Fee of \$ where applicable, must accompany this application.

Bank# Chase Check# 1010 Date 11/13/07 Receipt# 7584
Other requirements: 24 hr inspection 508.979.1527

Connection made to Sewer Part of jointly-shared private line YES NO
Storm Drain

Applicant agrees to abide by the above terms, as well as all pertinent ordinances of the City of New Bedford, and such other special rules as the Commissioner of Public Infrastructure and/or City Engineer may deem necessary

Dante M. Andrade Acting City Engineer mn
Signature of Property Owner or Representative

INSPECTOR'S REPORT

INSPECTED BY: Bob Bichel
DATE: 11/26 + 11/27
COMMENTS:

Inspection
Monday
November 26, 2007
@ 9:00 A.M.

APPROVED DISAPPROVED
Signature
SIGNATURE

Rec'd 11/28/07


SKETCH PLAN

RAINY 450

11/26/07 Princeton St.

SEWER & DRAIN

(23)

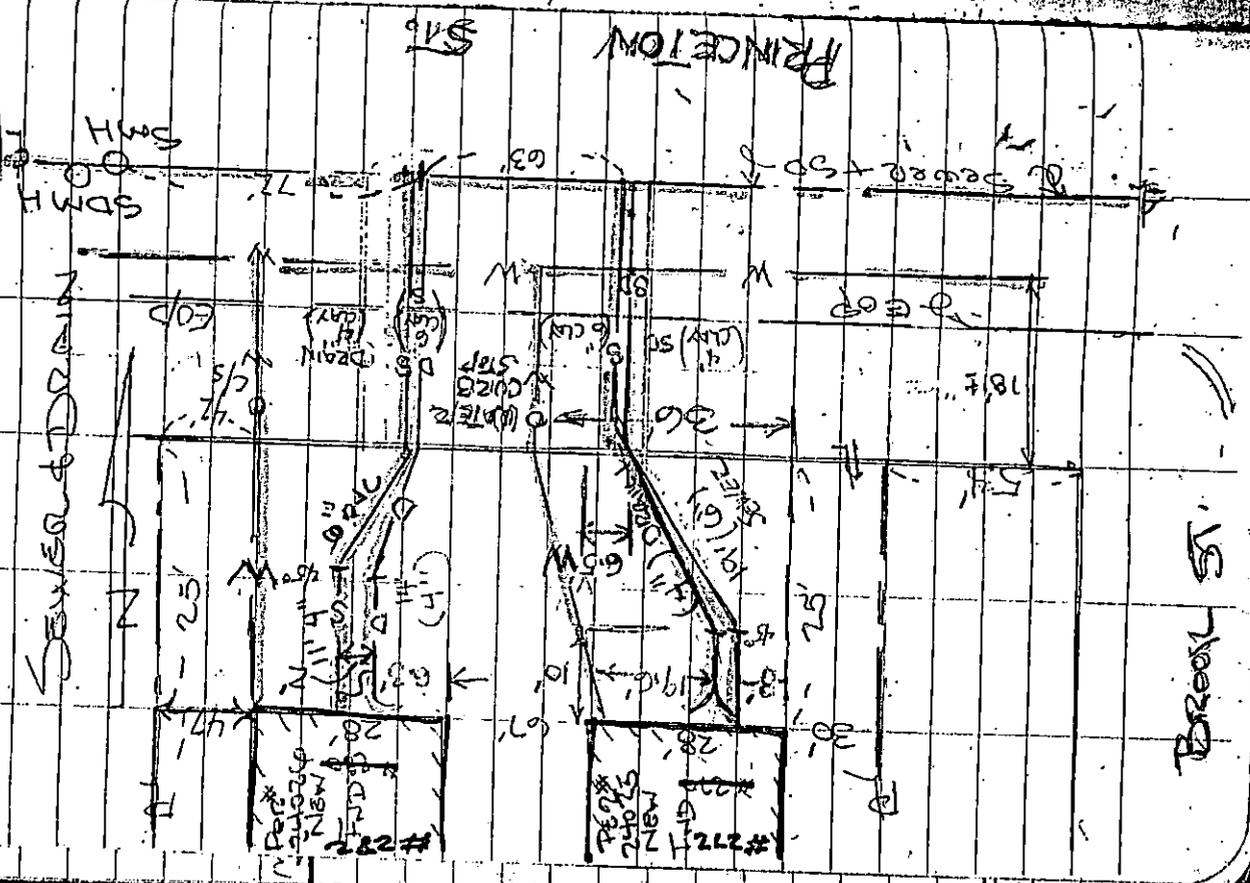

PRINCETON ST.

(46)

CONTRACTOR: J.S. LOVIZI INC.
508-995-3535
DART. MA.

SEWER TIE-INS @ DROPLINE

WATER SERVICES RELAY TO
10' MIN. SEPT. TANK SEWER SERV.

PERMITS* APPROX 1/20/07

PLUMBER DID NEW PIPING
ON PRIVATE PROP. WORKING

NOTE: HP COULD PICK UP NEWER LINE CONCRETE
CUTS STEEL PIPES TOLD WASTEWATER
INSPECTION PERCY REYNOLDS
SAID HE WOULD SCHEDULE TO FINISH
WORK TOMORROW

Rec'd 11/28/07