



PERMIT NO.
24064

CITY OF NEW BEDFORD
SEWER AND/OR STORM DRAIN PERMIT

DATE 7-8-08
Expires 7-8-09

This certifies that permission is granted to

Property Owner Michael Panagakos Address 914 Mt. Pleasant St. New Bedford Tel. 508 998 3911
#905

To connect a sewer and/or storm drain located at

Assessor's Plot 123A Lot 4/15, to the sewer and/or storm drain in 6" Sewer Street 120' S X Jones St.

To be laid in accordance with the conditions in this application and the City of New Bedford ordinances.

TYPE OF USE: RESIDENTIAL RETAIL COMMERCIAL INDUSTRIAL FLOW 105 G.P.D.

If applicant other than actual property owner, attach Letter of Authorization from Property Owner.

Name..... Tel.....

Mailing Address.....

The Bonded Contractor/Drain Layer authorized to perform this work is:

Name S.B. Panagakos Address 21 East River Drive No. Dartmouth, MA 02748 Tel. 508-984-1668
Type of Pipe Required: S.D.R. 35 PVC / catch basins / manhole relocation w/ sh
PVC as per plan

PERMIT EXPIRES ONE YEAR AFTER DATE OF ISSUE

- Requires separate connections for sewage and storm drain where applicable. Storm water cannot be discharged to a sanitary sewer.
 - All work must be inspected and approved by a D.P.I. inspector before backfilling.
 - If this connection is to be part of a private service shared jointly with other building owners, attach copy of Recorded Joint Maintenance Agreement.
 - Permits can be issued to Industrial and/or Commercial Applicants only upon receipt and approval by the Commissioner of Public Infrastructure of required plans and supplemental information.
 - In addition, a City-issued Industrial User Discharge Permit and/or a Sewer Extension/Connection Permit issued by the Commonwealth of Massachusetts D.E.P. shall be required by the City for Industrial Discharge into the sewer system.
- Industrial User Discharge Permit No..... Date.....

Comm. Mass. Sewer Conn./Ext. Permit No..... Date.....
A Filing and Inspection Fee of \$450.00 plus an Entrance Fee of \$..... where applicable, must accompany this application.

Bank# Sovereign Bank Check# 20547 Date 7/9/08 Receipt# 7923

Other requirements: as per approved plans
24 hour notice for inspection @ 508-979-7527

Connection made to Sewer Part of jointly-shared private line YES ☒ NO ☐
Storm Drain

Applicant agrees to abide by the above terms, as well as all pertinent ordinances of the City of New Bedford, and such other special rules as the Commissioner of Public Infrastructure and/or City Engineer may deem necessary

City Engineer

Signature of Property Owner or Representative


INSPECTOR'S REPORT

INSPECTED BY: Bob Bickel
DATE: 8/21/09
COMMENTS:

APPROVED

DISAPPROVED

SIGNATURE

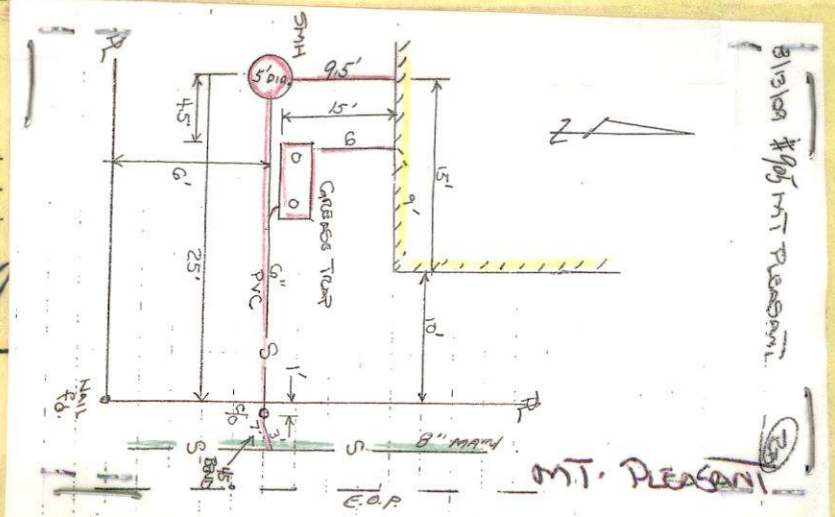



PERMIT NO.
24064

CITY OF NEW BEDFORD
SEWER AND/OR STORM DRAIN PERMIT

DATE 7-8-08
Expires 7-8-09
Ext 8-30-09
Tel. 508 998-3911

This certifies that permission is granted to

Michael Panagakos 914 Mt. Pleasant St. New Bedford
Property Owner Address Tel.

To connect a sewer and/or storm drain located at W.S. Mt. Pleasant St. 120' SX Jones St.
Assessor's Plot 123A Lot 415, to the sewer and/or storm drain in correct sewer into Mt. Pleasant St.
6" Sewer Street

To be laid in accordance with the conditions in this application and the City of New Bedford ordinances.
TYPE OF USE: RESIDENTIAL COMMERCIAL INDUSTRIAL FLOW 105 G.P.D.
RETAIL

If applicant other than actual property owner, attach Letter of Authorization from Property Owner.

Name S.B. Panagakos Mailing Address 21 East River Drive No. Dartmouth, MA 02748
The Bonded Contractor/Drain Layer authorized to perform this work is: 508-984-7668
Name S.B. Panagakos Address 21 East River Drive No. Dartmouth, MA 02748 Tel. 508-984-7668
Type of Pipe Required: SDR 35 PVC / catch basin / manhole relocation with PVC as per plan.

PERMIT EXPIRES ONE YEAR AFTER DATE OF ISSUE

- Requires separate connections for sewage and storm drain where applicable. Storm water cannot be discharged to a sanitary sewer.
- All work must be inspected and approved by a D.P.I. inspector before backfilling.
- If this connection is to be part of a private service shared jointly with other building owners, attach copy of Recorded Joint Maintenance Agreement.
- Permits can be issued to Industrial and/or Commercial Applicants only upon receipt and approval by the Commissioner of Public Infrastructure of required plans and supplemental information.
- In addition, a City-issued Industrial User Discharge Permit and/or a Sewer Extension/Connection Permit issued by the Commonwealth of Massachusetts D.E.P. shall be required by the City for Industrial Discharge into the sewer system.

Industrial User Discharge Permit No. _____ Date _____

Comm. Mass. Sewer Conn./Ext. Permit No. _____ Date _____

A Filing and Inspection Fee of \$450.00 and an Entrance Fee of \$ _____ where applicable, must accompany this application.

Bank# Sovereign Bank Check# 20547 Date 7/9/08 Receipt# 7923

Other requirements: as per approved plans

24 hour notice for inspection @ 508-979-1527

Connection made to Sewer Part of jointly-shared private line YES ☒ NO
Storm Drain

Applicant agrees to abide by the above terms, as well as all pertinent ordinances of the City of New Bedford, and such other special rules as the Commissioner of Public Infrastructure and/or City Engineer may deem necessary

[Signature]
City Engineer


Michael Panagakos
Signature of Property Owner or Representative

INSPECTOR'S REPORT

INSPECTED BY: [Signature]
DATE: 8/12/09
COMMENTS: _____

APPROVED DISAPPROVED

[Signature]
SIGNATURE

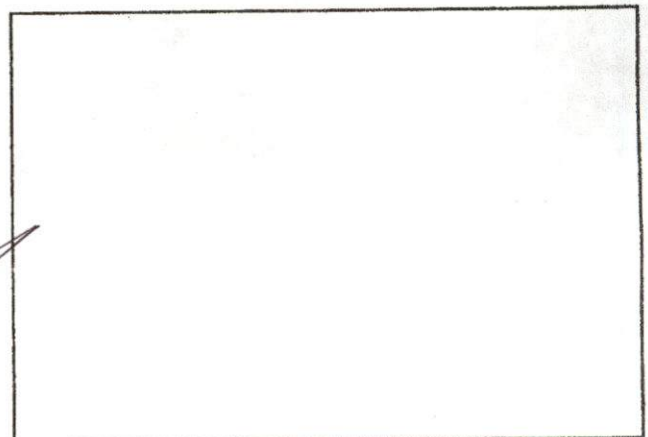

SKETCH PLAN



WORK ORDER

CHECK LEAK

MARK OFF

INSPECTION

POOR PRESSURE

HYDRANT

INVESTIGATE

SHUT-OFF

TURN-ON

DATE: 8/12/09 TIME: _____ FROM: JPLANAGAN

TO: WA WS


LOCATION: 909 MT Pleasant St
for 8/13/09 2pm

COMMENTS: Sewer Report
Inspection

Steve Rezendes - for
John Laxigar:

RESPONSE: What do I need to set
up the meter

DATE: _____ FROM: _____

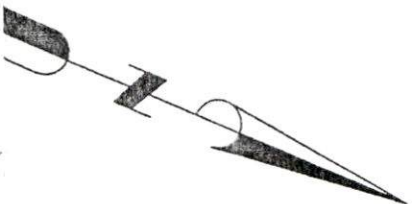

5' RECAST
MANHOLE

SMH #1
RIM=99.80
INV. IN=97.35
INV. OUT=97.25

N/F
DEBORAH KOYMARIANOS
MAP 123A LOT 366

1,000 GALLON
GREASE TRAP
RIM=99.75
INV. IN=97.50
INV. OUT=97.25

RETA
1,300 SQ.
SLAB ELEV.=


FAST FOOD/R
800 SQ. FT.
(NO SEATS)

PROPOSED CB #1
F&G=99.60
INV.=96.95

NEW GAS SERVICE
FERNCO 45° SADDLE

DMH
RIM=99.94
INV. IN=96.
INV. IN=95.
INV. OUT=9

MT. PLEASANT

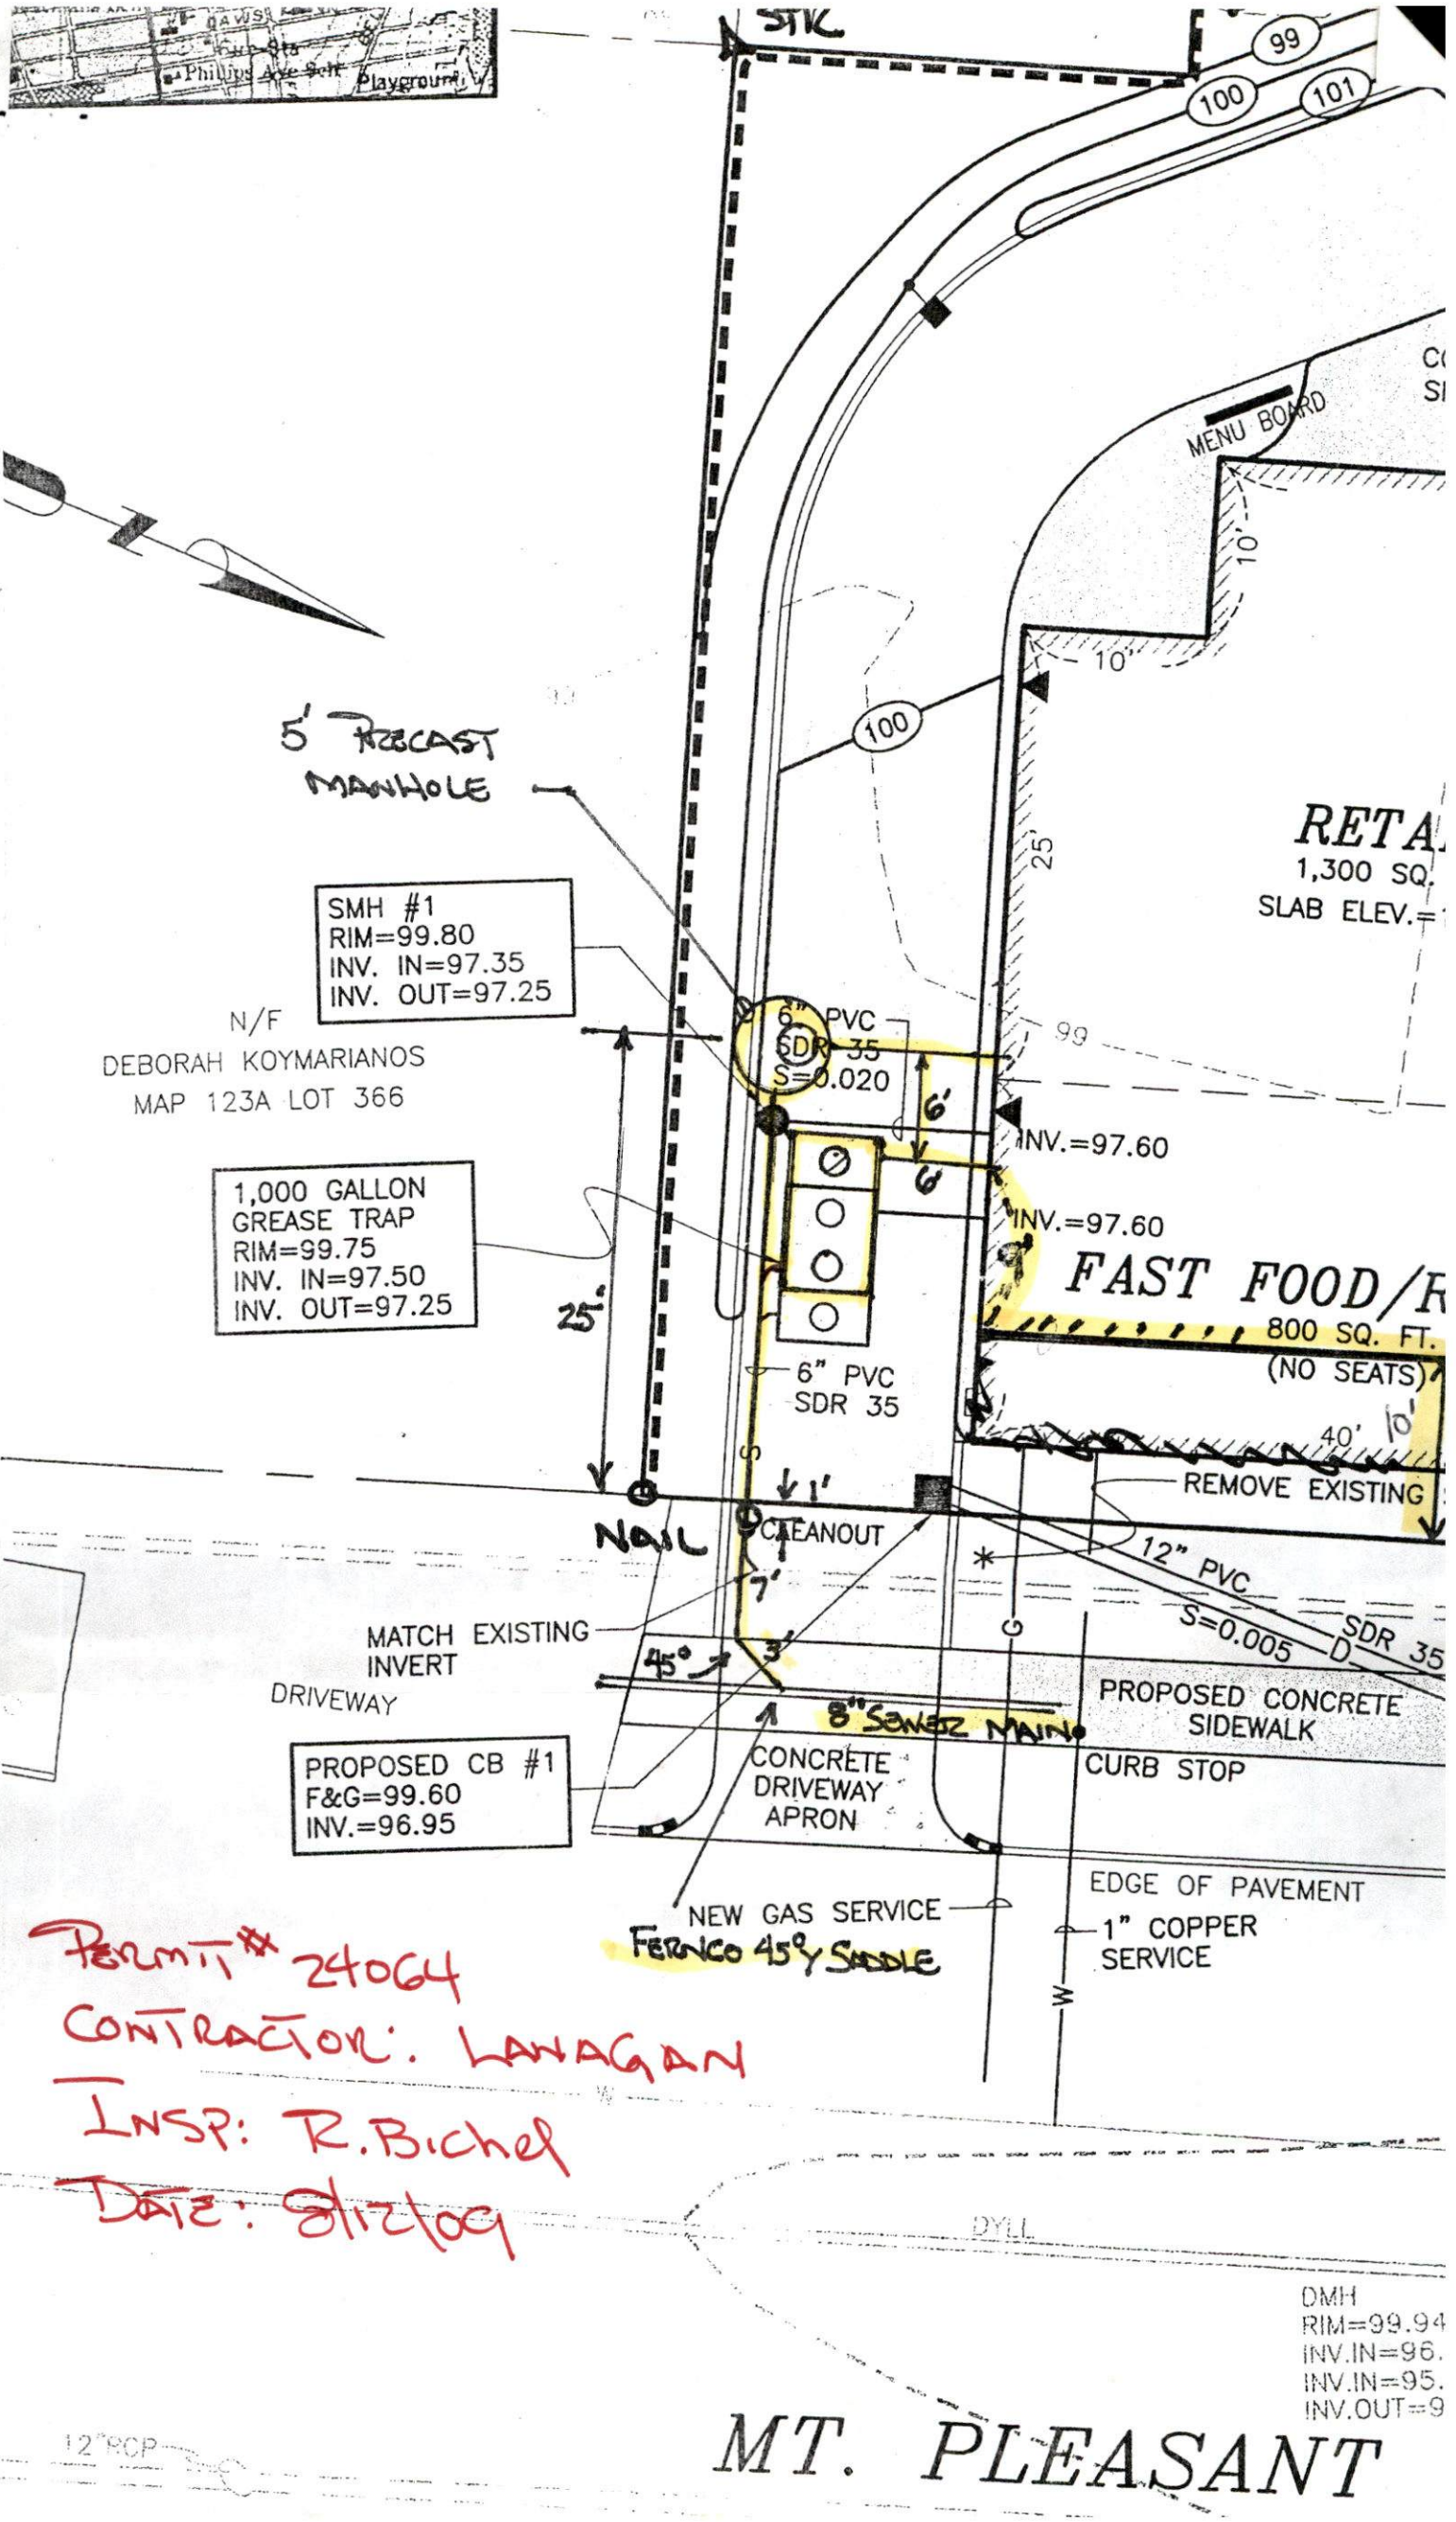


Permit # 24064
CONTRACTOR: LANAGAN
INSP: R. Bichel
DATE: 8/12/09

12" RCP

8/13/09 #905 INT PLEASANT

(25)

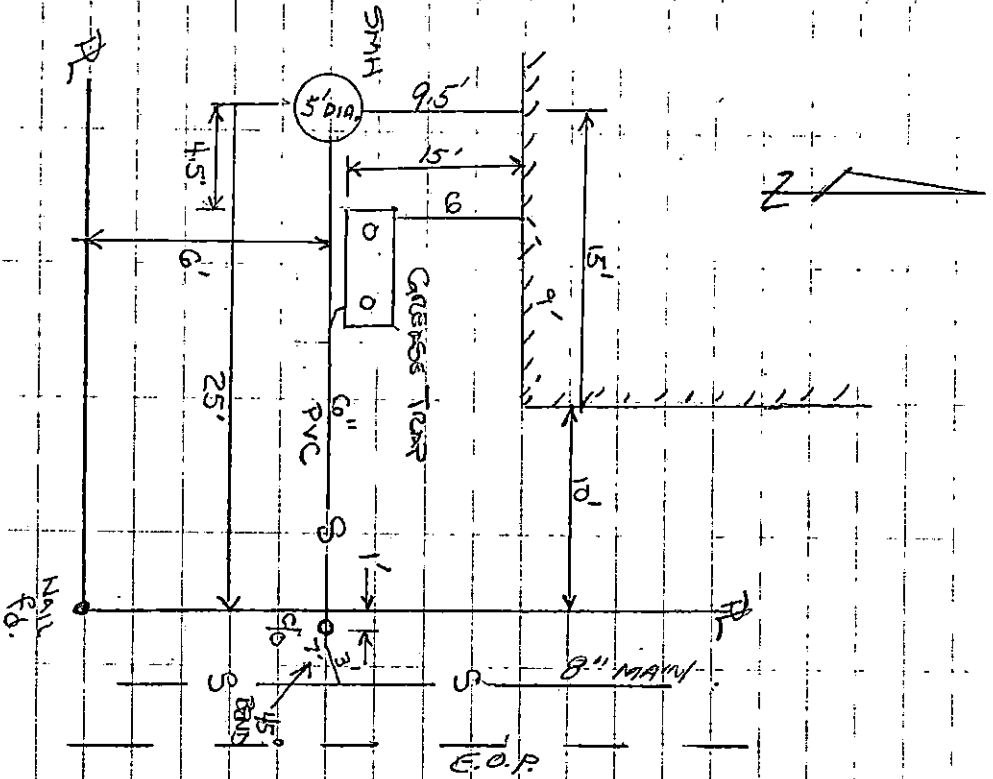

SEWER & GASES TRAP
INSPECTION

DATE: 8/13/09

CONNECTION: JB LAMBERTSON

PERMIT: 24064

PGS 123 & 10145

INSPECTION: R. B. O'NEAL