



PERMIT NO.

24087

CITY OF NEW BEDFORD  
SEWER AND/OR STORM DRAIN PERMITDATE 11/6/08

This certifies that permission is granted to

Bristol Pacific Homes 291 Middle St Fall River 02724  
Property Owner Address Tel.To connect a sewer and/or storm drain located at 122 Apple Tree Lane  
Assessor's Plot 120 Lot 144 to the sewer and/or storm drain in 8" sewer + 12" drain Street

To be laid in accordance with the conditions in this application and the City of New Bedford ordinances.

TYPE OF USE: ☒ RESIDENTIAL ☐ COMMERCIAL ☐ INDUSTRIAL FLOW 330 G.P.D.

If applicant other than actual property owner, attach Letter of Authorization from Property Owner.

Name Mailing Address Tel.

The Bonded Contractor/Drain Layer authorized to perform this work is:

J.B. Lamsagan 21 East River Dr Dartmouth 508 984 1668  
Name Address Tel.  
Type of Pipe Required: adv. 3.5 pvc

## PERMIT EXPIRES ONE YEAR AFTER DATE OF ISSUE

- Requires separate connections for sewage and storm drain where applicable. Storm water cannot be discharged to a sanitary sewer.
- All work must be inspected and approved by a D.P.I. inspector before backfilling.
- If this connection is to be part of a private service shared jointly with other building owners, attach copy of Recorded Joint Maintenance Agreement.
- Permits can be issued to Industrial and/or Commercial Applicants only upon receipt and approval by the Commissioner of Public Infrastructure of required plans and supplemental information.
- In addition, a City-issued Industrial User Discharge Permit and/or a Sewer Extension/Connection Permit issued by the Commonwealth of Massachusetts D.E.P. shall be required by the City for Industrial Discharge into the sewer system.

Industrial User Discharge Permit No. Date

Comm. Mass. Sewer Conn./Ext. Permit No. Date

A Filing and Inspection Fee of \$450.00 plus an Entrance Fee of \$ where applicable, must accompany this application.

Bank# Bank Five Check# 1 516 2 Date 11/6/08 Receipt# 8117Other requirements: 24 hr inspection at 508 979 1527Connection made to Sewer Part of jointly-shared private line YES NO  
Storm Drain

Applicant agrees to abide by the above terms, as well as all pertinent ordinances of the City of New Bedford, and such other special rules as the Commissioner of Public Infrastructure and/or City Engineer may deem necessary.

Dwight M. Anderson  
acting City Engineer[Signature]  
Signature of Property Owner or Representative

## INSPECTOR'S REPORT

INSPECTED BY: SEE SKETCH


DATE:

COMMENTS:

APPROVED

DISAPPE

SIGNATURE

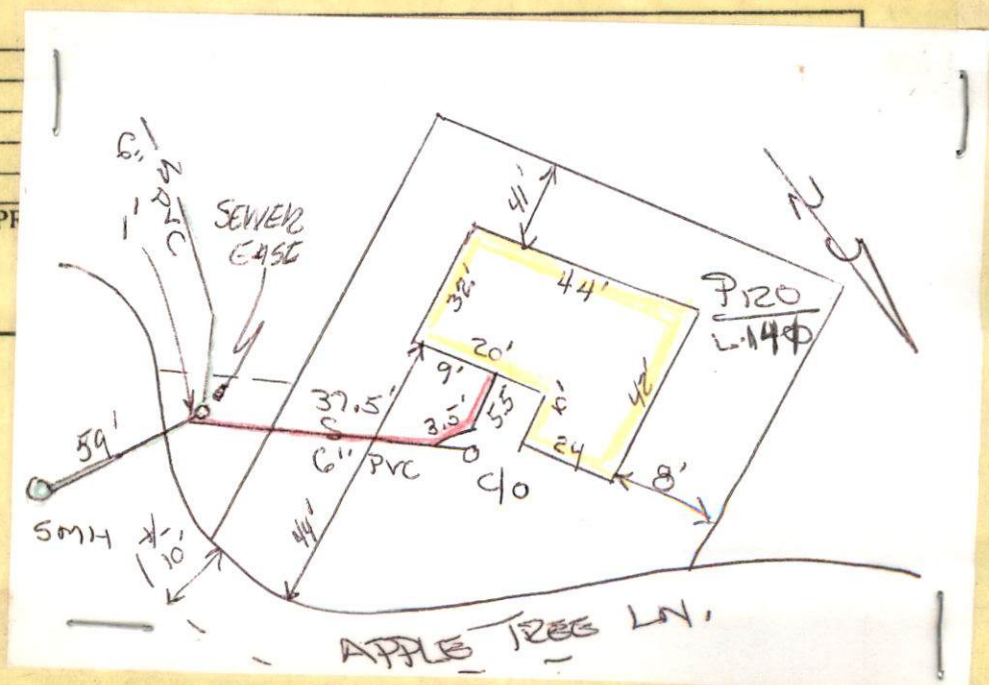





PERMIT NO.  
24087

CITY OF NEW BEDFORD  
SEWER AND/OR STORM DRAIN PERMIT

DATE 11/6/08

This certifies that permission is granted to

Bristol Pacific Homes.....291 Middle St.....Fall River.....02724.....  
Property Owner Address Tel.

To connect a sewer and/or storm drain located at.....122 Apple Tree Lane.....Apple Tree Lane.....  
Assessor's Plot 120.....Lot.....141....., to the sewer and/or storm drain in.....8" sewer + 12" drain.....Street

To be laid in accordance with the conditions in this application and the City of New Bedford ordinances.

TYPE OF USE: ☒ RESIDENTIAL ☐ COMMERCIAL ☐ INDUSTRIAL FLOW 330 G.P.D.

If applicant other than actual property owner, attach Letter of Authorization from Property Owner.

Name.....Tel.....  
Mailing Address.....

The Bonded Contractor/Drain Layer authorized to perform this work is:

J.B. Langan.....21 East River Dr.....Dartmouth.....508.984.1668.....  
Name Address Tel.  
Type of Pipe Required:.....sdr 3.5 pvc.....

PERMIT EXPIRES ONE YEAR AFTER DATE OF ISSUE

- Requires separate connections for sewage and storm drain where applicable. Storm water cannot be discharged to a sanitary sewer.
  - All work must be inspected and approved by a D.P.I. inspector before backfilling.
  - If this connection is to be part of a private service shared jointly with other building owners, attach copy of Recorded Joint Maintenance Agreement.
  - Permits can be issued to Industrial and/or Commercial Applicants only upon receipt and approval by the Commissioner of Public Infrastructure of required plans and supplemental information.
  - In addition, a City-issued Industrial User Discharge Permit and/or a Sewer Extension/Connection Permit issued by the Commonwealth of Massachusetts D.E.P. shall be required by the City for Industrial Discharge into the sewer system.
- Industrial User Discharge Permit No.....Date.....

Comm. Mass. Sewer Conn./Ext. Permit No.....Date.....  
A Filing and Inspection Fee of \$450.00 plus an Entrance Fee of \$..... where applicable, must accompany this application.

Bank# Bank Five Check# 15162 Date 11/6/08 Receipt# 8117

Other requirements:.....24 hr inspection at 508.979.1527.....

Connection made to Sewer Part of jointly-shared private line YES NO  
Storm Drain

Applicant agrees to abide by the above terms, as well as all pertinent ordinances of the City of New Bedford, and such other special rules as the Commissioner of Public Infrastructure and/or City Engineer may deem necessary

Quate M. Andrade.....  
acting City Engineer mn


[Signature].....  
Signature of Property Owner or Representative

INSPECTOR'S REPORT

INSPECTED BY:.....  
DATE:.....  
COMMENTS:.....

APPROVED DISAPPROVED

SIGNATURE

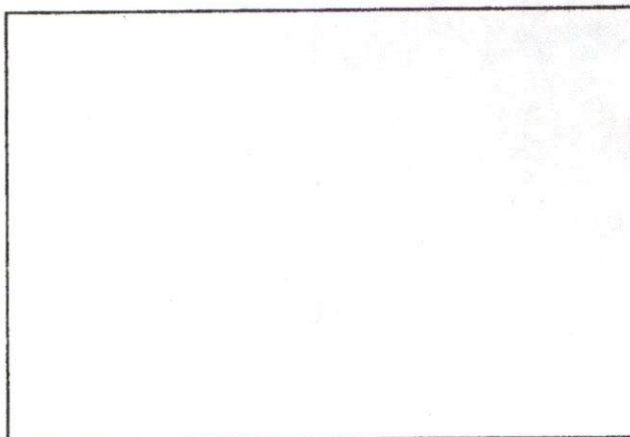

SKETCH PLAN



# CITY OF NEW BEDFORD

1041

NO. 161908

LICENSE NO. \_\_\_\_\_

DATE 9/17 2008

## FOUNDATION PERMIT

MSBC Sect. 111.8 – Any permit issued shall be deemed abandoned and invalid unless the work authorized by it shall have been commenced within six (6) months after its issuance.

This certifies that Bristol Pacific Homes, owner/contractor  
has permission to Install Foundation  
on 100 Apple Tree Lane

providing that the person accepting this permit shall in every respect conform to the terms of the application therefor on file in this office; to the provisions of the Statute of the Commonwealth and to the By-Laws of the City of New Bedford relating to the Inspection, Erection, Enlarging, Altering, Raising, Moving, Repairing or Tearing Down of a Building.

WIRING INSPECTOR

PLUMBING INSPECTOR

BUILDING INSPECTOR

\_\_\_\_\_  
\_\_\_\_\_\_\_\_\_\_  
\_\_\_\_\_\_\_\_\_\_  
\_\_\_\_\_

ROUGH FINISH

YOUR AREA INSPECTOR IS: THOMAS WELCH

- Tel. 979-1540 Between 8:00 AM – 9:00 AM

NOTICE: NOTIFY INSPECTOR 48 HOURS  
IN ADVANCE OF APPLYING  
SHEATING OR LATHING

### OCCUPANCY PERMIT REQUIRED BEFORE OCCUPANCY

No Building or Structure shall be used or occupied until the Certificate of Use and Occupancy shall have been issued by the Building Commissioner – MSBC. Sect. 120.1 – N.B. Zoning Ord. Sect. 9-269

THIS CARD MUST BE DISPLAYED IN A CONSPICUOUS PLACE ON THE PREMISES  
AND NOT TORN DOWN OR REMOVED UNTIL COMPLETION OF WORK

SUBJECT TO MASSACHUSETTS STATE  
BUILDING CODE REQUIREMENTS

Danny D. Romanowski  
BUILDING INSPECTOR



12/8/08 (RP)

SEWER TIE-IN

CONTINUATION - LANDSCAPE

Plot 120 LOT 140

Highway

ROAD

APPLE TREE LN.

