



PERMIT NO.

24094

CITY OF NEW BEDFORD  
SEWER AND/OR STORM DRAIN PERMIT

DATE 11/21/08

This certifies that permission is granted to

Mark White /  
Pope's Island Harbor Development Corp. 867 Middle Rd. Acushnet 508-763-8868  
Property Owner Address Tel.To connect a sewer and/or storm drain located at crosses etc 6 to City's pump station near  
Assessor's Plot 60 Lot 12, to the sewer and/or storm drain in Pope's Marina Street

To be laid in accordance with the conditions in this application and the City of New Bedford ordinances.

TYPE OF USE: RESIDENTIAL ☒ COMMERCIAL INDUSTRIAL FLOW G.P.D.

If applicant other than actual property owner, attach Letter of Authorization from Property Owner.

Name Brian Camacho (employee) Tel. 508-763-8868

Mailing Address 867 Middle Rd. Acushnet MA

The Bonded Contractor/Drain Layer authorized to perform this work is:

D.W. White Construction Corp. 867 Middle Rd. Acushnet

Name Address Tel.

Type of Pipe Required: schedule 21 pvc 3" 508-763-8868

## PERMIT EXPIRES ONE YEAR AFTER DATE OF ISSUE Force Main Sewer Ext.

- Requires separate connections for sewage and storm drain where applicable. Storm water cannot be discharged to a sanitary sewer.
- All work must be inspected and approved by a D.P.I. inspector before backfilling.
- If this connection is to be part of a private service shared jointly with other building owners, attach copy of Recorded Joint Maintenance Agreement.
- Permits can be issued to Industrial and/or Commercial Applicants only upon receipt and approval by the Commissioner of Public Infrastructure of required plans and supplemental information.
- In addition, a City-issued Industrial User Discharge Permit and/or a Sewer Extension/Connection Permit issued by the Commonwealth of Massachusetts D.E.P. shall be required by the City for Industrial Discharge into the sewer system.

Industrial User Discharge Permit No. Date

Comm. Mass. Sewer Conn./Ext. Permit No. Date

A Filing and Inspection Fee of \$400, plus an Entrance Fee of \$100, where applicable, must accompany this application.

Bank# Check# Date Receipt#

Other requirements: 24 hr inspection at 508-979-1527

Connection made to Sewer Part of jointly-shared private line YES NO  
Storm Drain

Applicant agrees to abide by the above terms, as well as all pertinent ordinances of the City of New Bedford, and such other special rules as the Commissioner of Public Infrastructure and/or City Engineer may deem necessary

Acting City Engineer

Signature of Property Owner or Representative

## INSPECTOR'S REPORT

INSPECTED BY:


DATE:

COMMENTS:

APPROVED

DI

SIGNATURE

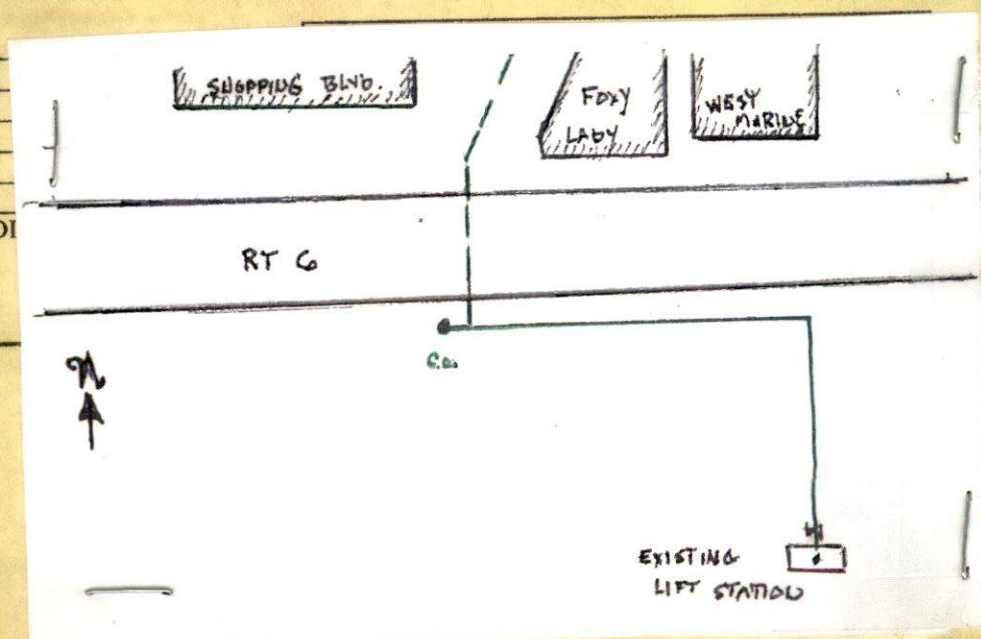





PERMIT NO.  
24094-EXT

CITY OF NEW BEDFORD  
SEWER AND/OR STORM DRAIN PERMIT

DATE 11/21/08

This certifies that permission is granted to

Mark White /  
Pope's Island Harbor Development Corp. 867 Middle Rd. Acushnet 508-763-8868  
Property Owner Address Tel.

To connect a sewer and/or storm drain located at crosses etc. to City's pump station near  
Assessor's Plot 60 Lot 12 Marina, to the sewer and/or storm drain in Pope's Island Street

To be laid in accordance with the conditions in this application and the City of New Bedford ordinances.

TYPE OF USE: RESIDENTIAL ☒ COMMERCIAL ☐ INDUSTRIAL ☐ FLOW \_\_\_\_\_ G.P.D.

If applicant other than actual property owner, attach Letter of Authorization from Property Owner.

Name Brian Camacho (employee) Tel. 508-763-8868

Mailing Address 867 Middle Rd. Acushnet MA

The Bonded Contractor/Drain Layer authorized to perform this work is:

D.W. White Construction Corp. 867 Middle Rd. Acushnet

Name Address Tel.

Type of Pipe Required: schedule 21 pvc 2" 508-763-8868

PERMIT EXPIRES ONE YEAR AFTER DATE OF ISSUE

Force Main Sewer Ext.

- Requires separate connections for sewage and storm drain where applicable. Storm water cannot be discharged to a sanitary sewer.
- All work must be inspected and approved by a D.P.I. inspector before backfilling.
- If this connection is to be part of a private service shared jointly with other building owners, attach copy of Recorded Joint Maintenance Agreement.
- Permits can be issued to Industrial and/or Commercial Applicants only upon receipt and approval by the Commissioner of Public Infrastructure of required plans and supplemental information.
- In addition, a City-issued Industrial User Discharge Permit and/or a Sewer Extension/Connection Permit issued by the Commonwealth of Massachusetts D.E.P. shall be required by the City for Industrial Discharge into the sewer system.

Industrial User Discharge Permit No. \_\_\_\_\_ Date \_\_\_\_\_

Comm. Mass. Sewer Conn./Ext. Permit No. \_\_\_\_\_ Date \_\_\_\_\_

A Filing and Inspection Fee of \$400.00, plus an Entrance Fee of \$200.00, where applicable, must accompany this application.

Bank# \_\_\_\_\_ Check# \_\_\_\_\_ Date \_\_\_\_\_ Receipt# \_\_\_\_\_

Other requirements: 24 hr inspection at 508-279-1527

Connection made to Sewer Part of jointly-shared private line YES NO  
Storm Drain

Applicant agrees to abide by the above terms, as well as all pertinent ordinances of the City of New Bedford, and such other special rules as the Commissioner of Public Infrastructure and/or City Engineer may deem necessary

Acting City Engineer

Signature of Property Owner or Representative

INSPECTOR'S REPORT

INSPECTED BY: \_\_\_\_\_

DATE: \_\_\_\_\_

COMMENTS: \_\_\_\_\_

APPROVED

DISAPPROVED

SIGNATURE

SKETCH PLAN





# CITY OF NEW BEDFORD MASSACHUSETTS

D.P.I. -Engineering Division

1105 Shawmut Ave.

New Bedford, Ma. 02746

Tel: 508-991-6150

Fax: 508-961-3054

Ronald Labelle  
Commissioner

Duarte M. Andrade,  
Acting City Engineer

## To Whom It May Concern:

I Mark White 867 Middle Rd. Acushnet, being  
(Name) (Mailing Address)

Owner of property located at Pope's Island

Plot 60, Lot 12, hereby agree to allow Brian Camacho  
(Name)

867 Middle Rd. Acushnet, to act on my behalf including affixing my  
(Mailing Address)

signature in securing permit for:

☒ Sewer/Drain Service Permits  
☐ Water Service Permits  
☐ Driveway Installation Permits  
☐ Sidewalk Installation Permits

I further agree to conform to, and abide by, All City rules and ask regulations applicable to the permit (s) being applied for:

Name

Signature

867 Middle Rd. Acushnet  
Address

11/24/08  
Date

508763-8868  
Telephone number

For Pope's Island Harbor Development Corp.

## Mary T. Neves

---

**From:** Sarah Porter  
**Sent:** Friday, November 21, 2008 4:29 PM  
**To:** Mary T. Neves  
**Subject:** RE: sewer permit 24094

yes,  
go ahead thank you Mary  
Sarah

-----Original Message-----

**From:** Mary T. Neves  
**Sent:** Friday, November 21, 2008 2:08 PM  
**To:** Sarah Porter  
**Subject:** sewer permit 24094

The owner (Popes Island Harbor Development Corp.) of plot 60 lot 12 which is on Pope's Island, has applied to install a force main and connect to the pump station near the marina.

The owner filed a notice of intent already.

May we issue the sewer permit?

Thanks for your help.

Mary





PERMIT NO.  
24094

PERMIT TO INSTALL FORCE MAIN TO  
PUMP STATION  
CITY OF NEW BEDFORD  
SEWER AND/OR STORM DRAIN PERMIT  
DATE 11/21/08

This certifies that permission is granted to

Mark White / 508-  
Pope's Island Harbor Development Corp. 867 Middle Rd. Acushnet 763-8868  
Property Owner Address Tel.

To connect a sewer and/or storm drain located at crosses etc 6 to City's pump station near  
Assessor's Plot 60 Lot 12 Marina to the sewer and/or storm drain in Pope's Island Street

To be laid in accordance with the conditions in this application and the City of New Bedford ordinances.

TYPE OF USE: RESIDENTIAL ☒ COMMERCIAL INDUSTRIAL FLOW G.P.D.

If applicant other than actual property owner, attach Letter of Authorization from Property Owner.

Name Brian Camacho (employee) Tel. 508-763-8868  
Mailing Address 867 Middle Rd Acushnet MA

The Bonded Contractor/Drain Layer authorized to perform this work is:  
D.W. White Construction Corp. 867 Middle Rd Acushnet  
Name Address Tel.  
Type of Pipe Required: schedule 21 pvc 2" 508-763-8868

PERMIT EXPIRES ONE YEAR AFTER DATE OF ISSUE

Force Main Sewer Ext.

- Requires separate connections for sewage and storm drain where applicable. Storm water cannot be discharged to a sanitary sewer.
  - All work must be inspected and approved by a D.P.I. inspector before backfilling.
  - If this connection is to be part of a private service shared jointly with other building owners, attach copy of Recorded Joint Maintenance Agreement.
  - Permits can be issued to Industrial and/or Commercial Applicants only upon receipt and approval by the Commissioner of Public Infrastructure of required plans and supplemental information.
  - In addition, a City-issued Industrial User Discharge Permit and/or a Sewer Extension/Connection Permit issued by the Commonwealth of Massachusetts D.E.P. shall be required by the City for Industrial Discharge into the sewer system.
- Industrial User Discharge Permit No. Date

Comm. Mass. Sewer Conn./Ext. Permit No. Date  
A Filing and Inspection Fee of \$400, plus an Entrance Fee of \$100, where applicable, must accompany this application.

Bank# Check# Date Receipt#

Other requirements: 24 hr inspection at 508-279-1527

Connection made to Sewer Part of jointly-shared private line YES NO  
Storm Drain

Applicant agrees to abide by the above terms, as well as all pertinent ordinances of the City of New Bedford, and such other special rules as the Commissioner of Public Infrastructure and/or City Engineer may deem necessary

Acting City Engineer


Signature of Property Owner or Representative

INSPECTOR'S REPORT

INSPECTED BY:  
DATE:  
COMMENTS:

APPROVED DISAPPROVED

SIGNATURE

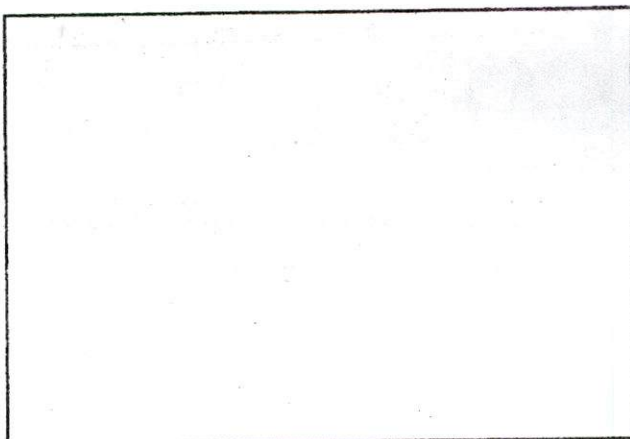

SKETCH PLAN