



PERMIT NO.

24095

CITY OF NEW BEDFORD
SEWER AND/OR STORM DRAIN PERMIT

DATE 11/24/08

This certifies that permission is granted to

Aubrey Connors } c/o Linear Retail (Property) New Bedford
Joe L. Kadis } 35 Burlington Woods Dr. Burlington MA 01803
Property Owner Address Tel.

To connect a sewer and/or storm drain located at 160 W. Rodney Fr Blvd on David St.

Assessor's Plot 13 Lot 1216 to the sewer and/or storm drain in David St. (1.0") Street

To be laid in accordance with the conditions in this application and the City of New Bedford ordinances.

TYPE OF USE: RESIDENTIAL ☒ COMMERCIAL INDUSTRIAL FLOW G.P.D.

If applicant other than actual property owner, attach Letter of Authorization from Property Owner.

Name R. J. Canessa Tel. 508 998 3404

Mailing Address P.O. Box 51643 NB

The Bonded Contractor/Drain Layer authorized to perform this work is:

R. J. Canessa, Etc. P.O. Box 51643 NB 508 998 3404

Name Address Tel.

Type of Pipe Required: SDR 35 PVC

PERMIT EXPIRES ONE YEAR AFTER DATE OF ISSUE

- Requires separate connections for sewage and storm drain where applicable. Storm water cannot be discharged to a sanitary sewer.
- All work must be inspected and approved by a D.P.I. inspector before backfilling.
- If this connection is to be part of a private service shared jointly with other building owners, attach copy of Recorded Joint Maintenance Agreement.
- Permits can be issued to Industrial and/or Commercial Applicants only upon receipt and approval by the Commissioner of Public Infrastructure of required plans and supplemental information.
- In addition, a City-issued Industrial User Discharge Permit and/or a Sewer Extension/Connection Permit issued by the Commonwealth of Massachusetts D.E.P. shall be required by the City for Industrial Discharge into the sewer system.

Industrial User Discharge Permit No. Date

Comm. Mass. Sewer Conn./Ext. Permit No. Date

A Filing and Inspection Fee of \$150.00 plus an Entrance Fee of \$ where applicable, must accompany this application.

Bank# Bank of Fall River Check# 5234 Date 11/24/08 Receipt# 8144

Other requirements: 24 hr inspection at 508 979 1527

Connection made to Sewer Part of jointly-shared private line YES NO
Storm Drain

Applicant agrees to abide by the above terms, as well as all pertinent ordinances of the City of New Bedford, and such other special rules as the Commissioner of Public Infrastructure and/or City Engineer may deem necessary

Quint M. Andrade
Acting City Engineer mn

Robert J. Canessa
Signature of Property Owner or Representative


INSPECTOR'S REPORT

INSPECTED BY: [Signature]
DATE: 7/1/09
COMMENTS:

APPROVED

DISAPPROVED

SIGNATURE

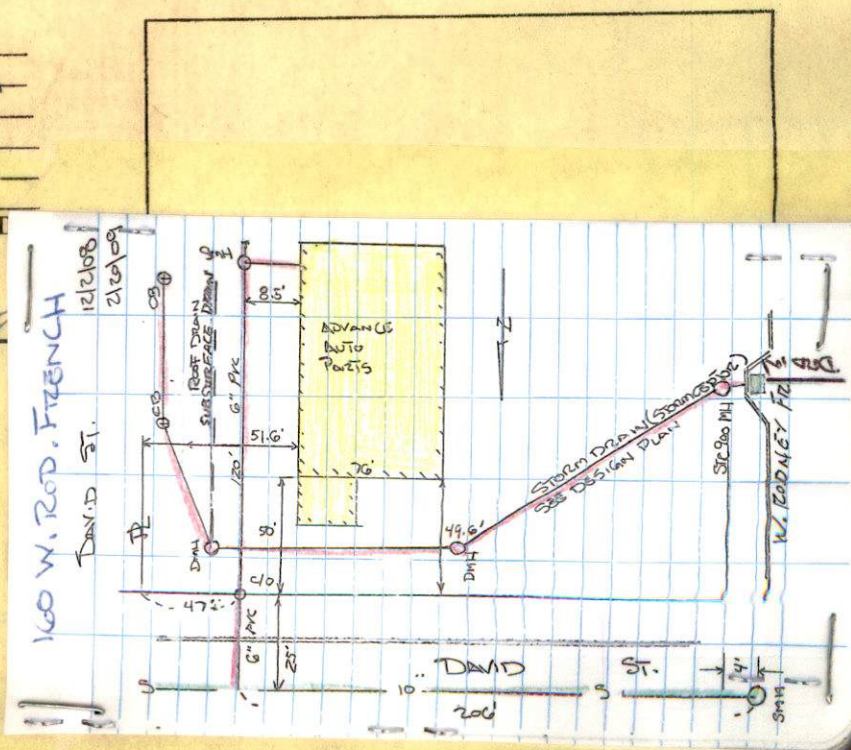



Inspector's Copy

11 AM Fri. 2/20/09

PERMIT NO.

24095

CITY OF NEW BEDFORD
SEWER AND/OR STORM DRAIN PERMIT

DATE 11/24/08

This certifies that permission is granted to
Aubrey Connors } c/o Linear Retail (Property) New Bedford
Joel Kadis } S. Burlington Woods Dr. Burlington MA 01803
Property Owner Address Tel.

To connect a sewer and/or storm drain located at 160 W. Rodney Fr Blvd on David St.

Assessor's Plot 13 Lot 126 to the sewer and/or storm drain in David St. (10") Street

To be laid in accordance with the conditions in this application and the City of New Bedford ordinances.

TYPE OF USE: RESIDENTIAL ☒ COMMERCIAL INDUSTRIAL FLOW G.P.D.

If applicant other than actual property owner, attach Letter of Authorization from Property Owner.

Name R. J. Canessa Tel. 508 998 3404

Mailing Address P.O. Box 51643 NB

The Bonded Contractor/Drain Layer authorized to perform this work is:

R. J. Canessa, Exc. P.O. Box 51643 NB 508 998 3404

Name Address Tel.

Type of Pipe Required: SDR 35 PVC

PERMIT EXPIRES ONE YEAR AFTER DATE OF ISSUE

- Requires separate connections for sewage and storm drain where applicable. Storm water cannot be discharged to a sanitary sewer.
- All work must be inspected and approved by a D.P.I. inspector before backfilling.
- If this connection is to be part of a private service shared jointly with other building owners, attach copy of Recorded Joint Maintenance Agreement.
- Permits can be issued to Industrial and/or Commercial Applicants only upon receipt and approval by the Commissioner of Public Infrastructure of required plans and supplemental information.
- In addition, a City-issued Industrial User Discharge Permit and/or a Sewer Extension/Connection Permit issued by the Commonwealth of Massachusetts D.E.P. shall be required by the City for Industrial Discharge into the sewer system.

Industrial User Discharge Permit No. Date.

Comm. Mass. Sewer Conn./Ext. Permit No. Date.

A Filing and Inspection Fee of \$450.00 plus an Entrance Fee of \$ where applicable, must accompany this application.

Bank# Bank of Fall River Check# 5234 Date 11/24/08 Receipt# 8144

Other requirements: 24 hr. inspection at 508 979 1527

Connection made to Sewer Part of jointly-shared private line YES NO
Storm Drain

Applicant agrees to abide by the above terms, as well as all pertinent ordinances of the City of New Bedford, and such other special rules as the Commissioner of Public Infrastructure and/or City Engineer may deem necessary

Quarte M. Andrade Jr.
Acting City Engineer mn

Robert J. Canessa
Signature of Property Owner or Representative


INSPECTOR'S REPORT

INSPECTED BY: [Signature]
DATE: 7/1/09
COMMENTS:

APPROVED

DISAPPROVED

SIGNATURE

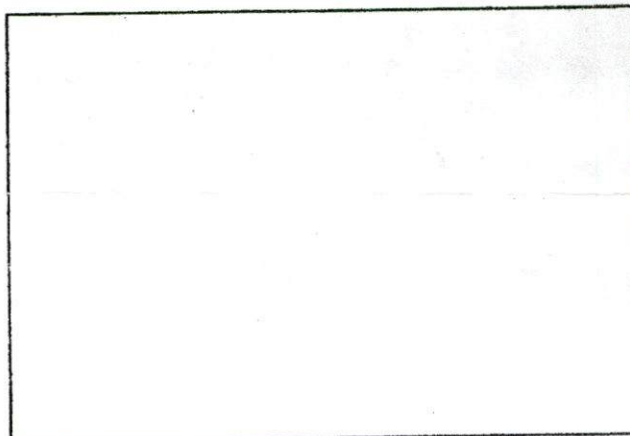

SKETCH PLAN

Rec'd 1/25/2010.



PERMIT NO.

24095

CITY OF NEW BEDFORD
SEWER AND/OR STORM DRAIN PERMIT

DATE 11/24/08

This certifies that permission is granted to

Aubrey Connors } c/o Linear Retail (Property) New Bedford
Joel Kadis } 5 Burlington Woods Dr Burlington MA 01803
Property Owner Address Tel.

To connect a sewer and/or storm drain located at 160 W. Rodney Fr Blvd on David St.

Assessor's Plot 13 Lot 126, to the sewer and/or storm drain in David St. (10") Street

To be laid in accordance with the conditions in this application and the City of New Bedford ordinances.

TYPE OF USE: RESIDENTIAL ☒ COMMERCIAL INDUSTRIAL FLOW _____ G.P.D.

If applicant other than actual property owner, attach Letter of Authorization from Property Owner.

Name R. J. Canessa Tel. 508 998 3404

Mailing Address P.O. Box 51643 NB

The Bonded Contractor/Drain Layer authorized to perform this work is:

R. J. Canessa, Inc. P.O. Box 51643 NB 508 998 3404

Name Address Tel.

Type of Pipe Required: SDR 35 PVC

PERMIT EXPIRES ONE YEAR AFTER DATE OF ISSUE

- Requires separate connections for sewage and storm drain where applicable. Storm water cannot be discharged to a sanitary sewer.
- All work must be inspected and approved by a D.P.I. inspector before backfilling.
- If this connection is to be part of a private service shared jointly with other building owners, attach copy of Recorded Joint Maintenance Agreement.
- Permits can be issued to Industrial and/or Commercial Applicants only upon receipt and approval by the Commissioner of Public Infrastructure of required plans and supplemental information.
- In addition, a City-issued Industrial User Discharge Permit and/or a Sewer Extension/Connection Permit issued by the Commonwealth of Massachusetts D.E.P. shall be required by the City for Industrial Discharge into the sewer system.

Industrial User Discharge Permit No. _____ Date _____

Comm. Mass. Sewer Conn./Ext. Permit No. _____ Date _____

A Filing and Inspection Fee of \$450.00 plus an Entrance Fee of \$ _____ where applicable, must accompany this application.

Bank# Bank of Fall River Check# 5234 Date 11/24/08 Receipt# 8144

Other requirements: 24 hr inspection at 508 979 1527

Connection made to Sewer Part of jointly-shared private line YES NO
Storm Drain

Applicant agrees to abide by the above terms, as well as all pertinent ordinances of the City of New Bedford, and such other special rules as the Commissioner of Public Infrastructure and/or City Engineer may deem necessary

Quate M. Andrade
Acting City Engineer mn

Robert J. Canessa
Signature of Property Owner or Representative

INSPECTOR'S REPORT

INSPECTED BY: _____


DATE: _____

COMMENTS: _____

APPROVED

DISAPPROVED

SIGNATURE

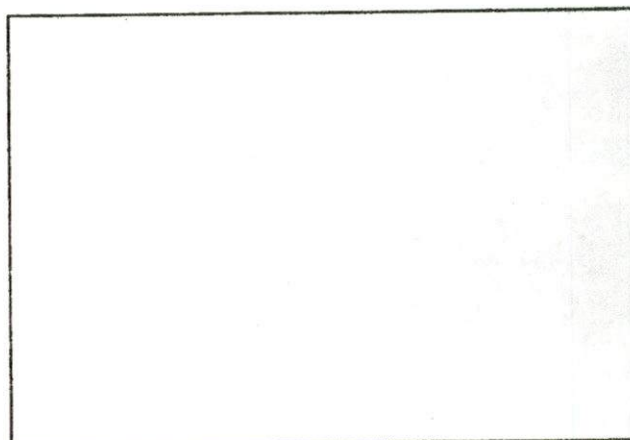

SKETCH PLAN



CITY OF NEW BEDFORD MASSACHUSETTS

D.P.I. -Engineering Division

1105 Shawmut Ave.

New Bedford, Ma. 02746

Tel: 508-991-6150

Fax: 508-961-3054

Ronald Labelle
Commissioner

Duarte M. Andrade,
Acting City Engineer

Received

NOV 21 2008

Department of
Public Infrastructure

To Whom It May Concern:

Linear Retail New Bedford #1 CC
C/O Linear Retail Properties, LLC
5 Burlington Woods Drive
Burlington, MA 01803
being
1 Aubrey Cannuscio, (Name) (Mailing Address)

Owner of property located at 160 West Rodney French Blvd

Plot 13, Lot 126, hereby agree to allow Paul Cordeiro
(Name)

Allan & Major Associates, Inc.

40 North Main St. Middlebury, MA 02346, to act on my behalf including affixing my
a: 508-923-1010 (Mailing Address)

a: 508-557-5222

signature in securing permit for:

- ☒ Sewer/Drain Service Permits
- ☒ Water Service Permits
- ☒ Driveway Installation Permits
- ☒ Sidewalk Installation Permits

I further agree to conform to, and abide by, All City rules and ask regulations applicable to the permit (s) being applied for;

Name

Aubrey Cannuscio
Signature

5 Burlington Woods Drive, Burlington, MA
Address

8/12/08
Date

781-273-5665
Telephone number

018



CITY OF NEW BEDFORD MASSACHUSETTS

D.P.I. -Engineering Division

1105 Shawmut Ave.

New Bedford, Ma. 02746

Tel: 508-991-6150

Fax: 508-961-3054

Ronald Labelle
Commissioner

Duarte M. Andrade,
Acting City Engineer

Received

NOV 21 2008

Department of
Public Infrastructure

To Whom It May Concern:

I Joel Kadis Linear Retail New Bedford #1
(Name) (Mailing Address) 5 Burlington Woods Drive
Burlington, MA 01803, being

Owner of property located at 160 West Rodney French Blvd

Plot 13, Lot 126, hereby agree to allow R. J. CANASA EXCAVATING
(Name) C: 508-916-1144

(Mailing Address) , to act on my behalf including affixing my

signature in securing permit for:

- ☒ Sewer/Drain Service Permits
- ☒ Water Service Permits
- ☒ Driveway Installation Permits
- ☒ Sidewalk Installation Permits

I further agree to conform to, and abide by, All City rules and ask regulations applicable to the permit (s) being applied for:

Name

RLC
Signature

Address

11/20/08
Date

Telephone number

Received

NOV 25 2008

Department of
Public Infrastructure

R.J. Canessa Excavation
P.O. Box 51643
New Bedford Mass 02745
Telephone 508 998-3404

November 25, 2008

Ron Labelle
DPI Commissioner


R.J. Canessa excavating requests permission to install water and sewer connection on David Street on December 1, 2008 with weather and holiday we are not able to get work done before the regular season ends.

Thank You
Robert J. Canessa

If you have any question my cell is 508-916-1144

PERMIT CONDITIONS:

- 1) USE FLOWABLE FILL
- 2) PATCHING OF TRENCHES MUST BE DONE AS SOON AS FLOWABLE FILL IS SET
- 3) USE OF STEEL PLATES (NO LONGER THAN 48 HRS) PROPERLY SECURE WITH ~~WEDGES~~ ^{WEDGES} OR PINS
- 4) IN CASE OF SNOW FORECAST PLATES MUST BE REMOVED AND TRENCH PATCHED

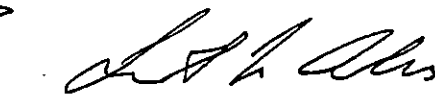
DPI ACTING CITY ENGINEER

476-08

APPLICATION / AGREEMENT

For Permit to Disturb the Surface of a Street in the City of New Bedford

New Bedford 11-258
Sketch Plan

TO THE MAYOR AND CITY COUNCIL

Permission is hereby requested to disturb the surface of

David St. / W. Rodney French Blvd

substantially as per plan annexed, for the purpose of

Sewer & water

13/12/06 24095 3 34 99 33.500

Work will begin (weather permitting) 12/1/08

Work will end (weather permitting) 12/8/08

from and after date of permit.

SEE ATTACHED CONDITIONS

The applicant hereby specifically acknowledges and agrees that this permit, if granted, becomes a legally binding AGREEMENT between said applicant and the City of New Bedford for permission to disturb the surface of City sidewalks and roadways, and as such is subject to all of the terms and conditions, including current bonding and surety deposit requirements, of the various sections of Chapter 22 of the Code of Ordinances of the City of New Bedford, all of which are incorporated herein and made a part of this APPLICATION/AGREEMENT. No permit shall be granted until said terms and conditions have been met.

In the event that this permit is granted, the following requirements shall also be met:

(a) That sufficient barriers, lights, and warning signs shall be erected and maintained by the Permittee in such a manner as to notify pedestrian and/or operators of motor vehicles properly approaching the work site of the hazard(s) occasioned by said work. One or more signs conveying the following message or its equivalent: "STREET CLOSED: PASS AT OWN RISK," or "ROAD UNDER CONSTRUCTION - PASS AT OWN RISK" must be prominently displayed as directed by the Commissioner of Public Works.

(b) That the roadways and sidewalks shall not be unnecessarily obstructed and, so far as possible, safe and convenient ways for the use of foot travelers and vehicles shall be maintained.

(c) That the trenches and excavations shall be backfilled as directed by the Commissioner of Public Works, whose orders shall be final and conclusive.

(d) All pavement surfaces of roadways and sidewalks disturbed shall be restored by the permittee in accordance with approved City specifications of the Department of Public Works, and within such time limits set by the Commissioner.

(e) The applicant assumes full responsibility for maintenance of the pavement restoration for a period of three (3) years from the date the City considers the restoration to be completed.

The applicant shall hold the City of New Bedford harmless and indemnify it for any and all injury to loss, cost, damage, expense, (including reasonable attorneys' fees) and liability on account of the disturbance of said street surface, and any work done in connection therewith.

Any permit for disturbing the surface of public rights-of-way as herein provided may be revoked by the Mayor and City Council under the provisions of law.

Permits for disturbing the surface of public rights-of-way shall be issued by the City Clerk, subject to ratification by the Mayor and City Council; said permits to be provisional until ratified as aforesaid. Any owner who has been refused a provisional permit shall have the right to a hearing before the Mayor and City Council.

APPROVED:

Applicant Karen Turnbull

APPROVED: RT Canessa Exc.

WATER DEPARTMENT - Superintendent


DEPARTMENT OF PUBLIC WORKS Commissioner Arthur C. Egan

47

DAVID ST.

12/2/08

2/20/09

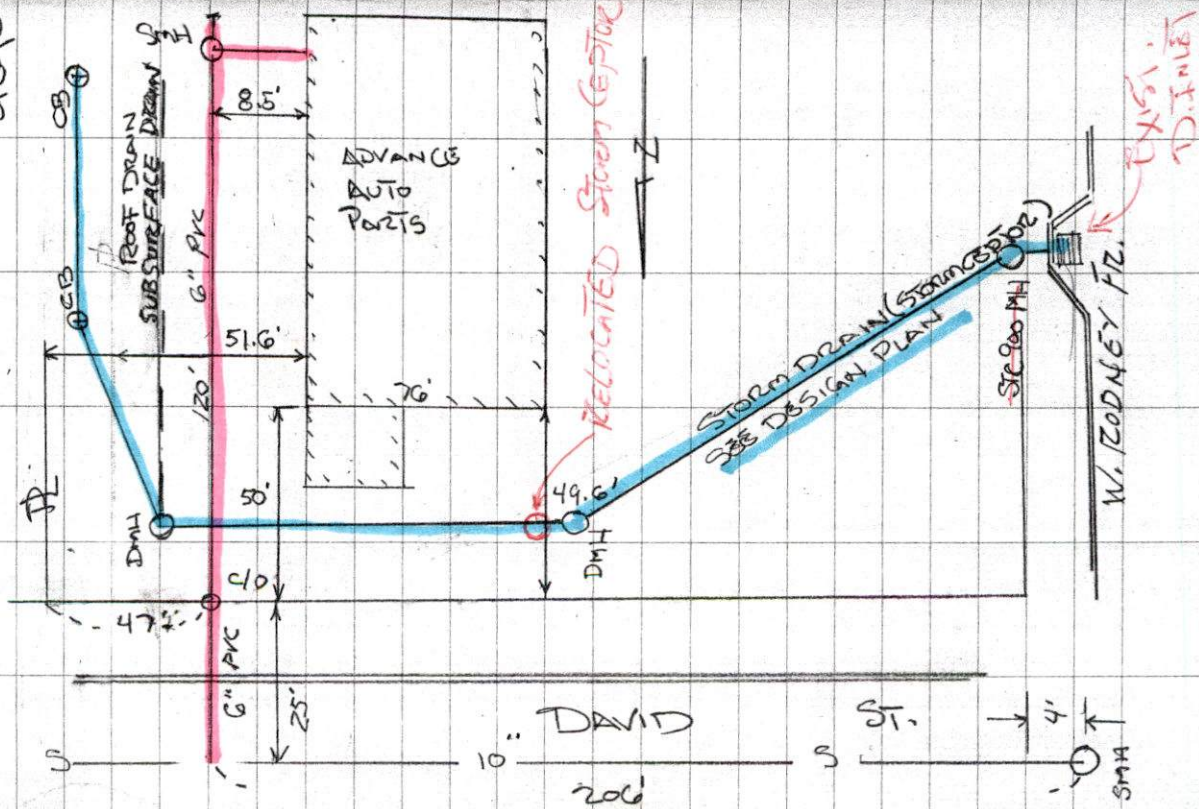

SEWER TIE-IN
INSPECTION

INSPECTION

Permit No. 24095

CONTRACTOR: R.J. CANESSA