



PERMIT NO.

24097

CITY OF NEW BEDFORD
SEWER AND/OR STORM DRAIN PERMIT

DATE 12-10-08

This certifies that permission is granted to

(Capt Leroy's)

Brian L. Faltus 226 Pope's Island

508-728-8830

Property Owner

Address

Tel.

To connect a sewer and/or storm drain located at 226 Pope's Island

Assessor's Plot 60 Lot 11, to the sewer and/or storm drain in driveway 297' from Building Street

To be laid in accordance with the conditions in this application and the City of New Bedford ordinances.

TYPE OF USE: RESIDENTIAL COMMERCIAL INDUSTRIAL FLOW G.P.D. Bathroom

If applicant other than actual property owner, attach Letter of Authorization from Property Owner.

Name Brian Carmack D.W. White Cons Tel 508-763-8868

Mailing Address 867 Middle Rd Acushnet, MA

The Bonded Contractor/Drain Layer authorized to perform this work is:

D.W. White 867 Middle Rd Acushnet MA 508-763-8868

Name

Address

Tel.

Type of Pipe Required: 2" PVC Schedule 20

PERMIT EXPIRES ONE YEAR AFTER DATE OF ISSUE

Plan attached to Permit # 24097

- Requires separate connections for sewage and storm drain where applicable. Storm water cannot be discharged to a sanitary sewer.
- All work must be inspected and approved by a D.P.I. inspector before backfilling.
- If this connection is to be part of a private service shared jointly with other building owners, attach copy of Recorded Joint Maintenance Agreement.
- Permits can be issued to Industrial and/or Commercial Applicants only upon receipt and approval by the Commissioner of Public Infrastructure of required plans and supplemental information.
- In addition, a City-issued Industrial User Discharge Permit and/or a Sewer Extension/Connection Permit issued by the Commonwealth of Massachusetts D.E.P. shall be required by the City for Industrial Discharge into the sewer system.

Industrial User Discharge Permit No. Date

Comm. Mass. Sewer Conn./Ext. Permit No. Date

A Filing and Inspection Fee of \$450, plus an Entrance Fee of \$ where applicable, must accompany this application.

Bank# J.P. Morgan Chase Bank NA Check# 1624 Date 12/10/08 Receipt# 8167

Other requirements: 24 hour inspection notice @ 508-979-1527

Connection made to Sewer Part of jointly-shared private line YES (NO)
Storm Drain

Applicant agrees to abide by the above terms, as well as all pertinent ordinances of the City of New Bedford, and such other special rules as the Commissioner of Public Infrastructure and/or City Engineer may deem necessary

Diane M. Andrade
City Engineer

Signature of Property Owner or Representative

INSPECTOR'S REPORT

INSPECTED BY:


DATE:

COMMENTS:

APPROVED

DISAP

SIGNATURE

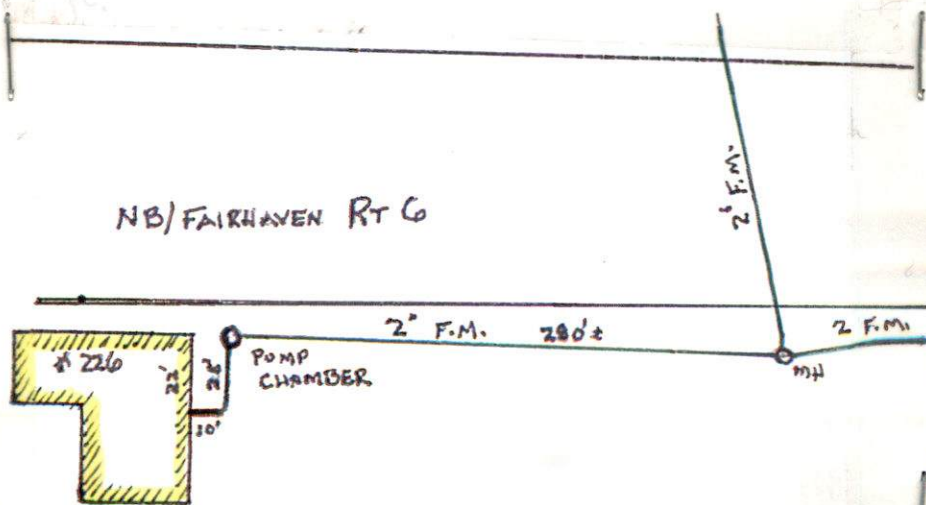

NOTE: FROM D.W. WHITE PLAN



PERMIT NO.

24097

CITY OF NEW BEDFORD
SEWER AND/OR STORM DRAIN PERMIT

DATE 12-10-08

This certifies that permission is granted to (Capt. Leroy's)

Brian H. Faltus 226 Pope's Island

508-728-8830

Property Owner

Address

Tel.

To connect a sewer and/or storm drain located at 226 Pope's Island 297' from Building

Assessor's Plot 60 Lot 11, to the sewer and/or storm drain in driveway Street

To be laid in accordance with the conditions in this application and the City of New Bedford ordinances. connect from force main to a man hole (pump chamber)

TYPE OF USE: RESIDENTIAL COMMERCIAL INDUSTRIAL FLOW G.P.D. Bathroom

If applicant other than actual property owner, attach Letter of Authorization from Property Owner.

Name Brian Carmacho D W White Cons Tel 508-763-8868

Mailing Address 867 Middle Rd Acushnet MA

The Bonded Contractor/Drain Layer authorized to perform this work is:

D W White 867 Middle Rd Acushnet MA 508-763-8868

Name

Address

Tel.

Type of Pipe Required: 2" PVC schedule 2'

PERMIT EXPIRES ONE YEAR AFTER DATE OF ISSUE

Plan attached to Permit # 24094

- Requires separate connections for sewage and storm drain where applicable. Storm water cannot be discharged to a sanitary sewer.
 - All work must be inspected and approved by a D.P.I. inspector before backfilling.
 - If this connection is to be part of a private service shared jointly with other building owners, attach copy of Recorded Joint Maintenance Agreement.
 - Permits can be issued to Industrial and/or Commercial Applicants only upon receipt and approval by the Commissioner of Public Infrastructure of required plans and supplemental information.
 - In addition, a City-issued Industrial User Discharge Permit and/or a Sewer Extension/Connection Permit issued by the Commonwealth of Massachusetts D.E.P. shall be required by the City for Industrial Discharge into the sewer system.
- Industrial User Discharge Permit No. Date

Comm. Mass. Sewer Conn./Ext. Permit No. Date

A Filing and Inspection Fee of \$450, plus an Entrance Fee of \$ where applicable, must accompany this application.

Bank J.P. Morgan Chase Bank Check# 1624 Date 12/10/08 Receipt# 8167

Other requirements: 24 hour inspection notice @ 508-979-1527

Connection made to Sewer Part of jointly-shared private line YES NO
Storm Drain

Applicant agrees to abide by the above terms, as well as all pertinent ordinances of the City of New Bedford, and such other special rules as the Commissioner of Public Infrastructure and/or City Engineer may deem necessary

Duarte M. Andrade
City Engineer

Brian Carmacho
Signature of Property Owner or Representative


INSPECTOR'S REPORT

INSPECTED BY: _____
DATE: _____
COMMENTS: _____

APPROVED

DISAPPROVED

SIGNATURE

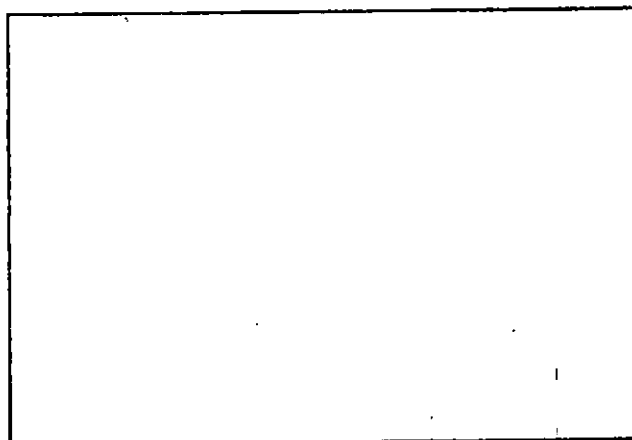

SKETCH PLAN



CITY OF NEW BEDFORD MASSACHUSETTS

D.P.I. -Engineering Division

1105 Shawmut Ave.

New Bedford, Ma. 02746

Tel: 508-991-6150

Fax: 508-961-3054

Ronald Labelle
Commissioner

Duarte M. Andrade,
Acting City Engineer

To Whom It May Concern:

I Brian L. Faltus, being
(Name) (Mailing Address)

Owner of property located at 226 Pope's Island (Capt. Leroy's)

Plot 60, Lot 11, hereby agree to allow Brian Camacho
D.W. White construction
(Name)

867 Middleboro Drushmet, MA to act on my behalf including affixing my
(Mailing Address)

signature in securing permit for:

☒ Sewer/Drain Service Permits
☐ Water Service Permits
☐ Driveway Installation Permits
☐ Sidewalk Installation Permits

I further agree to conform to, and abide by, All City rules and ask regulations applicable to the permit (s) being applied for:

Name Brian Faltus
Signature

226 Pope's Island
Address

12/10/08 508 728 8830
Date Telephone number

