



PERMIT NO.
24117

CITY OF NEW BEDFORD
SEWER AND/OR STORM DRAIN PERMIT

DATE 4/14/09

This certifies that permission is granted to

Property Owner Agnes Helen Hulse Dr. Corp. Address 867 Middle Rd. New Bedford Tel. 508-763-8868

To connect a sewer and/or storm drain located at 189 Poplar St. (Cammasmith)

Assessor's Plot 60 Lot 12 to the sewer and/or storm drain in Route 6 Street

To be laid in accordance with the conditions in this application and the City of New Bedford ordinances.

TYPE OF USE: RESIDENTIAL ☒ COMMERCIAL ☐ INDUSTRIAL ☐ FLOW ☐ G.P.D.

If applicant other than actual property owner, attach Letter of Authorization from Property Owner.

Name Brian Camacho Tel. 508-763-8868

Mailing Address 867 Middle Rd. New Bedford, MA

The Bonded Contractor/Drain Layer authorized to perform this work is:

D. M. White Construction Inc. Address 867 Middle Rd. New Bedford

Name D. M. White Construction Inc. Address 867 Middle Rd. New Bedford Tel. 508-763-8868

Type of Pipe Required: schedule 20 per 2"

PERMIT EXPIRES ONE YEAR AFTER DATE OF ISSUE

- Requires separate connections for sewage and storm drain where applicable. Storm water cannot be discharged to a sanitary sewer.
- All work must be inspected and approved by a D.P.I. inspector before backfilling.
- If this connection is to be part of a private service shared jointly with other building owners, attach copy of Recorded Joint Maintenance Agreement.
- Permits can be issued to Industrial and/or Commercial Applicants only upon receipt and approval by the Commissioner of Public Infrastructure of required plans and supplemental information.
- In addition, a City-issued Industrial User Discharge Permit and/or a Sewer Extension/Connection Permit issued by the Commonwealth of Massachusetts D.E.P. shall be required by the City for Industrial Discharge into the sewer system.

Industrial User Discharge Permit No. _____ Date _____

Comm. Mass. Sewer Conn./Ext. Permit No. _____ Date _____

A Filing and Inspection Fee of \$450.00 plus an Entrance Fee of \$_____ where applicable, must accompany this application.

Bank# hwp Check# 2533 Date 4/15/09 Receipt# 8610

Other requirements: 24 hr. inspection notice at 508-979-1527

Connection made to Sewer Part of jointly-shared private line YES NO
Storm Drain

Applicant agrees to abide by the above terms, as well as all pertinent ordinances of the City of New Bedford, and such other special rules as the Commissioner of Public Infrastructure and/or City Engineer may deem necessary

[Signature]
Acting City Engineer

[Signature]
Signature of Property Owner or Representative

INSPECTOR'S REPORT

INSPECTED BY: _____


DATE: _____

COMMENTS: _____

APPROVED

DISAPPROVED

SIGNATURE

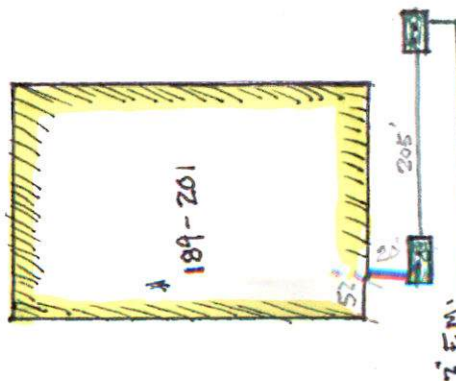



PERMIT NO.
24117

CITY OF NEW BEDFORD
SEWER AND/OR STORM DRAIN PERMIT

DATE 4/16/09

This certifies that permission is granted to

Popes Island Harbor Dev Corp. 867 Middle Rd Acushnet
Property Owner Address Tel. 508-763-8868

To connect a sewer and/or storm drain located at 189 Popes Is. (Camusmith) East side of Bldg
Assessor's Plot 60 Lot 12 to the sewer and/or storm drain in Route 6 Street

To be laid in accordance with the conditions in this application and the City of New Bedford ordinances.

TYPE OF USE: RESIDENTIAL ☒ COMMERCIAL INDUSTRIAL FLOW _____ G.P.D.

If applicant other than actual property owner, attach Letter of Authorization from Property Owner.

Name Brian Camacho Tel. 508-763-8868

Mailing Address 867 Middle Rd Acushnet Ma

The Bonded Contractor/Drain Layer authorized to perform this work is:

D.W. White Construction Inc. 867 Middle Rd Acushnet
Name Address Tel. 508-763-8868

Type of Pipe Required: schedule 21 pvc 2"

PERMIT EXPIRES ONE YEAR AFTER DATE OF ISSUE

- Requires separate connections for sewage and storm drain where applicable. Storm water cannot be discharged to a sanitary sewer.
- All work must be inspected and approved by a D.P.I. inspector before backfilling.
- If this connection is to be part of a private service shared jointly with other building owners, attach copy of Recorded Joint Maintenance Agreement.
- Permits can be issued to Industrial and/or Commercial Applicants only upon receipt and approval by the Commissioner of Public Infrastructure of required plans and supplemental information.
- In addition, a City-issued Industrial User Discharge Permit and/or a Sewer Extension/Connection Permit issued by the Commonwealth of Massachusetts D.E.P. shall be required by the City for Industrial Discharge into the sewer system.

Industrial User Discharge Permit No. _____ Date _____

Comm. Mass. Sewer Conn./Ext. Permit No. _____ Date _____

A Filing and Inspection Fee of \$450.00 plus an Entrance Fee of \$7 where applicable, must accompany this application.

Bank# bcp Check# 2533 Date 4/15/09 Receipt# 8610
2363

Other requirements: 24 hr. inspection notice at 508-979-1527

Connection made to Sewer Part of jointly-shared private line YES NO
Storm Drain

Applicant agrees to abide by the above terms, as well as all pertinent ordinances of the City of New Bedford, and such other special rules as the Commissioner of Public Infrastructure and/or City Engineer may deem necessary

[Signature]
Acting City Engineer

[Signature]
Signature of Property Owner or Representative

INSPECTOR'S REPORT

INSPECTED BY: _____

DATE: _____

COMMENTS: _____

APPROVED

DISAPPROVED

SIGNATURE

SKETCH PLAN



MASSACHUSETTS
D.P.I. -Engineering Division
1105 Shawmut Ave.
New Bedford, Ma. 02746
Tel: 508-991-6150
Fax: 508-961-3054

Ronald Labelle
Commissioner

Duarte M. Andrade,
Acting City Engineer

To Whom It May Concern:

I Mark White 867 Middle Rd. Acushnet, being
(Name) (Mailing Address)

Owner of property located at Pope's Island

Plot 60, Lot 12, hereby agree to allow Brian Camacho
(Name)

867 Middle Rd. Acushnet to act on my behalf including affixing my
(Mailing Address)

signature in securing permit for:

- ☒ Sewer/Drain Service Permits
- ☐ Water Service Permits
- ☐ Driveway Installation Permits
- ☐ Sidewalk Installation Permits

I further agree to conform to, and abide by, All City rules and ask regulations applicable to the permit (s) being applied for:

Name

Signature

867 Middle Rd. Acushnet
Address

Date

Telephone number

For Pope's Island Harbor Development Corp.