



PERMIT NO.

24128-EXT

CITY OF NEW BEDFORD  
SEWER AND/OR STORM DRAIN PERMIT

DATE 6/19/09  
Exp. 6/19/10

This certifies that permission is granted to

DPM Development Corp. 70 Lambeth St. NB, MA 508-993-0381  
Property Owner Address Tel.

To connect a sewer and/or storm drain located at Acushnet Ave. easterly to Rosa Dr.

Assessor's Plot 136 Lot....., to the sewer and/or storm drain in Acushnet Ave. Street

To be laid in accordance with the conditions in this application and the City of New Bedford ordinances.

TYPE OF USE: RESIDENTIAL COMMERCIAL INDUSTRIAL FLOW G.P.D.

DEP # W054095

If applicant other than actual property owner, attach Letter of Authorization from Property Owner.

Name..... Tel.....

Mailing Address.....

The Bonded Contractor/Drain Layer authorized to perform this work is:

RJ Canessa Exc. PO Box 51643 NB, MA 508-998-3404

Name Address Tel.

Type of Pipe Required: 12" RCP Storm Drain Main

PERMIT EXPIRES ONE YEAR AFTER DATE OF ISSUE

- Requires separate connections for sewage and storm drain where applicable. Storm water cannot be discharged to a sanitary sewer.
- All work must be inspected and approved by a D.P.I. inspector before backfilling.
- If this connection is to be part of a private service shared jointly with other building owners, attach copy of Recorded Joint Maintenance Agreement.
- Permits can be issued to Industrial and/or Commercial Applicants only upon receipt and approval by the Commissioner of Public Infrastructure of required plans and supplemental information.
- In addition, a City-issued Industrial User Discharge Permit and/or a Sewer Extension/Connection Permit issued by the Commonwealth of Massachusetts D.E.P. shall be required by the City for Industrial Discharge into the sewer system.

Industrial User Discharge Permit No..... Date.....

Comm. Mass. Sewer Conn./Ext. Permit No..... Date.....

A Filing and Inspection Fee of \$450....., plus an Entrance Fee of \$588 where applicable, must accompany this application.

Bank# Webster Bank Check# 5193 Date 6/19/09 Receipt# 8378

Other requirements: 24 hrs. inspection at 508-991-6150 for 1,397 lf of storm drain main

Connection made to Sewer Part of jointly-shared private line YES NO  
Storm Drain

Applicant agrees to abide by the above terms, as well as all pertinent ordinances of the City of New Bedford, and such other special rules as the Commissioner of Public Infrastructure and/or City Engineer may deem necessary

Duarte M. Andrade (MS)  
Acting City Engineer

Signature of Property Owner or Representative

THIS PERMIT WAS FOR WORK ON ACUSHNET AVE (MA. D.O.T PROJECT)  
INSPECTOR'S REPORT  
MAIN TO PROPERTY LINE

INSPECTED BY:.....


DATE:.....

COMMENTS:.....

APPROVED

DISAPPROVED

SIGNATURE

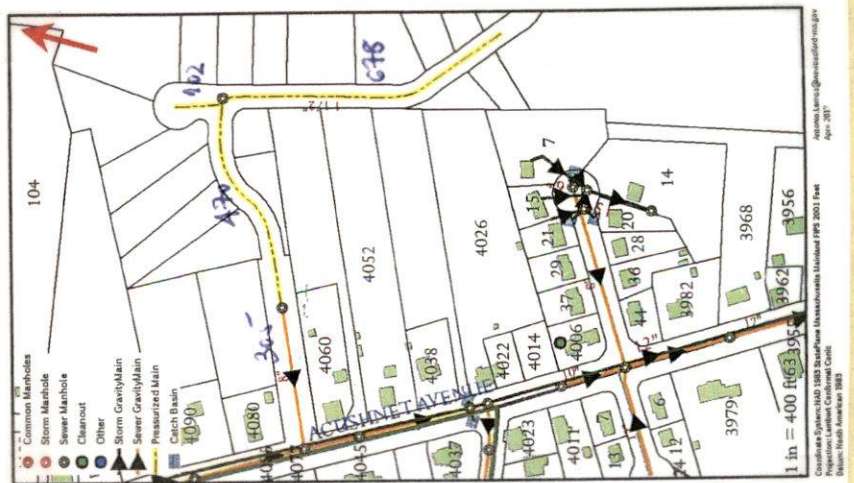





PERMIT NO.

24128 - EXT

CITY OF NEW BEDFORD  
SEWER AND/OR STORM DRAIN PERMIT

DATE 6/19/09  
Exp. 6/19/10

This certifies that permission is granted to

DPM Development Corp. 70 Lambeth St. NB MA 508-993-0381  
Property Owner Address Tel.

To connect a sewer and/or storm drain located at Acushnet Ave. easterly to Rosa Dr.

Assessor's Plot 136 Lot to the sewer and/or storm drain in Acushnet Ave. Street

To be laid in accordance with the conditions in this application and the City of New Bedford ordinances.

TYPE OF USE: RESIDENTIAL COMMERCIAL INDUSTRIAL FLOW G.P.D.

DEP # W054095

If applicant other than actual property owner, attach Letter of Authorization from Property Owner.

Name Tel.

Mailing Address

The Bonded Contractor/Drain Layer authorized to perform this work is:

RJ Canessa Exc. P.O. Box 51643 NB MA 508-998-3404

Name Address Tel.

Type of Pipe Required: 12" RCP Storm Drain Main

PERMIT EXPIRES ONE YEAR AFTER DATE OF ISSUE

- Requires separate connections for sewage and storm drain where applicable. Storm water cannot be discharged to a sanitary sewer.
- All work must be inspected and approved by a D.P.I. inspector before backfilling.
- If this connection is to be part of a private service shared jointly with other building owners, attach copy of Recorded Joint Maintenance Agreement.
- Permits can be issued to Industrial and/or Commercial Applicants only upon receipt and approval by the Commissioner of Public Infrastructure of required plans and supplemental information.
- In addition, a City-issued Industrial User Discharge Permit and/or a Sewer Extension/Connection Permit issued by the Commonwealth of Massachusetts D.E.P. shall be required by the City for Industrial Discharge into the sewer system.

Industrial User Discharge Permit No. Date

Comm. Mass. Sewer Conn./Ext. Permit No. Date

A Filing and Inspection Fee of \$450, plus an Entrance Fee of \$5,588 where applicable, must accompany this application.

Bank# Webster Bank Check# 5193 Date 6/19/09 Receipt# 8378

Other requirements: 24 hrs. inspection at 508-991-6150 for 1,397 lf of

Storm drain main

Connection made to Sewer Part of jointly-shared private line YES NO  
Storm Drain

Applicant agrees to abide by the above terms, as well as all pertinent ordinances of the City of New Bedford, and such other special rules as the Commissioner of Public Infrastructure and/or City Engineer may deem necessary

Duarte M. Andrade Acting City Engineer  
Signature of Property Owner or Representative

INSPECTOR'S REPORT

INSPECTED BY:


DATE:

COMMENTS:

APPROVED

DISAPPROVED

SIGNATURE

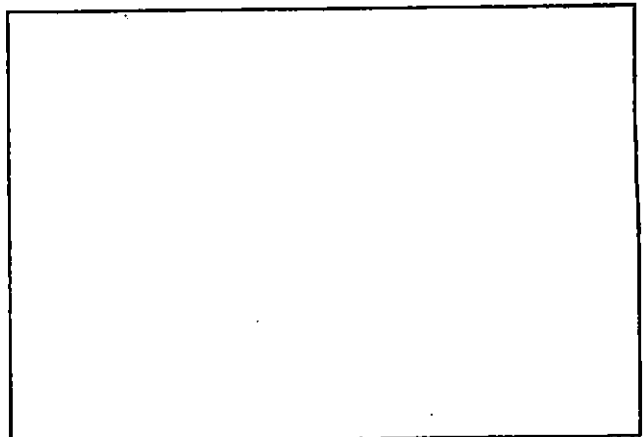

SKETCH PLAN



Inspector's Copy

PERMIT NO.

24128

CITY OF NEW BEDFORD  
SEWER AND/OR STORM DRAIN PERMIT

DATE 6/19/09

Exp. 6/19/10

This certifies that permission is granted to

DPM Development Corp 70 Lambell St. NB, MA 508-993-0381  
Property Owner Address Tel.

To connect a sewer and/or storm drain located at Acushnet Ave. easterly to Rosa Dr.

Assessor's Plot 136 Lot to the sewer and/or storm drain in Acushnet Ave. Street

To be laid in accordance with the conditions in this application and the City of New Bedford ordinances.

TYPE OF USE: RESIDENTIAL COMMERCIAL INDUSTRIAL FLOW G.P.D.

DEP # W054095

If applicant other than actual property owner, attach Letter of Authorization from Property Owner.

Name Tel.

Mailing Address

The Bonded Contractor/Drain Layer authorized to perform this work is:

R.J. Canessa Exc. PO Box 51643 NB, MA 508-998-3404

Name Address Tel.

Type of Pipe Required: 12" RCP Storm Drain Main

PERMIT EXPIRES ONE YEAR AFTER DATE OF ISSUE

- Requires separate connections for sewage and storm drain where applicable. Storm water cannot be discharged to a sanitary sewer.
  - All work must be inspected and approved by a D.P.I. inspector before backfilling.
  - If this connection is to be part of a private service shared jointly with other building owners, attach copy of Recorded Joint Maintenance Agreement.
  - Permits can be issued to Industrial and/or Commercial Applicants only upon receipt and approval by the Commissioner of Public Infrastructure of required plans and supplemental information.
  - In addition, a City-issued Industrial User Discharge Permit and/or a Sewer Extension/Connection Permit issued by the Commonwealth of Massachusetts D.E.P. shall be required by the City for Industrial Discharge into the sewer system.
- Industrial User Discharge Permit No. Date

Comm. Mass. Sewer Conn./Ext. Permit No. Date

A Filing and Inspection Fee of \$450, plus an Entrance Fee of \$5,588 where applicable, must accompany this application.

Bank# Webster Bank Check# 5193 Date 6/19/09 Receipt# 8378

Other requirements: 24 hrs. inspection at 508-991-6150 for 1,397 lf of Storm drain main

Connection made to Sewer Part of jointly-shared private line YES NO  
Storm Drain

Applicant agrees to abide by the above terms, as well as all pertinent ordinances of the City of New Bedford, and such other special rules as the Commissioner of Public Infrastructure and/or City Engineer may deem necessary

Duarte M. Andrade  
Acting City Engineer

Signature of Property Owner or Representative

INSPECTOR'S REPORT

INSPECTED BY:


DATE:

COMMENTS:

APPROVED

DISAPPROVED

SIGNATURE

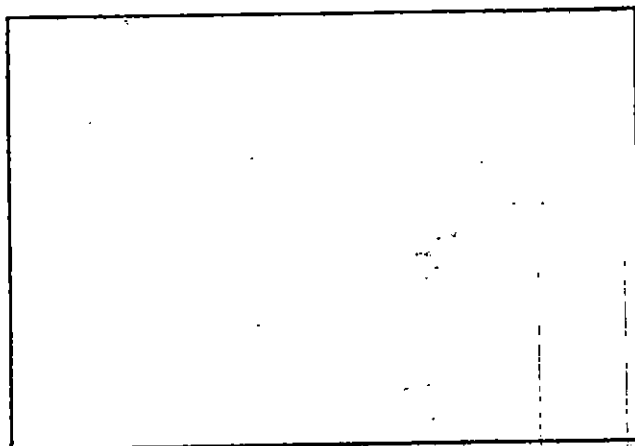

SKETCH PLAN