



PERMIT NO.

24139

CITY OF NEW BEDFORD  
SEWER AND/OR STORM DRAIN PERMIT

DATE 8/24/09

This certifies that permission is granted to

Coalition for Buzzards Bay 114-120 Front St. NB 508-997-6363  
Property Owner Address Tel.To connect a sewer and/or storm drain located at 12" storm drain in Rodman St.  
8" sewer in Rodman St.

Assessor's Plot 53 Lot 178, to the sewer and/or storm drain in Rodman St. Street

To be laid in accordance with the conditions in this application and the City of New Bedford ordinances.

TYPE OF USE: RESIDENTIAL ☒ COMMERCIAL INDUSTRIAL FLOW G.P.D.

If applicant other than actual property owner, attach Letter of Authorization from Property Owner.

Name: Steven Pagan - B. Laganan Tel. 508 984 1668

Mailing Address: 21 East River Dr. Dartmouth, MA 02747

The Bonded Contractor/Drain Layer authorized to perform this work is:

JB Tanager Co. Inc. 21 East River Dr. Dartmouth, MA

Name Address Tel. 508 984 1668

Type of Pipe Required: SDR-35 PVC

## PERMIT EXPIRES ONE YEAR AFTER DATE OF ISSUE

- Requires separate connections for sewage and storm drain where applicable. Storm water cannot be discharged to a sanitary sewer.
- All work must be inspected and approved by a D.P.I. inspector before backfilling.
- If this connection is to be part of a private service shared jointly with other building owners, attach copy of Recorded Joint Maintenance Agreement.
- Permits can be issued to Industrial and/or Commercial Applicants only upon receipt and approval by the Commissioner of Public Infrastructure of required plans and supplemental information.
- In addition, a City-issued Industrial User Discharge Permit and/or a Sewer Extension/Connection Permit issued by the Commonwealth of Massachusetts D.E.P. shall be required by the City for Industrial Discharge into the sewer system.

Industrial User Discharge Permit No. Date

Comm. Mass. Sewer Conn./Ext. Permit No. Date

A Filing and Inspection Fee of \$450.00, plus an Entrance Fee of \$ where applicable, must accompany this application.

Bank# Sovereign Bank Check# 40627 Date 8/26/09 Receipt# 68446

Other requirements: D.P.E. to handle bluestone crosswalk repairs.

24 hr inspection notice at 508 979 1527. Sewer to be capped in basement

Connection made to Sewer Part of jointly-shared private line YES NO

Storm Drain

Applicant agrees to abide by the above terms, as well as all pertinent ordinances of the City of New Bedford, and such other special rules as the Commissioner of Public Infrastructure and/or City Engineer may deem necessary

Dante M. Andrade / mr  
Acting City Engineer

Signature of Property Owner or Representative

## INSPECTOR'S REPORT

INSPECTED BY: RB


DATE: 9/23/09

COMMENTS:

APPROVED

DISAPPROVED

SIGNATURE

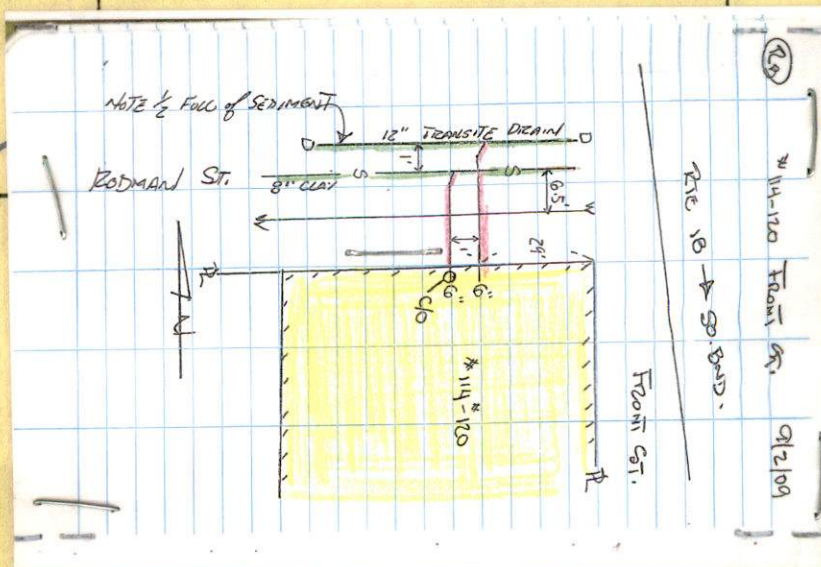



P.79  
ON PLOT/NO CARD

Drain 9/2/09 11am Inspector's Copy Sewer 9/2/09 3pm



PERMIT NO.  
24139

CITY OF NEW BEDFORD  
SEWER AND/OR STORM DRAIN PERMIT

DATE 8/26/09

This certifies that permission is granted to

Coalition for Buzzards Bay 114-120 Front St NB 508-999-6363  
Property Owner Address Tel  
12" storm drain in Rodman St.

To connect a sewer and/or storm drain located at 8" sewer in Rodman St.

Assessor's Plot 53 Lot 178, to the sewer and/or storm drain in Rodman St. Street

To be laid in accordance with the conditions in this application and the City of New Bedford ordinances.  
TYPE OF USE: RESIDENTIAL ☒ COMMERCIAL INDUSTRIAL FLOW G.P.D.

If applicant other than actual property owner, attach Letter of Authorization from Property Owner.  
Name Steve Regendes - J.B. Laganan Tel 508 984 1668  
Mailing Address 21 East River Dr Dartmouth Ma 02747  
The Bonded Contractor/Drain Layer authorized to perform this work is:  
J.B. Laganan Co Inc 21 East River Dr Dartmouth MA  
Name Address Tel 508 984 1668  
Type of Pipe Required: S.D.R-35 P.V.C.

PERMIT EXPIRES ONE YEAR AFTER DATE OF ISSUE

- Requires separate connections for sewage and storm drain where applicable. Storm water cannot be discharged to a sanitary sewer.
  - All work must be inspected and approved by a D.P.I. inspector before backfilling.
  - If this connection is to be part of a private service shared jointly with other building owners, attach copy of Recorded Joint Maintenance Agreement.
  - Permits can be issued to Industrial and/or Commercial Applicants only upon receipt and approval by the Commissioner of Public Infrastructure of required plans and supplemental information.
  - In addition, a City-issued Industrial User Discharge Permit and/or a Sewer Extension/Connection Permit issued by the Commonwealth of Massachusetts D.E.P. shall be required by the City for Industrial Discharge into the sewer system.
- Industrial User Discharge Permit No. Date

Comm. Mass. Sewer Conn./Ext. Permit No. Date  
A Filing and Inspection Fee of \$450.00 plus an Entrance Fee of \$ where applicable, must accompany this application.

Bank# Sovereign Bank Check# 40627 Date 8/26/09 Receipt# 08446

Other requirements: D.P.F. to handle bluestone crosswalk repairs  
24 hr inspection notice at 508 979 1527 Sewer to be capped in basement

Connection made to Sewer Part of jointly-shared private line YES NO  
Storm Drain

Applicant agrees to abide by the above terms, as well as all pertinent ordinances of the City of New Bedford, and such other special rules as the Commissioner of Public Infrastructure and/or City Engineer may deem necessary


Dora M. Andrade  
Acting City Engineer

Signature of Property Owner or Representative

INSPECTOR'S REPORT


INSPECTED BY: [Signature]  
DATE: 9/23/09  
COMMENTS:

APPROVED [Signature] DISAPPROVED  
SIGNATURE

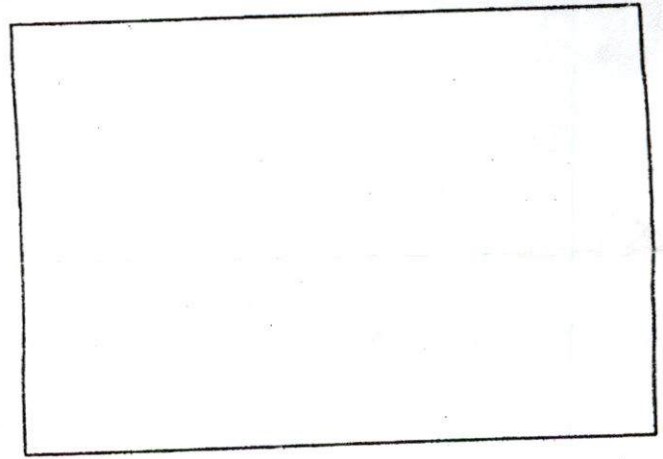

SKETCH PLAN

rec'd 10/21/09

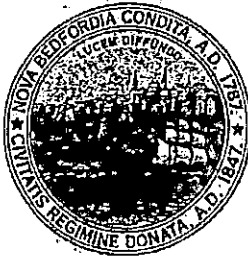

# CITY OF NEW BEDFORD MASSACHUSETTS

D.P.I. -Engineering Division

1105 Shawmut Ave.

New Bedford, Ma. 02746

Tel: 508-991-6150

Fax: 508-991-6152

Ronald Labelle  
Commissioner

Duarte M. Andrade  
Acting City Engineer

To Whom It May Concern:

I MARK RASMUSSEN - Coalition For Buzzards Bay, being  
(Name) (Mailing Address)

Owner of property located at 114-120 FRONT STREET

Plot 53, Lot 178, hereby agree to allow J.B. LAHAGAN Co, Inc.  
(Name)

21 EAST RIVER DR. DARTMOUTH, MA-02747, to act on my behalf including affixing my  
(Mailing Address)

signature in securing permit for:

☒ Sewer/Drain Service Permits  
☒ Water Service Permits  
☒ Driveway Installation Permits  
☒ Sidewalk Installation Permits

I further agree to conform to, and abide by, All City rules and ask regulations applicable to  
the permit (s) being applied for:

Name Mark Rasmussen  
Signature

THE COALITION FOR BUZZARDS BAY  
Address

8/21/09 508-999-6363 x. 201  
Date Telephone number



**Mary T. Neves**

---

**From:** Sarah Porter  
**Sent:** Thursday, August 27, 2009 5:31 PM  
**To:** Mary T. Neves  
**Subject:** RE: SEWER PERMIT

Hi Mary all set to issue - no wetlands issues  
Thanks  
Sarah

---

**From:** Mary T. Neves  
**Sent:** Wednesday, August 26, 2009 9:51 AM  
**To:** Sarah Porter  
**Subject:** SEWER PERMIT

Hi,

The Coalition for Buzzards Bay wants to connect 114-120 Front Street to the sewer in Rodman Street.

The plot is 53 and the lot is 178. May we issue this permit?

Thanks for your help.


(12)

# 114-120 FRONT ST.

9/2/09

RE. 18 - 30 B.O.D.

FRONT ST.

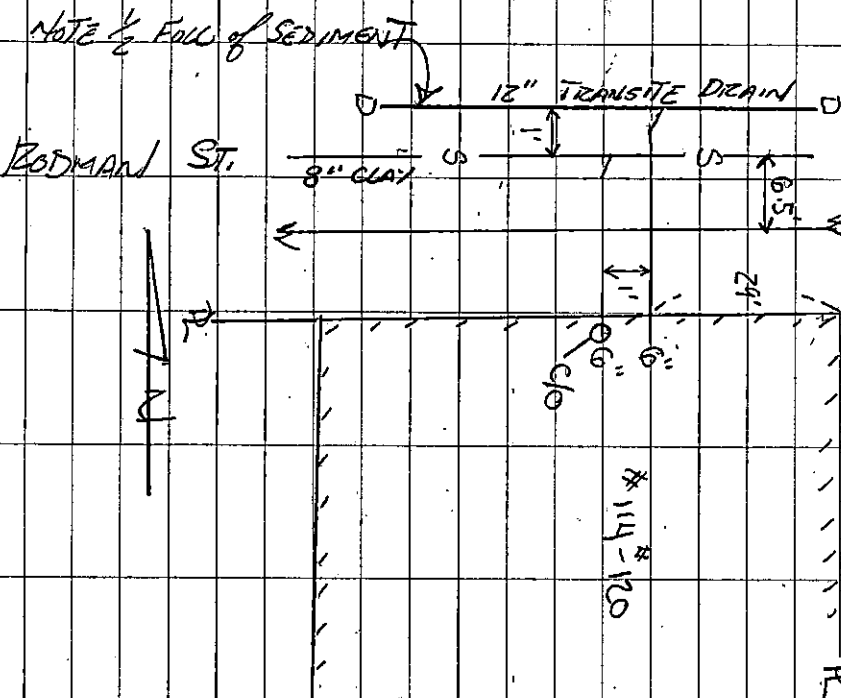

(13)

NEW

CONCRETE + DRAIN TIE-IN  
ON EXISTING 14\"/>

PERMIT # 24139

CONTRACTOR: JOE LANSBORN / JOHN

INSPECTOR: ROBSON, JIM

Submit to DNRA for  
RECORDS 10/2/09