



PERMIT NO.

24180

CITY OF NEW BEDFORD
SEWER AND/OR STORM DRAIN PERMIT

DATE 3/19/10
EXP. 9/19/10

This certifies that permission is granted to

Marguerite Pellerin 3186 Acushnet Ave. NB 508-998-5191
Property Owner Address Tel.

To connect a sewer and/or storm drain located at 3186 Acushnet Ave.

Assessor's Plot 132I Lot 47, to the sewer and/or storm drain in Acushnet Ave 6" Street

To be laid in accordance with the conditions in this application and the City of New Bedford ordinances.

TYPE OF USE: RESIDENTIAL COMMERCIAL INDUSTRIAL FLOW 440 G.P.D.

If applicant other than actual property owner, attach Letter of Authorization from Property Owner.

Name..... Tel.....

Mailing Address.....

The Bonded Contractor/Drain Layer authorized to perform this work is:

James Blanchard Joseph G. Mello Inc.

Name..... Address..... Tel.....

Type of Pipe Required: PVC SDR-35

PERMIT EXPIRES ONE YEAR AFTER DATE OF ISSUE

- Requires separate connections for sewage and storm drain where applicable. Storm water cannot be discharged to a sanitary sewer.
- All work must be inspected and approved by a D.P.I. inspector before backfilling.
- If this connection is to be part of a private service shared jointly with other building owners, attach copy of Recorded Joint Maintenance Agreement.
- Permits can be issued to Industrial and/or Commercial Applicants only upon receipt and approval by the Commissioner of Public Infrastructure of required plans and supplemental information.
- In addition, a City-issued Industrial User Discharge Permit and/or a Sewer Extension/Connection Permit issued by the Commonwealth of Massachusetts D.E.P. shall be required by the City for Industrial Discharge into the sewer system.

Industrial User Discharge Permit No..... Date.....

Comm. Mass. Sewer Conn./Ext. Permit No..... Date.....

A Filing and Inspection Fee of \$ 450., plus an Entrance Fee of \$ — where applicable, must accompany this application.

Bank# First Citizens C.U. Check# 107 Date 3/19/10 Receipt# 8664

Other requirements: Insp. Only. Connect to stub at prop. line. - Need to record easement when ownership of this lot + house behind have ownership changes.

Connection made to Sewer reference Sewer Permit # 24179
Storm Drain Part of jointly-shared private line YES NO

Applicant agrees to abide by the above terms, as well as all pertinent ordinances of the City of New Bedford, and such other special rules as the Commissioner of Public Infrastructure and/or City Engineer may deem necessary

Dante M. Andrade MS Marguerite Pellerin
Acting City Engineer Signature of Property Owner or Representative

INSPECTOR'S REPORT

INSPECTED BY: RP

DATE: 5/17/10

COMMENTS:

APPROVED

DISAPPROVED

[Signature]
SIGNATURE

SKETCH PLAN

No. 10-02

FEE 50.00

Rec 5798

COMMONWEALTH OF MASSACHUSETTS

Board of Health, New Bedford, MA.

DISPOSAL SYSTEM CONSTRUCTION PERMIT

Permission is hereby granted to; Construct() Repair() Upgrade() Abandon(☒) an individual sewage disposal system
at 3186 Acushnet Ave as described in the application for

Disposal System Construction Permit No. 10-02, dated 3-19-10.

Provided: Construction shall be completed within three years of the date of this permit. All local conditions must be met.

Form 1255 Rev. 5/96 A.M. Sulkin Co. Boston, MA

Date 3-19-10 Board of Health [Signature]

Cheveli A. Torres

From: Sarah Porter
Sent: Thursday, March 18, 2010 5:09 PM
To: Cheveli A. Torres
Cc: Kerry Muldoon; Carol Sherman
Subject: RE: sewer permit

Cheveli, you can issue the permit – State protected wetlands are not involved on that parcel of land and we know the contractor will be staying on the person's property and tying into the City sewer system.

Thank you

Sarah Porter

Conservation Agent

From: Cheveli A. Torres
Sent: Thursday, March 18, 2010 1:43 PM
To: Sarah Porter
Subject:

Sarah,


We had a gentleman come in today for a Sewer permit for the address of 3186 Acushnet Avenue ,They would like to tie into the City

Sewer . There is a stub at the property line. Also, abandoning his septage system. Is it ok to issue this sewer permit.

Thank you,
Cheveli

3186 ACUSH. AVE.
+ REAR

CA

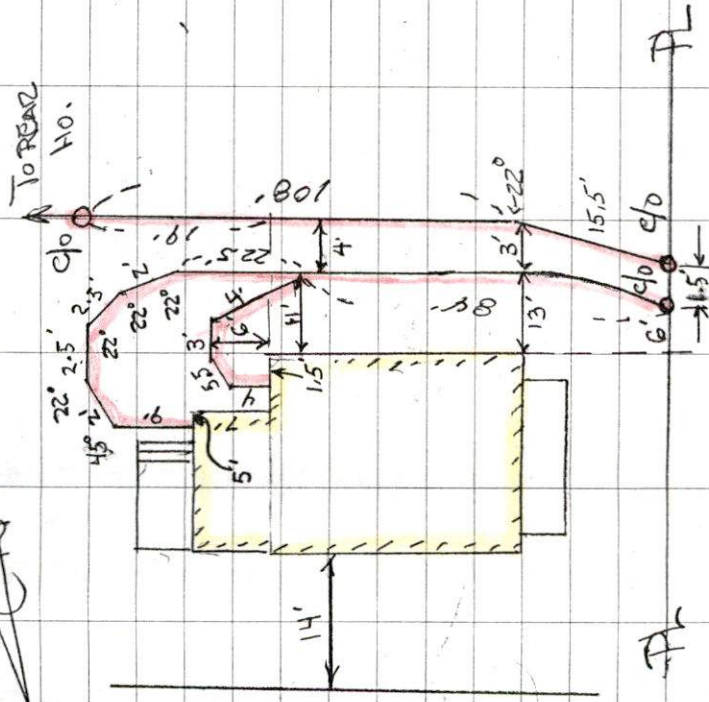

EOP.

ACUSH. AVE

* SEE PAGE # 62
FOR REAR HOUSE SKETCH
ALSO SEE PAGE 61 FOR
3186 TO SALE

(80)

SEWER TIE-INS

DRAW: 5/17/10

CONTRACTOR: JOSEPH A. NELLO INC
FORBMAN, STEVE PAXSON
774-930-9765

INST: BOB BICKEL

PERMIT #'S 24180
24179

PLAT R21I LOTS 47 & 157

3186 ACUSHNET AVE

ACUSHNET AVE. (Public 60' wide)



PERMIT # 24180

SEE PAGE 60 ALSO

