



PERMIT NO.

CITY OF NEW BEDFORD  
SEWER AND/OR STORM DRAIN PERMIT

DATE

5/11/10  
EXP 5/11/11

24194

This certifies that permission is granted to

Helena Favares  
Ernesto Favares

Property Owner

Address

Tel. 508-997-0092

To connect a sewer and/or storm drain located at 1158 Sawyer St.

Assessor's Plot 87 Lot 53, to the sewer and/or storm drain in Sawyer St. Street

To be laid in accordance with the conditions in this application and the City of New Bedford ordinances.

TYPE OF USE: RESIDENTIAL COMMERCIAL INDUSTRIAL FLOW 330 G.P.D.

If applicant other than actual property owner, attach Letter of Authorization from Property Owner.

Name..... Tel.....

Mailing Address.....

The Bonded Contractor/Drain Layer authorized to perform this work is:

R.S. Canessa, Inc. P.O. Box 51643 New Bedford, MA 02745

Name..... Address.....

Tel. 508-998-3404

Type of Pipe Required: 6" S.D. 3.5 PVC

PERMIT EXPIRES ONE YEAR AFTER DATE OF ISSUE

- Requires separate connections for sewage and storm drain where applicable. Storm water cannot be discharged to a sanitary sewer.
- All work must be inspected and approved by a D.P.I. inspector before backfilling.
- If this connection is to be part of a private service shared jointly with other building owners, attach copy of Recorded Joint Maintenance Agreement.
- Permits can be issued to Industrial and/or Commercial Applicants only upon receipt and approval by the Commissioner of Public Infrastructure of required plans and supplemental information.
- In addition, a City-issued Industrial User Discharge Permit and/or a Sewer Extension/Connection Permit issued by the Commonwealth of Massachusetts D.E.P. shall be required by the City for Industrial Discharge into the sewer system.

Industrial User Discharge Permit No..... Date.....

Comm. Mass. Sewer Conn./Ext. Permit No..... Date.....

A Filing and Inspection Fee of \$450, plus an Entrance Fee of \$440.00 where applicable, must accompany this application.

Bank# Sovereign Bank Check# 1030 Date 5-11-10 Receipt# 8758

Other requirements: 24 hour notice for inspection at 508-999-1527

Connection made to Sewer Part of jointly-shared private line YES NO  
Storm Drain

Applicant agrees to abide by the above terms, as well as all pertinent ordinances of the City of New Bedford, and such other special rules as the Commissioner of Public Infrastructure and/or City Engineer may deem necessary

Duarte M. Andrade, Jr.  
Acting City Engineer

Helena Favares  
Signature of Property Owner or Representative


INSPECTOR'S REPORT

INSPECTED BY:   
DATE: 5/12/10  
COMMENTS:

APPROVED

DISA

SIGNATURE

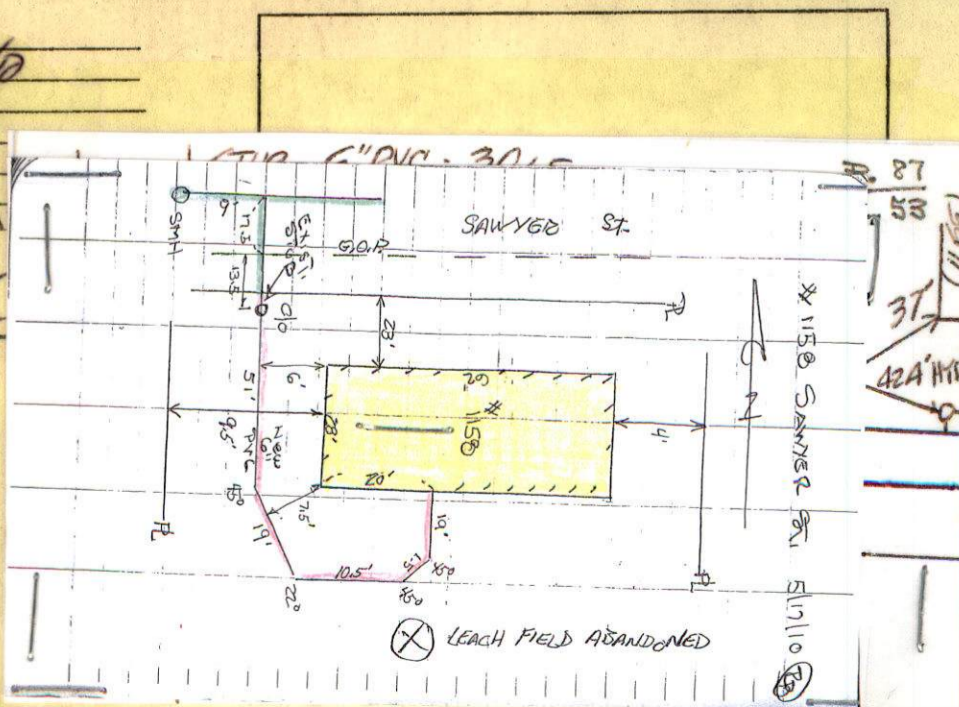



PERMIT NO.

CITY OF NEW BEDFORD  
SEWER AND/OR STORM DRAIN PERMIT

DATE 5/11/10  
EXP 5/11/11

24194

This certifies that permission is granted to

Helena Tavares  
Ernesto Tavares 1158 Sawyer St - New Bedford, MA 02740  
Property Owner Address Tel. 508-997-0092

To connect a sewer and/or storm drain located at 1158 Sawyer St.

Assessor's Plot 87 Lot 53, to the sewer and/or storm drain in Sawyer St. Street

To be laid in accordance with the conditions in this application and the City of New Bedford ordinances.

TYPE OF USE: RESIDENTIAL COMMERCIAL INDUSTRIAL FLOW 330 G.P.D.

If applicant other than actual property owner, attach Letter of Authorization from Property Owner.

Name..... Tel.....

Mailing Address.....

The Bonded Contractor/Drain Layer authorized to perform this work is:

R.S. Canessa Inc. P.O. Box 51643 New Bedford, MA 02745  
Name Address Tel. 508-998-3404

Type of Pipe Required: 6" S.D. 3.5 PVC

PERMIT EXPIRES ONE YEAR AFTER DATE OF ISSUE

- Requires separate connections for sewage and storm drain where applicable. Storm water cannot be discharged to a sanitary sewer.
- All work must be inspected and approved by a D.P.I. inspector before backfilling.
- If this connection is to be part of a private service shared jointly with other building owners, attach copy of Recorded Joint Maintenance Agreement.
- Permits can be issued to Industrial and/or Commercial Applicants only upon receipt and approval by the Commissioner of Public Infrastructure of required plans and supplemental information.
- In addition, a City-issued Industrial User Discharge Permit and/or a Sewer Extension/Connection Permit issued by the Commonwealth of Massachusetts D.E.P. shall be required by the City for Industrial Discharge into the sewer system.

Industrial User Discharge Permit No..... Date.....

Comm. Mass. Sewer Conn./Ext. Permit No..... Date.....

A Filing and Inspection Fee of \$450, plus an Entrance Fee of \$441.00 where applicable, must accompany this application.

Bank# Sovereign Bank Check# 1030 Date 5-11-10 Receipt# 8758

Other requirements: 24 hour notice for inspection at 508-998-1527

Connection made to Sewer Part of jointly-shared private line YES NO  
Storm Drain

Applicant agrees to abide by the above terms, as well as all pertinent ordinances of the City of New Bedford, and such other special rules as the Commissioner of Public Infrastructure and/or City Engineer may deem necessary

Duarte M. Andrade cs  
Acting City Engineer

Helena Tavares  
Signature of Property Owner or Representative

INSPECTOR'S REPORT

INSPECTED BY: [Signature]


DATE: 5/11/10

COMMENTS: \_\_\_\_\_

APPROVED

DISAPPROVED

SIGNATURE

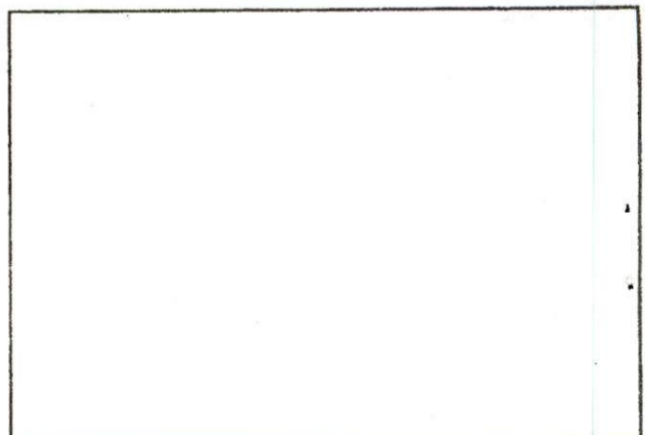

SKETCH PLAN

No. 10-04

COMMONWEALTH OF MASSACHUSETTS

Board of Health, New Bedford, MA.

DISPOSAL SYSTEM CONSTRUCTION PERMIT

FEE 50.00

Rec #

5848

Permission is hereby granted to; Construct( ) Repair( ) Upgrade( ) Abandon(☒) an individual sewage disposal system  
1158 Sawyer St as described in the application for  
Disposal System Construction Permit No. 10-04, dated 5/11/10.

provided: Construction shall be completed within three years of the date of this permit. All local conditions must be met.

m 1255 Rev. 5/96 A.M. Sulkin Co. Boston, MA

Date 5/11/10 Board of Health [Signature]

(-) Helena Tavares  
(508) 997 0092  
or

508 287 6990

1158 Sawyer St. 02740

450. permit  
450.00  
3068 X 14.70 = 441.00  
891.00

## Carol Sherman

---

**From:** Sarah Porter  
**Sent:** Friday, April 30, 2010 11:07 AM  
**To:** Carol Sherman  
**Subject:** RE: SEWER TIE-IN

Carol, all set, no wetland issues  
Thanks  
Sarah

---

**From:** Carol Sherman  
**Sent:** Friday, April 30, 2010 10:53 AM  
**To:** Sarah Porter  
**Subject:** SEWER TIE-IN

SARA

PROPERTY OWNER , HELENA TAVARES OF 1158 SAWYER ST IS INTERESTED IN SEWER TIE-IN.

COULD YOU LET ME KNOW IF THAT WOULD BE APPROVED BY YOU

THANKS

CAROL

1105 Shawmut Avenue  
New Bedford, MA 02746  
Phone: 508-979-1551  
Fax: 508-991-6152

City of New Bedford,  
DPI

# Fax


To: Mary Freire From: Carol - DPI  
Fax: 508-961-3143 Date: 5-11-10  
Phone: \_\_\_\_\_ Pages: 2  
Re: \_\_\_\_\_ CC: \_\_\_\_\_

☐ Urgent ☐ For Review ☐ Please Comment ☐ Please Reply ☐ Please Recycle

•Comments: Helena Tavares - 1158 Sawyer St  
requested I fax you  
Sewer Permit

#1158 SAWYER ST. 5/17/10 25

C 4

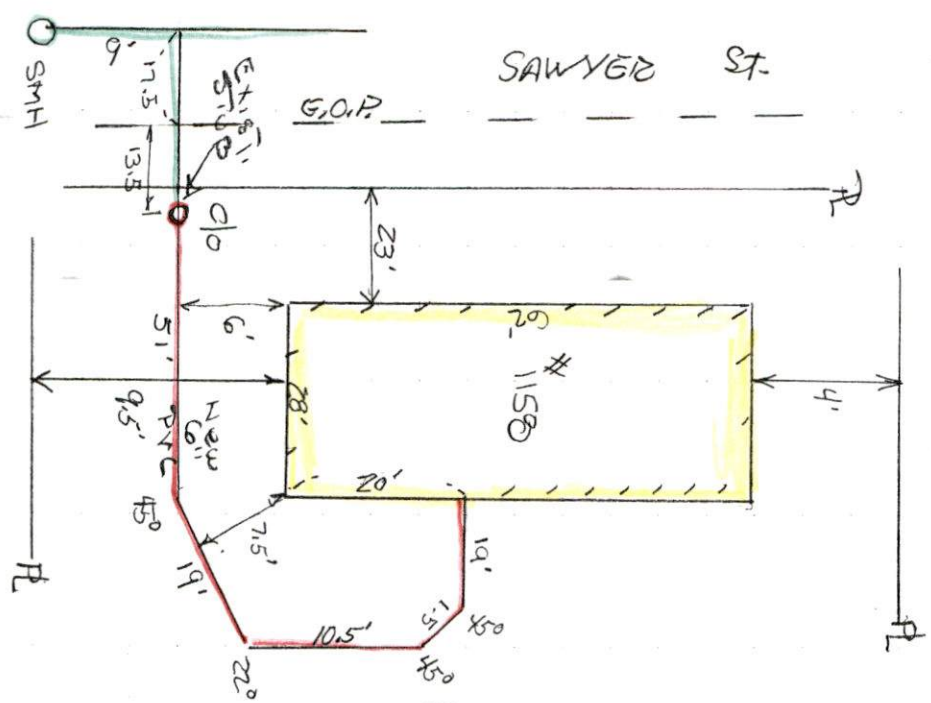

X LEACH FIELD ABANDONED

51

CONTRACT: 125 CANNESHA  
 INSUR: R.B. CHIL - DPT ENG  
 PERMIT # 24194  
 PLOAN LOT 53  
 DATE: 5/17/10

Submit for 3/11/10  
 "Reasons"