



PERMIT NO.

24230

CITY OF NEW BEDFORD
SEWER AND/OR STORM DRAIN PERMIT

DATE 11/22/10

Expires: 11/22/11

This certifies that permission is granted to

Donny Botelho

3 Joy Rd.

774-930-2580

Property Owner

Address

Tel.

To connect a sewer and/or storm drain located at 17 Joy Rd.

Assessor's Plot 121 Lot 156, to the sewer and/or storm drain in Joy Rd. Street

To be laid in accordance with the conditions in this application and the City of New Bedford ordinances.

TYPE OF USE: RESIDENTIAL COMMERCIAL INDUSTRIAL FLOW 330 G.P.D.

If applicant other than actual property owner, attach Letter of Authorization from Property Owner.

Name Jose T. de Sousa J.T. Home Builders Tel. 774-930-1024

Mailing Address P.O. Box 80038, Dartmouth, MA 02748

The Bonded Contractor/Drain Layer authorized to perform this work is:

Pico Construction

Name

Address

Tel.

Type of Pipe Required: SDR 35 PVC

PERMIT EXPIRES ONE YEAR AFTER DATE OF ISSUE

- Requires separate connections for sewage and storm drain where applicable. Storm water cannot be discharged to a sanitary sewer.
- All work must be inspected and approved by a D.P.I. inspector before backfilling.
- If this connection is to be part of a private service shared jointly with other building owners, attach copy of Recorded Joint Maintenance Agreement.
- Permits can be issued to Industrial and/or Commercial Applicants only upon receipt and approval by the Commissioner of Public Infrastructure of required plans and supplemental information.
- In addition, a City-issued Industrial User Discharge Permit and/or a Sewer Extension/Connection Permit issued by the Commonwealth of Massachusetts D.E.P. shall be required by the City for Industrial Discharge into the sewer system.

Industrial User Discharge Permit No. Date

Comm. Mass. Sewer Conn./Ext. Permit No. Date

A Filing and Inspection Fee of \$450.00 plus an Entrance Fee of \$ where applicable, must accompany this application.

Bank# Bank Five Check# 2545 (2545) Date 11/22/10 Receipt# 9162

Other requirements: 24 hour notice required 508-991-6150

Connection made to Sewer Part of jointly-shared private line YES NO
Storm Drain

Applicant agrees to abide by the above terms, as well as all pertinent ordinances of the City of New Bedford, and such other special rules as the Commissioner of Public Infrastructure and/or City Engineer may deem necessary

Christie M. Andrade
Acting City Engineer

Signature of Property Owner or Representative


INSPECTOR'S REPORT

INSPECTED BY: _____
DATE: _____
COMMENTS: _____

APPROVED

DISAPPROVED

SIGNATURE

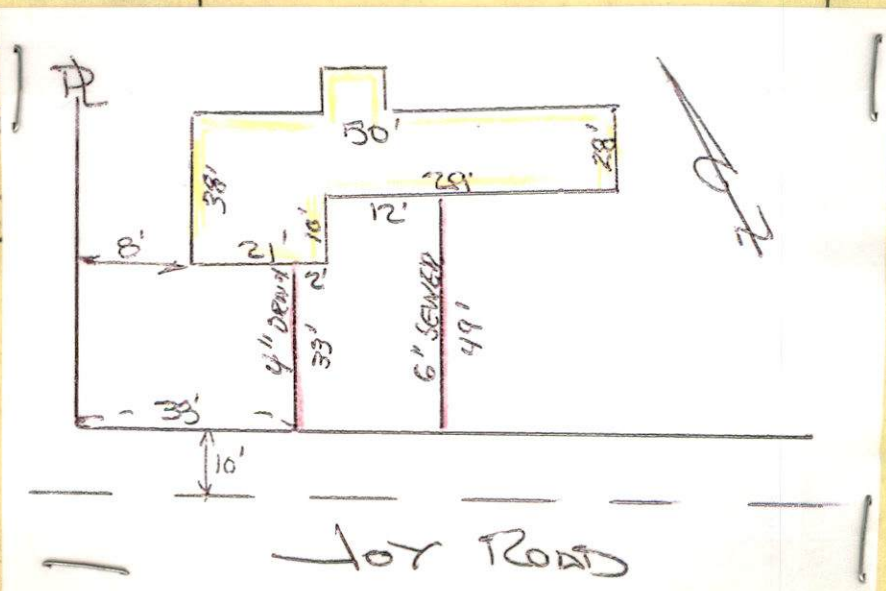



PERMIT NO.

24230

CITY OF NEW BEDFORD
SEWER AND/OR STORM DRAIN PERMIT

DATE 11/22/10

Expires: 11/22/11

This certifies that permission is granted to

Donny Botelho 3 Joy Rd. 774-930-2580
Property Owner Address Tel.

To connect a sewer and/or storm drain located at 17 Joy Rd.

Assessor's Plot 121 Lot 156a, to the sewer and/or storm drain in Joy Rd. Street

To be laid in accordance with the conditions in this application and the City of New Bedford ordinances.

TYPE OF USE: RESIDENTIAL COMMERCIAL INDUSTRIAL FLOW 330 G.P.D.

If applicant other than actual property owner, attach Letter of Authorization from Property Owner.

Name Jose T. de Sousa J.T. Home Builders Tel. 774-930-1024

Mailing Address P.O. Box 80038, Dartmouth, MA 02748

The Bonded Contractor/Drain Layer authorized to perform this work is:

Pico Construction

Name Address Tel.

Type of Pipe Required: SDR 35 PVC

PERMIT EXPIRES ONE YEAR AFTER DATE OF ISSUE

- Requires separate connections for sewage and storm drain where applicable. Storm water cannot be discharged to a sanitary sewer.
- All work must be inspected and approved by a D.P.I. inspector before backfilling.
- If this connection is to be part of a private service shared jointly with other building owners, attach copy of Recorded Joint Maintenance Agreement.
- Permits can be issued to Industrial and/or Commercial Applicants only upon receipt and approval by the Commissioner of Public Infrastructure of required plans and supplemental information.
- In addition, a City-issued Industrial User Discharge Permit and/or a Sewer Extension/Connection Permit issued by the Commonwealth of Massachusetts D.E.P. shall be required by the City for Industrial Discharge into the sewer system.

Industrial User Discharge Permit No. Date

Comm. Mass. Sewer Conn./Ext. Permit No. Date

A Filing and Inspection Fee of \$450.00 plus an Entrance Fee of \$ where applicable, must accompany this application.

Bank# Bank Five Check# 2545 (2545) Date 11/22/10 Receipt# 9162

Other requirements: 24 hour notice required 508-991-6150

Connection made to Sewer Part of jointly-shared private line YES NO
Storm Drain

Applicant agrees to abide by the above terms, as well as all pertinent ordinances of the City of New Bedford, and such other special rules as the Commissioner of Public Infrastructure and/or City Engineer may deem necessary

Quarte M. Andrade
Acting City Engineer SMS

Signature of Property Owner or Representative

INSPECTOR'S REPORT

INSPECTED BY:

DATE:

COMMENTS:

APPROVED

DISAPPROVED

SIGNATURE

SKETCH PLAN



**CITY OF NEW BEDFORD
MASSACHUSETTS**

D.P.I. -Engineering Division

1105 Shawmut Ave.

New Bedford, Ma. 02746

Tel: 508-991-6150

Fax: 508-991-6152

**Ronald Labelle
Commissioner**

**Duarte M. Andrade
Acting City Engineer**

To Whom It May Concern:

I Donny Botelho 3504 Road New Bedford ^{MA 02740}, being
(Name) (Mailing Address)

Owner of property located at LOT 156 3504 RD

Plot 121, Lot 156, hereby agree to allow Jose T. de Sousa (J+T Home Bldg)
(Name)

P.O. Box 80038 DARTMOUTH MA 02748 to act on my behalf including affixing my
(Mailing Address)

signature in securing permit for:

☒ Sewer/Drain Service Permits
☒ Water Service Permits
☒ Driveway Installation Permits
☒ Sidewalk Installation Permits

**I further agree to conform to, and abide by, All City rules and ask regulations applicable to
the permit (s) being applied for:**

Name Donny Botelho
Signature

3504 Road New Bedford MA 02740
Address

11/22/10 774 930 2580

SWR-Pl. 10Z-F. on file



Inspector

MIT NO.

24230

CITY OF NEW BEDFORD
SEWER AND/OR STORM DRAIN PERMIT

DATE 11/22/10

Expires: 11/22/11

This certifies that permission is granted to

Donny Botelho

3 Joy Rd.

774-930-2580

Property Owner

Address

Tel.

To connect a sewer and/or storm drain located at 17 Joy Rd.

Assessor's Plot 121 Lot 156, to the sewer and/or storm drain in Joy Rd. Street

To be laid in accordance with the conditions in this application and the City of New Bedford ordinances.

TYPE OF USE: RESIDENTIAL COMMERCIAL INDUSTRIAL FLOW 330 G.P.D.

If applicant other than actual property owner, attach Letter of Authorization from Property Owner.

Name Jose T. de Sousa J.T. Home Builders Tel. 774-930-1024

Mailing Address P.O. Box 80038, Dartmouth, MA 02748

The Bonded Contractor/Drain Layer authorized to perform this work is:

Pico Construction

Name

Address

Tel.

Type of Pipe Required: SDR 35 PVC

PERMIT EXPIRES ONE YEAR AFTER DATE OF ISSUE

- Requires separate connections for sewage and storm drain where applicable. Storm water cannot be discharged to a sanitary sewer.
 - All work must be inspected and approved by a D.P.I. inspector before backfilling.
 - If this connection is to be part of a private service shared jointly with other building owners, attach copy of Recorded Joint Maintenance Agreement.
 - Permits can be issued to Industrial and/or Commercial Applicants only upon receipt and approval by the Commissioner of Public Infrastructure of required plans and supplemental information.
 - In addition, a City-issued Industrial User Discharge Permit and/or a Sewer Extension/Connection Permit issued by the Commonwealth of Massachusetts D.E.P. shall be required by the City for Industrial Discharge into the sewer system.
- Industrial User Discharge Permit No. Date

Comm. Mass. Sewer Conn./Ext. Permit No. Date
A Filing and Inspection Fee of \$450.00 plus an Entrance Fee of \$ where applicable, must accompany this application.

Bank# Bank Five Check# 2545 (2545) Date 11/22/10 Receipt#

Other requirements: 24 hour notice required 508-991-6150

Connection made to Sewer Part of jointly-shared private line YES NO
Storm Drain

Applicant agrees to abide by the above terms, as well as all pertinent ordinances of the City of New Bedford, and such other special rules as the Commissioner of Public Infrastructure and/or City Engineer may deem necessary

City Engineer

Signature of Property Owner or Representative

INSPECTOR'S REPORT

INSPECTED BY:

DATE: 11/23/10

COMMENTS:

APPROVED

DISAPPROVED

SIGNATURE

SKETCH PLAN

Rec'd 11/31/11



CITY OF NEW BEDFORD

NO. 123610LICENSE NO. 060609DATE 7/30 2010

FOUNDATION PERMIT

MSBC Sect. 111.8 – Any permit issued shall be deemed abandoned and invalid unless the work authorized by it shall have been commenced within six (6) months after its issuance.

This certifies that JOE VERISSIMO / DONNY ROTELO, owner/contractor
has permission to install a Foundation
on 17 JOY ROAD P. LOT 156

providing that the person accepting this permit shall in every respect conform to the terms of the application therefor on file in this office; to the provisions of the Statute of the Commonwealth and to the By-Laws of the City of New Bedford relating to the Inspection, Erection, Enlarging, Altering, Raising, Moving, Repairing or Tearing Down of a Building.

WIRING INSPECTOR

PLUMBING INSPECTOR

BUILDING INSPECTOR

ROUGH FINISH

YOUR AREA INSPECTOR IS: _____

– Tel. 979-1540 Between 8:00 AM – 9:00 AM

NOTICE: NOTIFY INSPECTOR 48 HOURS
IN ADVANCE OF APPLYING
SHEATING OR LATHING

OCCUPANCY PERMIT REQUIRED BEFORE OCCUPANCY


No Building or Structure shall be used or occupied until the Certificate of Use and Occupancy shall have been issued by the Building Commissioner – MSBC. Sect. 120.1 – N.B. Zoning Ord. Sect. 9-269

THIS CARD MUST BE DISPLAYED IN A CONSPICUOUS PLACE ON THE PREMISES
AND NOT TORN DOWN OR REMOVED UNTIL COMPLETION OF WORK

SUBJECT TO MASSACHUSETTS STATE
BUILDING CODE REQUIREMENTS

Donny Rotello
BUILDING INSPECTOR

ZUCKERMAN LARAS
For RCD.

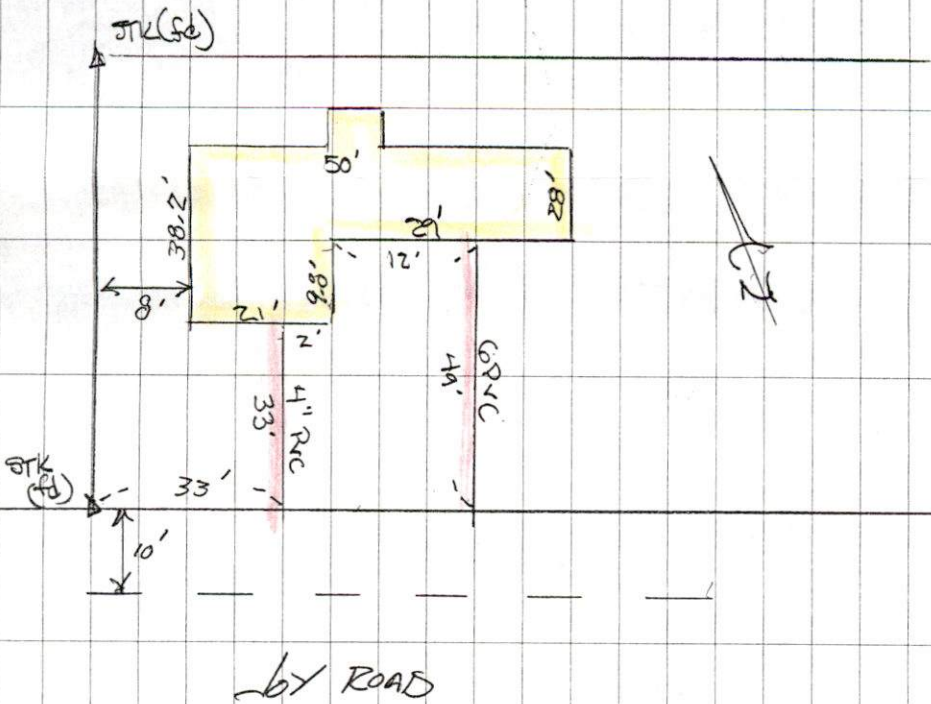

GENERAL 11E-111

CONING PICO CONER.

DATE 11/20/10

INSTR: RODRIGUEZ

PERMIT # 24250

Plot 121 LOT 156

Subdiv Lot # 22