



PERMIT NO.

24231

CITY OF NEW BEDFORD
SEWER AND/OR STORM DRAIN PERMIT

DATE 11-22-10
Expires 11-22-11

This certifies that permission is granted to

Joyce Andre Property Owner PO Box 1645 No. Falmouth MA 02556
Address Tel. 508-563-7550

To connect a sewer and/or storm drain located at 1057 Forbes St.

Assessor's Plot 132 E Lot 9, to the sewer and/or storm drain in Forbes St. Street

To be laid in accordance with the conditions in this application and the City of New Bedford ordinances.

TYPE OF USE: RESIDENTIAL COMMERCIAL INDUSTRIAL FLOW 330 G.P.D.

If applicant other than actual property owner, attach Letter of Authorization from Property Owner.

Name Mailing Address Tel.

The Bonded Contractor/Drain Layer authorized to perform this work is:

Century Paving & Coat 167 Hyacinth St. Fall River MA 02720
Name Address Tel. 508-674-2000
Type of Pipe Required: SDR 35 PVC

PERMIT EXPIRES ONE YEAR AFTER DATE OF ISSUE

- Requires separate connections for sewage and storm drain where applicable. Storm water cannot be discharged to a sanitary sewer.
- All work must be inspected and approved by a D.P.I. inspector before backfilling.
- If this connection is to be part of a private service shared jointly with other building owners, attach copy of Recorded Joint Maintenance Agreement.
- Permits can be issued to Industrial and/or Commercial Applicants only upon receipt and approval by the Commissioner of Public Infrastructure of required plans and supplemental information.
- In addition, a City-issued Industrial User Discharge Permit and/or a Sewer Extension/Connection Permit issued by the Commonwealth of Massachusetts D.E.P. shall be required by the City for Industrial Discharge into the sewer system.

Industrial User Discharge Permit No. Date

Comm. Mass. Sewer Conn./Ext. Permit No. Date

A Filing and Inspection Fee of \$ 450, plus an Entrance Fee of \$ where applicable, must accompany this application.

Bank# Sovereign Bank Check# 1657 Date 11-22-10 Receipt# 9164

Other requirements: 24 hour notice for inspection @ 508-991-6150

Connection made to Sewer Part of jointly-shared private line YES ☒ NO
Storm Drain

Applicant agrees to abide by the above terms, as well as all pertinent ordinances of the City of New Bedford, and such other special rules as the Commissioner of Public Infrastructure and/or City Engineer may deem necessary


Diana M. Andrade
Acting City Engineer

INSPECTOR'S REPORT

INSPECTED BY: [Signature]
DATE: 12/10/10
COMMENTS:

APPROVED ☒ DISAPPROVED ☐

[Signature]
SIGNATURE

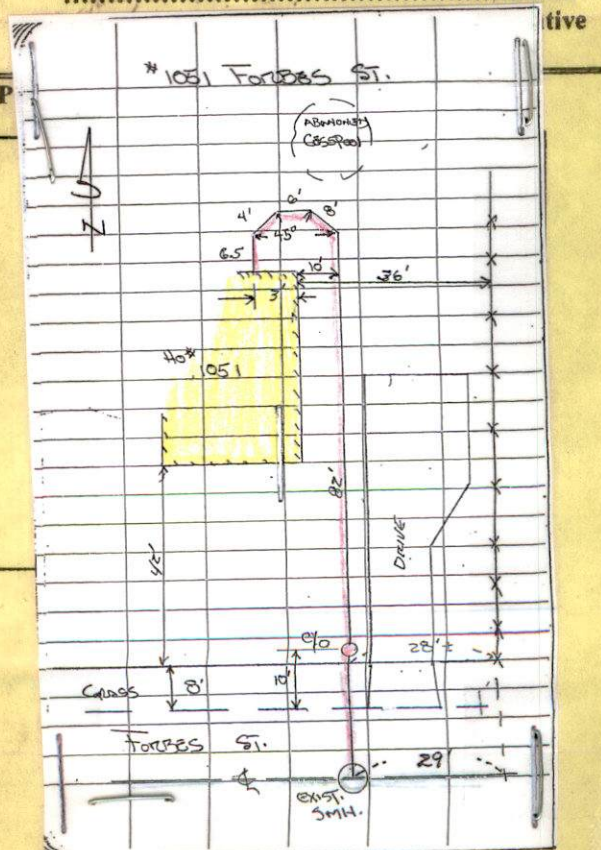



PERMIT NO.

24231

CITY OF NEW BEDFORD
SEWER AND/OR STORM DRAIN PERMIT

DATE 11-22-10

Expires 11-22-11

This certifies that permission is granted to

Joyce Andre PO Box-1645 No. Falmouth, MA 02556
Property Owner Address Tel. 508-563-7560

To connect a sewer and/or storm drain located at 1057 Forbes St.

Assessor's Plot 1321 Lot 9 to the sewer and/or storm drain in Forbes St. Street

To be laid in accordance with the conditions in this application and the City of New Bedford ordinances.

TYPE OF USE: RESIDENTIAL COMMERCIAL INDUSTRIAL FLOW 330 G.P.D.

If applicant other than actual property owner, attach Letter of Authorization from Property Owner.

Name Tel.

Mailing Address

The Bonded Contractor/Drain Layer authorized to perform this work is:

Century Paving & Const. 167 Hyacinth St. Fall River, MA 02720

Name Address Tel. 508-674-2000

Type of Pipe Required: SDR 35 PVC

PERMIT EXPIRES ONE YEAR AFTER DATE OF ISSUE

- Requires separate connections for sewage and storm drain where applicable. Storm water cannot be discharged to a sanitary sewer.
- All work must be inspected and approved by a D.P.I. inspector before backfilling.
- If this connection is to be part of a private service shared jointly with other building owners, attach copy of Recorded Joint Maintenance Agreement.
- Permits can be issued to Industrial and/or Commercial Applicants only upon receipt and approval by the Commissioner of Public Infrastructure of required plans and supplemental information.
- In addition, a City-issued Industrial User Discharge Permit and/or a Sewer Extension/Connection Permit issued by the Commonwealth of Massachusetts D.E.P. shall be required by the City for Industrial Discharge into the sewer system.

Industrial User Discharge Permit No. Date

Comm. Mass. Sewer Conn./Ext. Permit No. Date

A Filing and Inspection Fee of \$ 450, plus an Entrance Fee of \$ where applicable, must accompany this application.

Bank# Sovereign Bank Check# 1657 Date 11-22-10 Receipt# 9164

Other requirements: 24 hour notice for inspection @ 508-991-6150

Sketches to Preservation Commission approved

Connection made to Sewer Part of jointly-shared private line YES ☒ NO
Storm Drain

Applicant agrees to abide by the above terms, as well as all pertinent ordinances of the City of New Bedford, and such other special rules as the Commissioner of Public Infrastructure and/or City Engineer may deem necessary

Duarte M. Andrade
Acting City Engineer

Joyce R. Andre
Signature of Property Owner or Representative

INSPECTOR'S REPORT

INSPECTED BY: [Signature]
DATE: 12/10/10
COMMENTS:

APPROVED

DISAPPROVED

SIGNATURE

DPI/ENGR

SKETCH PLAN

No. 10-08

FEE 50.00

COMMONWEALTH OF MASSACHUSETTS

Board of Health, New Bedford, MA.

DISPOSAL SYSTEM CONSTRUCTION PERMIT

Permission is hereby granted to; Construct(☒) Repair(☐) Upgrade(☐) Abandon(☐) an individual sewage disposal system
at 1057 Forbes ST
Disposal System Construction Permit No. 10-08, dated 11/23/10 as described in the application for

Provided: Construction shall be completed within three years of the date of this permit. All local conditions must be met.

Form 1255 Rev. 5/96 A.M. Sulkin Co. Boston, MA

Date 11/23/10 Board of Health [Signature]

PHONE CALL

FOR ~~Michael~~ DATE 11/16/10 TIME 7:55 A.M. P.M.

M. Joyce Andre

OF 1057 Forbes St.

PHONE 508-563-7550

AREA CODE

NUMBER

EXTENSION

MESSAGE Wants to Tie in

to City Sewer -

P 132 I P 9

☒ PHONED

RETURNED
YOUR CALL

PLEASE CALL

WILL CALL
AGAIN

CAME TO
SEE YOU

WANTS TO
SEE YOU

SIGNED

Uuniversal 48003

Carol Sherman

To: Sarah Porter
Subject: RE: SEWER TIE-IN

THANK YOU

WHEN SHE COMES BACK WITH HER SEPTIC REMOVAL CERTIFICATE –I WILL EXPLAIN THAT TO HER

CAROL

From: Sarah Porter
Sent: Monday, November 22, 2010 10:01 AM
To: Carol Sherman
Subject: RE: SEWER TIE-IN

Carol, I have been away, she has wetlands in the back of her property, have the contractor send me a sketch of where he is going to tie in so we don't have any problems.

Thank you

Sarah

From: Carol Sherman
Sent: Tuesday, November 16, 2010 8:40 AM
To: Sarah Porter
Subject: SEWER TIE-IN

SARAH

JOYCE ANDRE, OWNER OF 1057 FORBES ST IS SELLING HOUSE, TITLE V FAILED. WOULD LIKE TO TIE-IN TO CITY SEWER SYSTEM.

PLEASE LET ME KNOW IF OK TO GIVE HER A SEWER PERMIT

THANKS

CAROL

Joyce Andre and Charles Moniz
POBox 1645
North Falmouth, MA 02556
508-563-7550
Bmii30@aol.com

November 16, 2010

Commissioner Ronald Labelle
1105 Shawmut Ave.
New Bedford, MA 02746

Dear Mr. Labelle,

We are property owners of 1057 Forbes St., New Bedford. The property is for sale and the septic system has failed Title 5 inspection. We are requesting an extension of the date to open the street to tie into the city sewer system as we would like to have this done as soon as possible. Your attention to this matter is greatly appreciated.

Sincerely,

Joyce Andre and Charles Moniz



11/18/10 Michele Called homeowner, OK to Connect to City sewer system.
Needs Abandonment of Septic System Permit, also emailed Sarah
Porter for Wetlands. Bonded Contractor is to follow winter
rules + sign form.



INVOICE

40 Jacqueline Ln.
Plymouth, Ma. 02360
Phone (508) 747.0611 Fax (508) 747.0611

INVOICE #

TO: MANNY ANGE
1057 FRAGS ST.
NEW BEDFORD, MA

COMMENTS OR SPECIAL INSTRUCTIONS:

SYSTEM FAILS - \$50 BAL DUE IF PARLAWORK IS NEEDED

INSPECTOR	INVOICE NUMBER	TYPE OF SERVICE	DATE OF SERVICE	TIME OF SERVICE	PAYMENT TERMS
Mark J. Nardone			10/30/10		Due on receipt

QUANTITY	DESCRIPTION OF SERVICES	PRICE	TOTAL
	VOLUNTARY INSPECTION		150 -
		SUBTOTAL	150 -
		ADDITIONAL TAX	
		MISC. EXPENSES	
		TOTAL DUE	

Make all checks payable to **Bridge Home and Septic**
If you have any questions concerning this invoice, contact Mark J. Nardone
(508)269.0583 or mnardone@bridgehomeandseptic.com
Thank you for your business!

Make all checks payable to **Bridge Home and Septic**
If you have any questions concerning this invoice, contact Mark J. Nardone
(508)269.0583 or mnardone@bridgehomeandseptic.com
Thank you for your business!

PAID CASH
(M)

Carol Sherman

To: Sarah Porter
Subject: RE: 1057 Forbes Street

THANK YOU


HAPPY THANKSGIVING TO YOU ALSO

CAROL

-----Original Message-----

From: Sarah Porter
Sent: Wednesday, November 24, 2010 11:15 AM
To: Carol Sherman; Cheveli A. Torres
Subject: 1057 Forbes Street

Carol & Chevel,
The contractor just dropped off the sketches for 1057 Forbes st. so the sewer permit can be issued now Thank you Have a Wonderful Thanksgiving Sarah

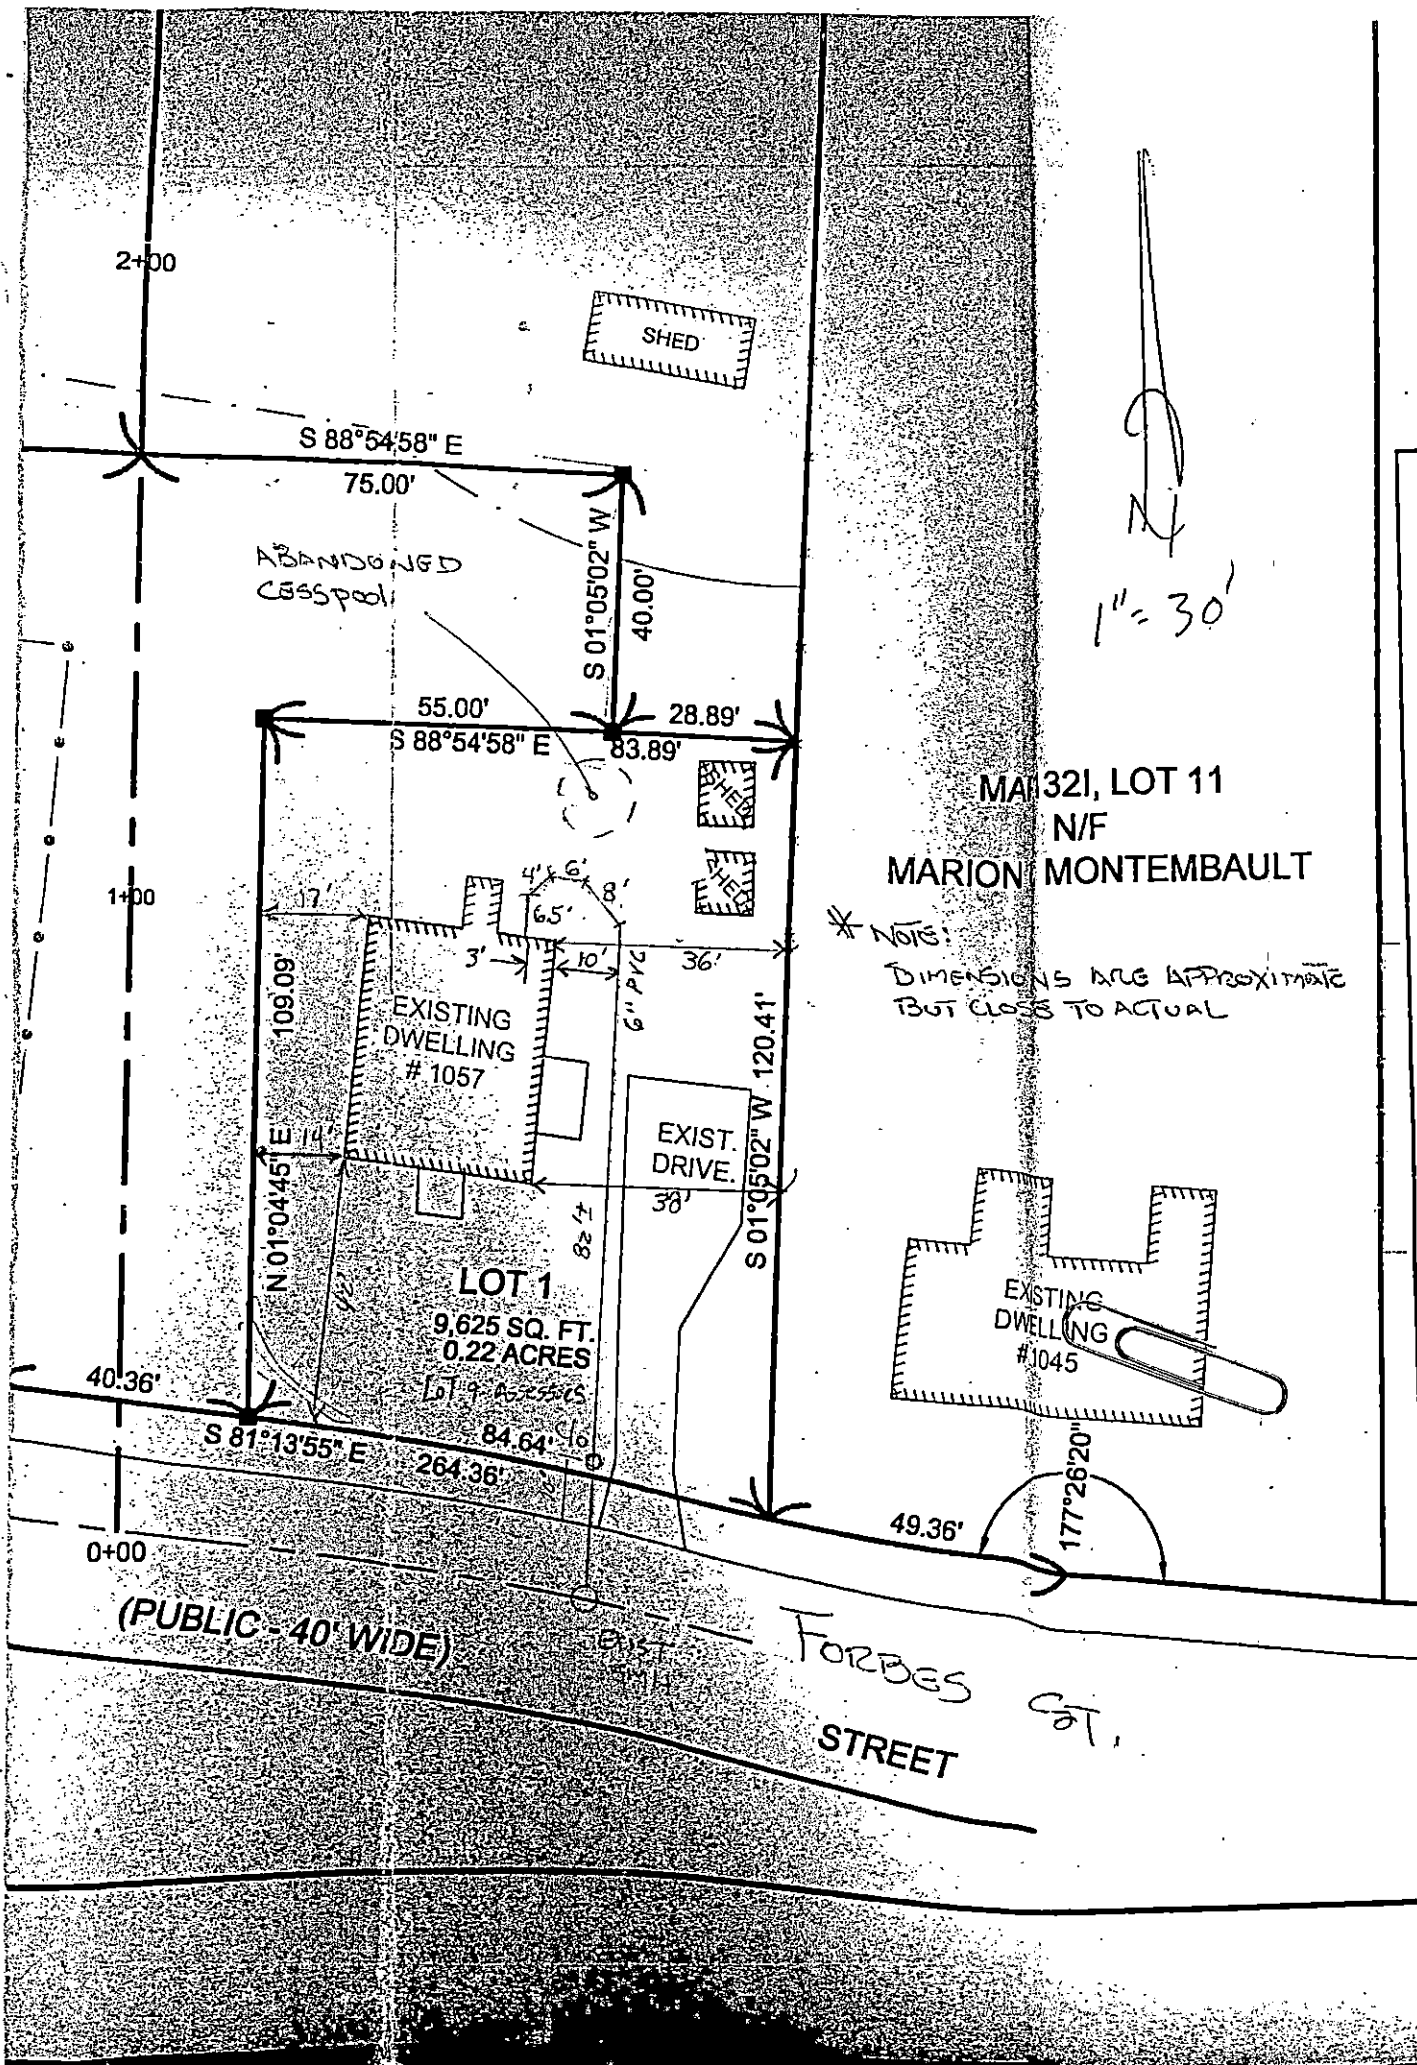


1" = 30'

MAP 321, LOT 11
N/F
MARION MONTEBAULT

* NOTE:
DIMENSIONS ARE APPROXIMATE
BUT CLOSE TO ACTUAL

1051 FORBES ST.

(ABANDONED
CESSPOOL)

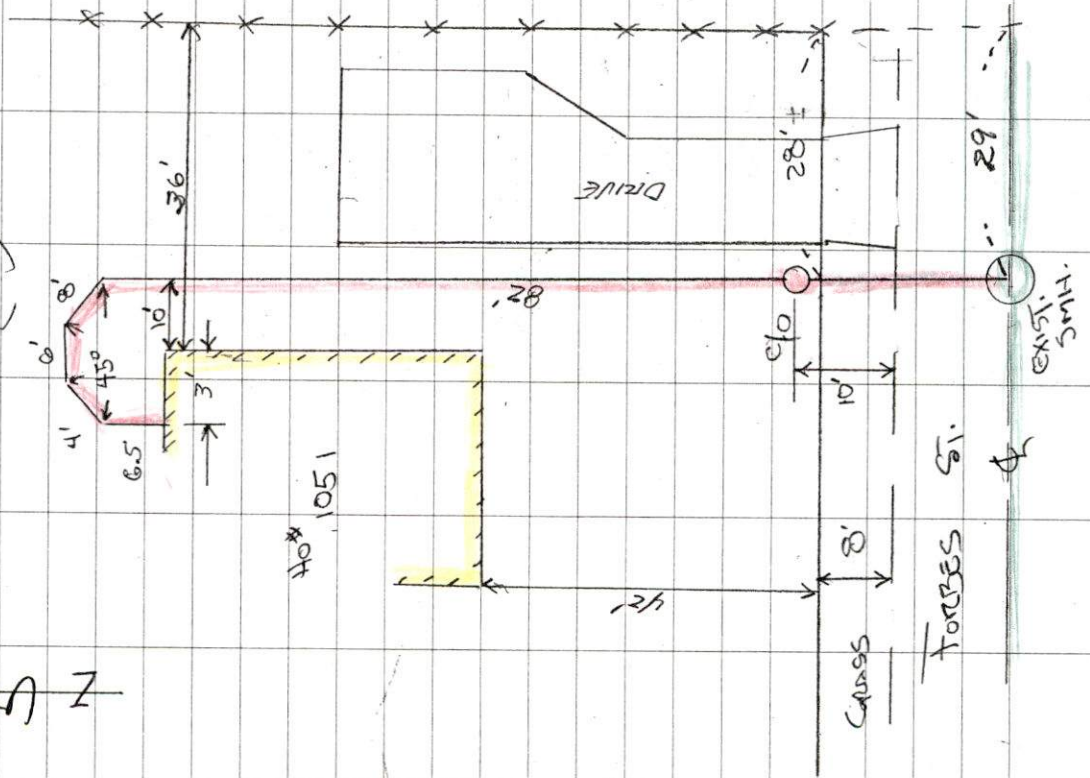

(61)

SEWER 18-IN

FORMER CESSPOOL DISPOSAL

DATE: 12/10/10

INSPECTION: REBEKAH NOVAK



CONTRACTOR: CENTURY PAVING

CONTRACT - DAN

PERMIT # 24231

PLOT 1321 LOT 9

* NOTE: ALL DIMENSIONS ARE APPROXIMATING BUT CLOSE TO ACTUAL *

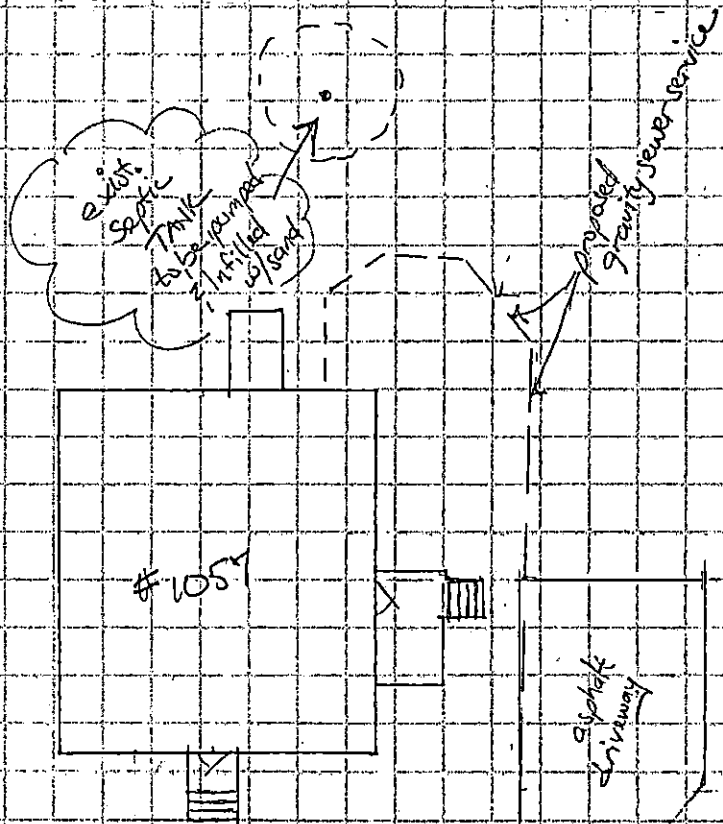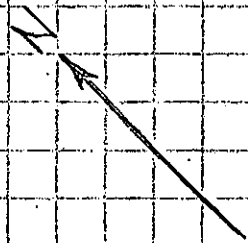

Scale 1" = 20'

Forbes Rd.