



PERMIT NO.
24235

CITY OF NEW BEDFORD
SEWER AND/OR STORM DRAIN PERMIT

1/26/11
EXP 1/20/12
DATE 1/26/11

This certifies that permission is granted to

BRADLEY NORTH REALTY TRUST / MICHAEL F. ADAMOWSKI, TRS.

Property Owner

Address

2284 PHILLIPS RD.

Tel. 508-992-5454

To connect a sewer and/or storm drain located at... BRADLEY RD. (E.D.) 320' +/- N.Y. HIGH RIVER BLVD.

Assessor's Plot 136 Lot 523 to the sewer and/or storm drain in... BRADLEY RD. 1011 SEWER Street

To be laid in accordance with the conditions in this application and the City of New Bedford ordinances.

TYPE OF USE: RESIDENTIAL COMMERCIAL INDUSTRIAL FLOW 330 G.P.D.

If applicant other than actual property owner, attach Letter of Authorization from Property Owner.

Name... LINDA PATRICK IDEM DEV CORP. Tel. (508) 993-0381

Mailing Address... 10 LAMBERT ST.

The Bonded Contractor/Drain Layer authorized to perform this work is:

R.J. MESSA EXCAVATING, P.O. BOX 51643, NEW BEDFORD, MA 02715 (508) 998-3404

Name

Address

Tel.

Type of Pipe Required: PVC SDR 35

PERMIT EXPIRES ONE YEAR AFTER DATE OF ISSUE

- Requires separate connections for sewage and storm drain where applicable. Storm water cannot be discharged to a sanitary sewer.
- All work must be inspected and approved by a D.P.I. inspector before backfilling.
- If this connection is to be part of a private service shared jointly with other building owners, attach copy of Recorded Joint Maintenance Agreement.
- Permits can be issued to Industrial and/or Commercial Applicants only upon receipt and approval by the Commissioner of Public Infrastructure of required plans and supplemental information.
- In addition, a City-issued Industrial User Discharge Permit and/or a Sewer Extension/Connection Permit issued by the Commonwealth of Massachusetts D.E.P. shall be required by the City for Industrial Discharge into the sewer system.

Industrial User Discharge Permit No. N/A Date

Comm. Mass. Sewer Conn./Ext. Permit No. Date

A Filing and Inspection Fee of \$450, plus an Entrance Fee of \$100 where applicable, must accompany this application.

Bank# WEBSTER BANK Check# 5555 Date 1/19/11 Receipt# 9198

Other requirements: MUST RETAIN STORM WATER ON SITE - CANNOT DISCHARGE INTO

ABUTTING PROP. OR ROADWAY. CANNOT CONNECT INTO STORM DRAIN IN ROADWAY - MUST DO ON-SITE INFILTRATION SYSTEM & RECHARGE INTO GROUND. CALL 211 FOR ADVANCE FOR INSPECTION.

Connection made to Sewer Part of jointly-shared private line YES NO ADVANCE FOR INSPECTION.
Storm Drain

Applicant agrees to abide by the above terms, as well as all pertinent ordinances of the City of New Bedford, and such other special rules as the Commissioner of Public Infrastructure and/or City Engineer may deem necessary

David M. Andrade, Esq.
ACTING City Engineer

Signature of Property Owner or Representative


INSPECTOR'S REPORT

INSPECTED BY: (Signature)
DATE: 5/10/11
COMMENTS:

APPROVED

DISAPPROVED

SIGNATURE

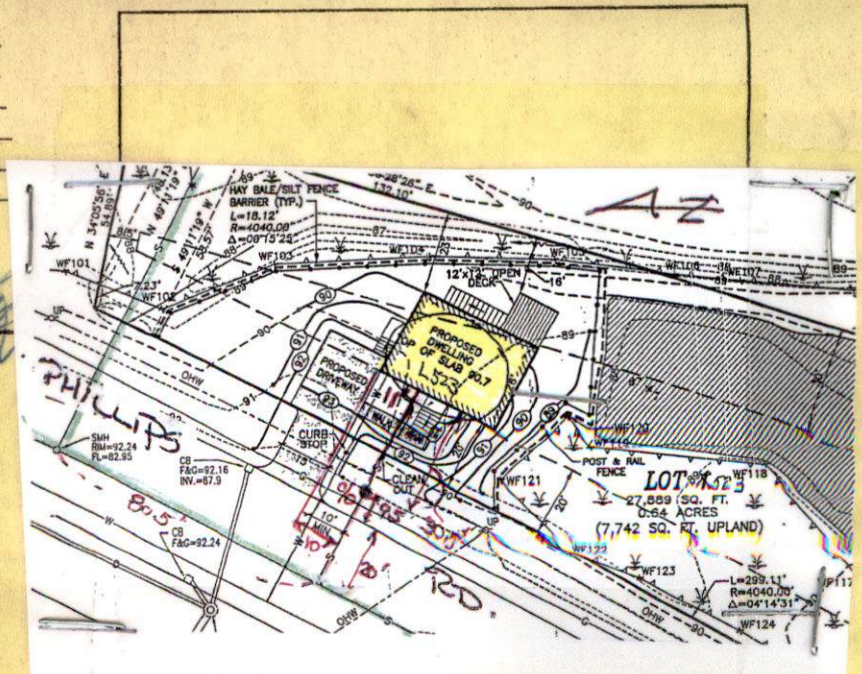



PERMIT NO.
24235

CITY OF NEW BEDFORD
SEWER AND/OR STORM DRAIN PERMIT

1/26/11
EXP #1202
DATE #1/20/11
1/26/11

This certifies that permission is granted to

BRADLEY NORTH REALTY TRUST / MICHAEL F. ADAMOWSKI, TRS.

SPM DEVELOPMENT CORP. 70 LAMBERT ST. NB

(508) 993-0381

Property Owner

Address

2284 PHILLIPS RD

Tel. 508-992-5454

To connect a sewer and/or storm drain located at BRADLEY RD. (E.S.) 320' +/- N.Y. THEO. RICE BLVD.

Assessor's Plot 136 Lot 523 to the sewer and/or storm drain in BRADLEY RD. 10" SEWER Street

To be laid in accordance with the conditions in this application and the City of New Bedford ordinances.

TYPE OF USE: RESIDENTIAL COMMERCIAL INDUSTRIAL FLOW 330 G.P.D.

If applicant other than actual property owner, attach Letter of Authorization from Property Owner.

Name LINO PEREIRA / DPM DEV. CORP.

Tel. (508) 993-0381

Mailing Address 70 LAMBERT ST.

The Bonded Contractor/Drain Layer authorized to perform this work is:

R.J. CANESSA EXCAVATING PO BOX 51643 NB MA 02745

(508) 998-3404

Name

Address

Tel.

Type of Pipe Required: PVC SDR 35

PERMIT EXPIRES ONE YEAR AFTER DATE OF ISSUE

- Requires separate connections for sewage and storm drain where applicable. Storm water cannot be discharged to a sanitary sewer.
- All work must be inspected and approved by a D.P.I. inspector before backfilling.
- If this connection is to be part of a private service shared jointly with other building owners, attach copy of Recorded Joint Maintenance Agreement.
- Permits can be issued to Industrial and/or Commercial Applicants only upon receipt and approval by the Commissioner of Public Infrastructure of required plans and supplemental information.
- In addition, a City-issued Industrial User Discharge Permit and/or a Sewer Extension/Connection Permit issued by the Commonwealth of Massachusetts D.E.P. shall be required by the City for Industrial Discharge into the sewer system.

Industrial User Discharge Permit No. N/A Date

Comm. Mass. Sewer Conn./Ext. Permit No. Date

A Filing and Inspection Fee of \$450., plus an Entrance Fee of \$0. where applicable, must accompany this application.

Bank# WEBSTER BANK Check# 5555 Date 1/19/2011 Receipt# 9198

Other requirements: MUST RETAIN STORM WATER ON SITE - CANNOT DISCHARGE INTO

ABUTTING PROP. OR ROADWAY. CANNOT CONNECT INTO STORM DRAIN IN ROADWAY - MUST

DO ON-SITE INFILTRATION SYSTEM & RECHARGE INTO GROUND. CALL 24 HRS IN

Connection made to

Part of jointly-shared private line

YES ☒

NO ☐ ADVANCE FOR INSPECTION.

Storm Drain

Applicant agrees to abide by the above terms, as well as all pertinent ordinances of the City of New Bedford, and such other special rules as the Commissioner of Public Infrastructure and/or City Engineer may deem necessary

Duarte M. Andrade
ACTING City Engineer

Michael F. Adamowski
Signature of Property Owner or Representative

INSPECTOR'S REPORT

INSPECTED BY: RD

DATE: 5/10/11

COMMENTS:

☒ APPROVED

☐ DISAPPROVED

Michael F. Adamowski
SIGNATURE

SKETCH PLAN



**CITY OF NEW BEDFORD
MASSACHUSETTS**

DEPARTMENT OF PUBLIC WORKS
ENGINEERING DIVISION
133 WILLIAM STREET, ROOM 303
NEW BEDFORD, MA 02740
Tel: (508) 979-1527
Fax: (508) 961-3043

To Whom It May Concern:

I, MICHAEL ADAMOWSKI TRUSTEE FOR BRALEY NORTH REALTY TRUST, being
(Name) (Mailing Address) 70 LAMBETH ST. NEW BEDFORD MA 02745

Owner of property located at BRALEY ROAD, NEW BEDFORD

Plot 136, Lot 523, hereby agree to allow LIND PEREIRA
(Name)

70 LAMBETH ST. N.B. MA 02745 to act on my behalf including affixing my
(Mailing Address)

signature in securing permit for:

☒ Sewer/Drain Service Permits
☒ Water Service Permits
☒ Driveway Installation Permits
☐ Sidewalk Installation Permits

I further agree to conform to, and abide by, all City rules and ask regulations applicable to the permit (s) being applied for:

Name

(Signature)

816 POTOMSKA RD DARTMOUTH MA 02748
(Address)

1-25-11
(Date)

508 992-5476
(Telephone number)



CITY OF NEW BEDFORD

NO. 116410LICENSE NO. 66798DATE 7/20 20 10

FOUNDATION PERMIT

MSBC Sect. 111.8 – Any permit issued shall be deemed abandoned and invalid unless the work authorized by it shall have been commenced within six (6) months after its issuance.

This certifies that DPM Development owner/contractor
has permission to install foundation 26' x 36'
on Bialy Rd. Plot 136, Lot 523

providing that the person accepting this permit shall in every respect conform to the terms of the application therefor on file in this office; to the provisions of the Statute of the Commonwealth and to the By-Laws of the City of New Bedford relating to the Inspection, Erection, Enlarging, Altering, Raising, Moving, Repairing or Tearing Down of a Building.

WIRING INSPECTOR

PLUMBING INSPECTOR

BUILDING INSPECTOR

YOUR AREA INSPECTOR IS:

Thomas Welch

ROUGH FINISH

– Tel. 979-1540 Between 8:00 AM – 9:00 AM

NOTICE: NOTIFY INSPECTOR 48 HOURS
IN ADVANCE OF APPLYING
SHEATING OR LATHING


OCCUPANCY PERMIT REQUIRED BEFORE OCCUPANCY

No Building or Structure shall be used or occupied until the Certificate of Use and Occupancy shall have been issued by the Building Commissioner – MSBC. Sect. 120.1 – N.B. Zoning Ord. Sect. 9-269

THIS CARD MUST BE DISPLAYED IN A CONSPICUOUS PLACE ON THE PREMISES
AND NOT TORN DOWN OR REMOVED UNTIL COMPLETION OF WORK

SUBJECT TO MASSACHUSETTS STATE
BUILDING CODE REQUIREMENTS

Dan Romanoski
BUILDING INSPECTOR

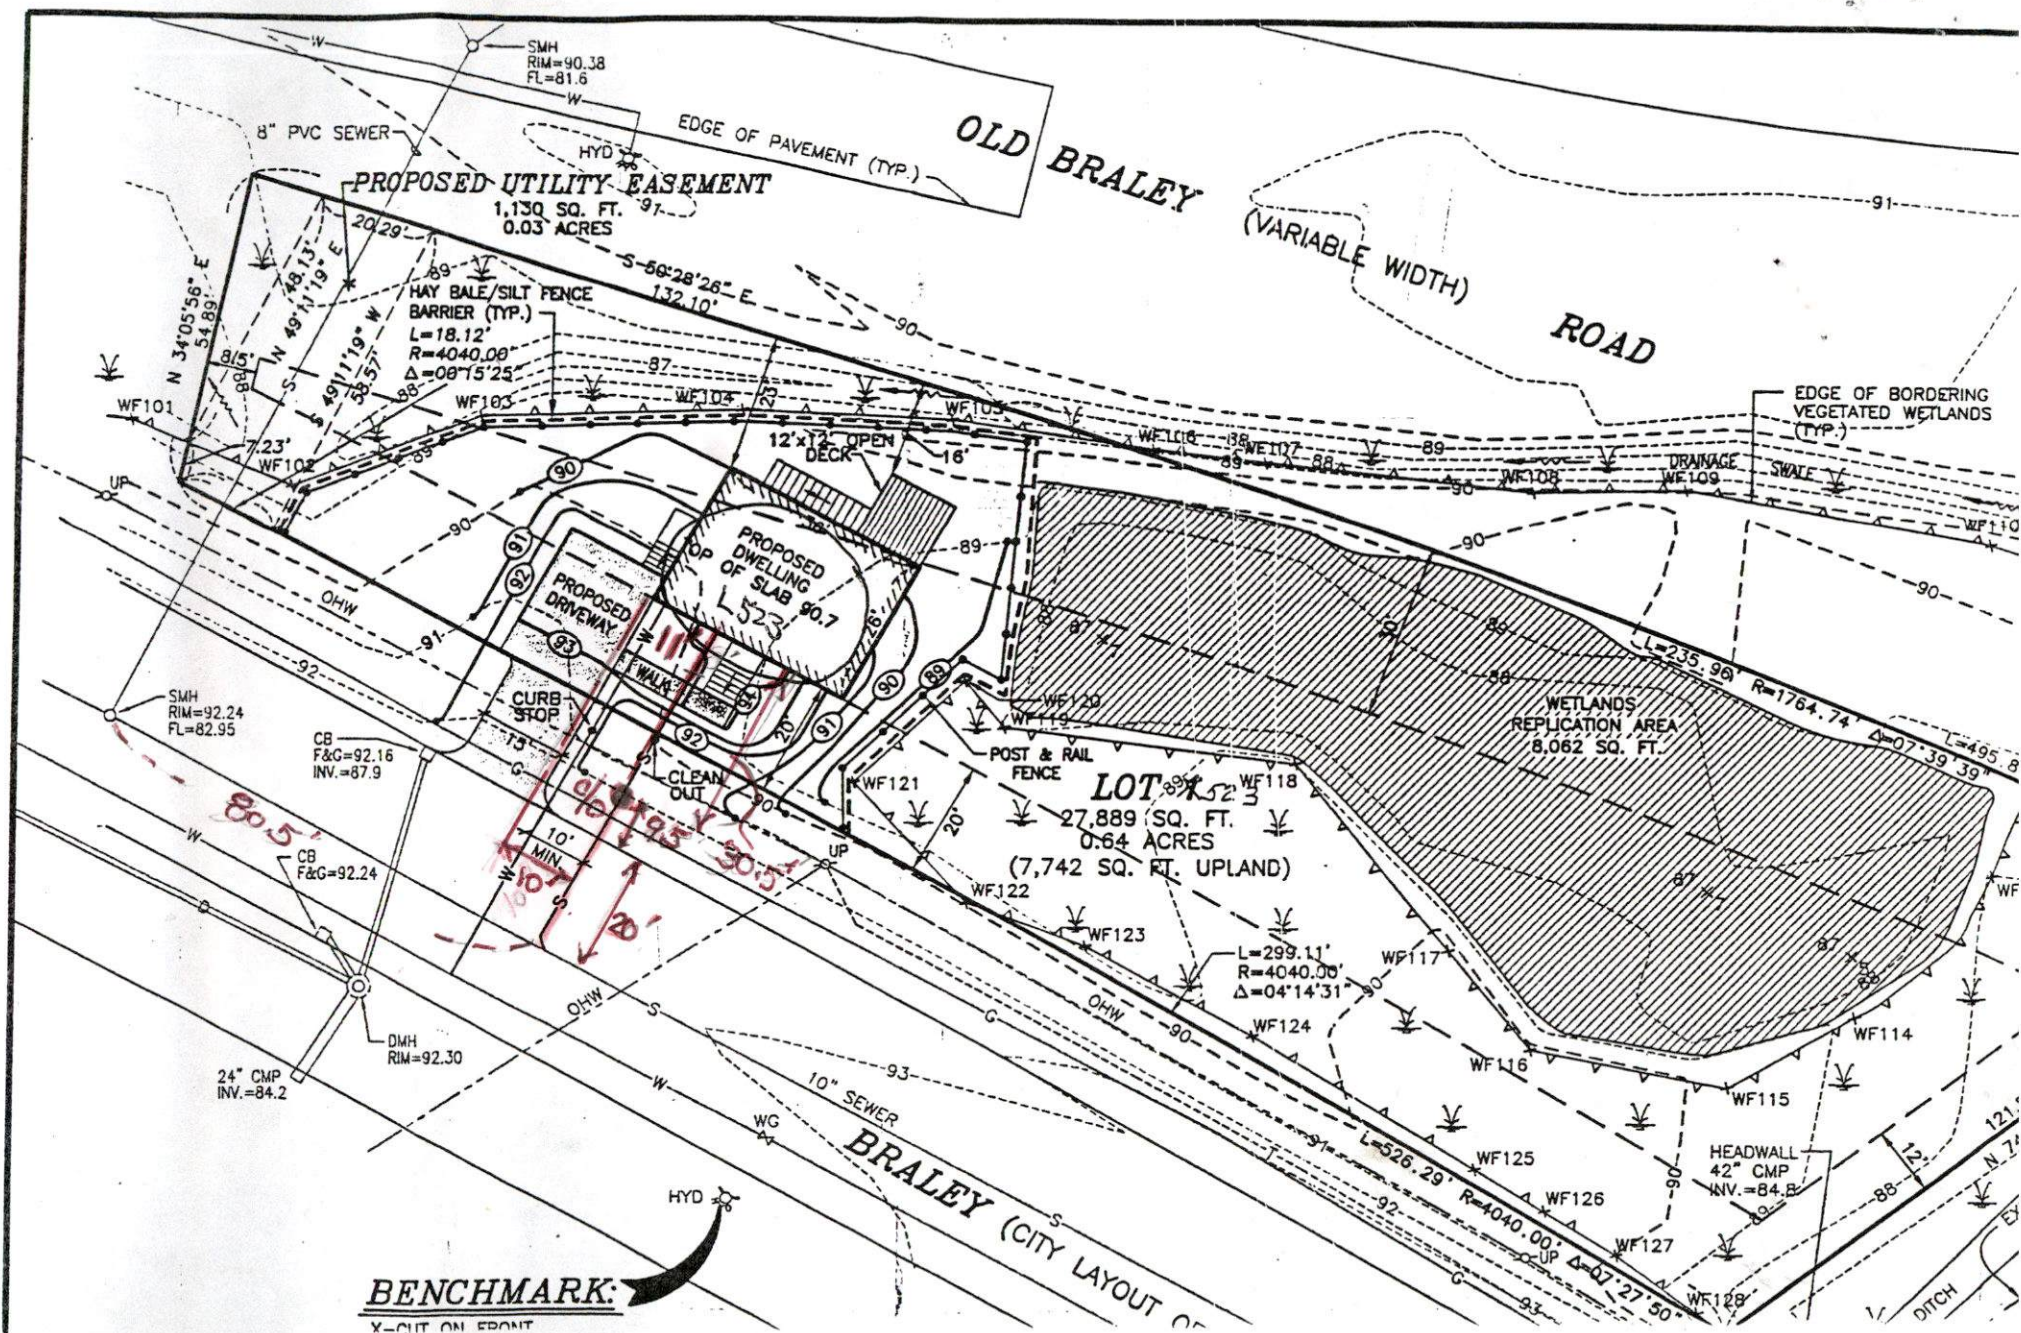

24235