



PERMIT NO.
24255

CITY OF NEW BEDFORD
SEWER AND/OR STORM DRAIN PERMIT

DATE 8-17-11
Exp. 8-17-12

This certifies that permission is granted to

P.M. Development 70 Lambeth St. New Bedford, MA 02745
Property Owner Address Tel. 508-993-0381

To connect a sewer and/or storm drain located at Barnum St. E X Morris St.
Assessor's Plot 130D Lot....., to the sewer and/or storm drain in extend 2" Force Main (sewer)
extend 12" Storm drain 270'.....Street
extend 15" Storm drain 234'

To be laid in accordance with the conditions in this application and the City of New Bedford ordinances.

TYPE OF USE: RESIDENTIAL COMMERCIAL INDUSTRIAL FLOW — G.P.D.

If applicant other than actual property owner, attach Letter of Authorization from Property Owner.

Name..... Tel.....
Mailing Address.....

The Bonded Contractor/Drain Layer authorized to perform this work is:

P.M. Development 70 Lambeth St. New Bedford, MA 02745
Name Address Tel. 508-993-0381
Type of Pipe Required: per submitted plan attached plan

PERMIT EXPIRES ONE YEAR AFTER DATE OF ISSUE

- Requires separate connections for sewage and storm drain where applicable. Storm water cannot be discharged to a sanitary sewer.
- All work must be inspected and approved by a D.P.I. inspector before backfilling.
- If this connection is to be part of a private service shared jointly with other building owners, attach copy of Recorded Joint Maintenance Agreement.
- Permits can be issued to Industrial and/or Commercial Applicants only upon receipt and approval by the Commissioner of Public Infrastructure of required plans and supplemental information.
- In addition, a City-issued Industrial User Discharge Permit and/or a Sewer Extension/Connection Permit issued by the Commonwealth of Massachusetts D.E.P. shall be required by the City for Industrial Discharge into the sewer system.

Industrial User Discharge Permit No..... Date.....

Comm. Mass. Sewer Conn./Ext. Permit No..... Date.....

A Filing and Inspection Fee of \$ 450, plus an Entrance Fee of \$..... where applicable, must accompany this application.
Sewer & Storm Drain Ext. 4316.00 Total 4,766.00

Bank# Webster Bank Check# 5669 Date 8/17/11 Receipt# 8992

Other requirements: 24 hour inspection notice @ 508-991-6150

must adhere to State requirements for a sewer extension under
Extension 1000'

Connection made to Sewer Part of jointly-shared private line YES ☒ NO

Extension Storm Drain


Applicant agrees to abide by the above terms, as well as all pertinent ordinances of the City of New Bedford, and such other special rules as the Commissioner of Public Infrastructure and/or City Engineer may deem necessary

Duarte M. Andrade Rosa M...
City Engineer Signature of Property Owner or Representative

INSPECTED BY: _____
DATE: _____
COMMENTS: _____

APPROVED _____ DISA _____

SIGNATURE _____

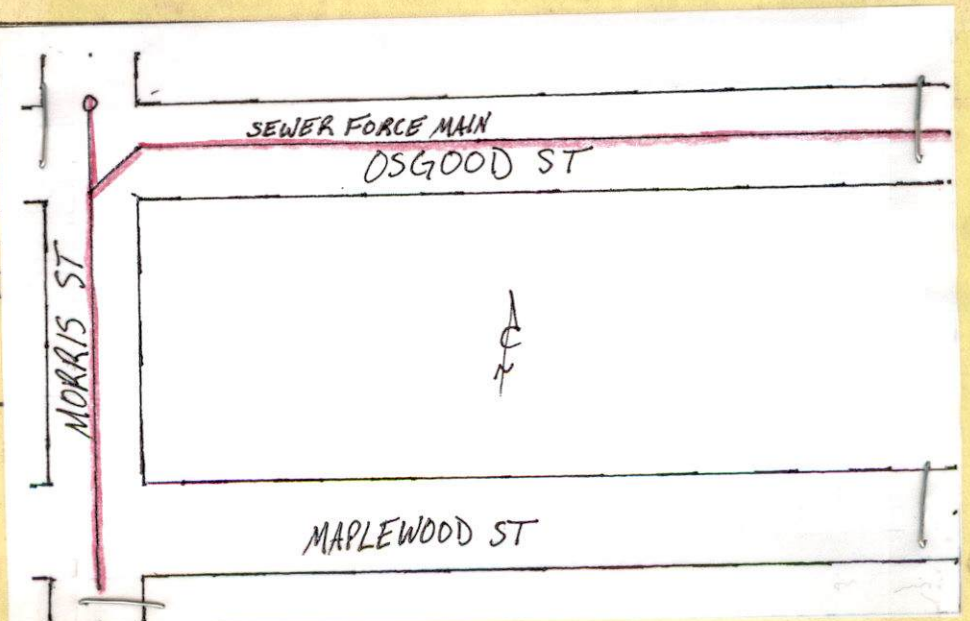

ALSO SEE WHITE SHEET SKETCH



Inspector

PERMIT NO.

24255

CITY OF NEW BEDFORD
SEWER AND/OR STORM DRAIN PERMIT

DATE 8-17-11
Exp. 8-17-12

This certifies that permission is granted to

D.P.M. Development 70 Lambeth St. New Bedford, MA 02745
Property Owner Address Tel. 508-993-0381

To connect a sewer and/or storm drain located at Barnum St. E. X. Morris St.
Assessor's Plot 134 D Lot, to the sewer and/or storm drain in extend 5" Force Main (sewer)
extend 12" Storm drain 770' Street
extend 15" Storm drain 234'

To be laid in accordance with the conditions in this application and the City of New Bedford ordinances.

TYPE OF USE: RESIDENTIAL COMMERCIAL INDUSTRIAL FLOW — G.P.D.

If applicant other than actual property owner, attach Letter of Authorization from Property Owner.

Name Mailing Address Tel.

The Bonded Contractor/Drain Layer authorized to perform this work is:

D.P.M. Development 70 Lambeth St. New Bedford, MA 02745
Name Address Tel. 508-993-0381

Type of Pipe Required: per submitted plan per attached plan

PERMIT EXPIRES ONE YEAR AFTER DATE OF ISSUE

- Requires separate connections for sewage and storm drain where applicable. Storm water cannot be discharged to a sanitary sewer.
 - All work must be inspected and approved by a D.P.I. inspector before backfilling.
 - If this connection is to be part of a private service shared jointly with other building owners, attach copy of Recorded Joint Maintenance Agreement.
 - Permits can be issued to Industrial and/or Commercial Applicants only upon receipt and approval by the Commissioner of Public Infrastructure of required plans and supplemental information.
 - In addition, a City-issued Industrial User Discharge Permit and/or a Sewer Extension/Connection Permit issued by the Commonwealth of Massachusetts D.E.P. shall be required by the City for Industrial Discharge into the sewer system.
- Industrial User Discharge Permit No. Date.

Comm. Mass. Sewer Conn./Ext. Permit No. Date.

A Filing and Inspection Fee of \$450, plus an Entrance Fee of \$, where applicable, must accompany this application.

Sewer & Storm Drain Ext. 4316.00 Total 4,766.00
Bank# Webster Bank Check# 5669 Date 8/17/11 Receipt# 8992

Other requirements: 24 hour inspection notice @ 508-991-6150

must adhere to State requirements for a sewer extension under 1000'

Extension Sewer Connection made to Part of jointly-shared private line YES NO
Extension Storm Drain

Applicant agrees to abide by the above terms, as well as all pertinent ordinances of the City of New Bedford, and such other special rules as the Commissioner of Public Infrastructure and/or City Engineer may deem necessary


Duane M. Andrade
City Engineer

Rosa Amory
Signature of Property Owner or Representative

INSPECTOR'S REPORT

INSPECTED BY: [Signature]
DATE: 9/20/11
COMMENTS:

APPROVED DISAI
[Signature]
SIGNATURE

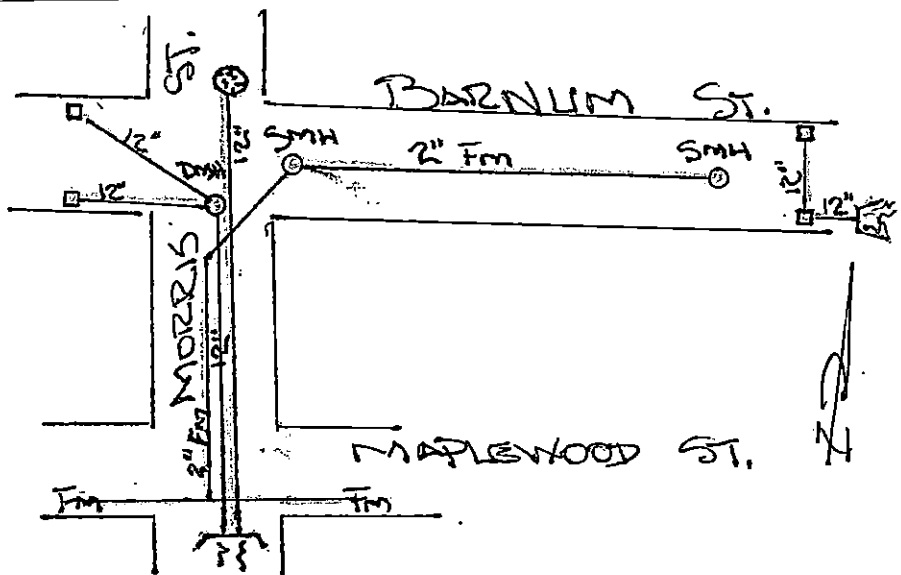



PERMIT NO.

24255

CITY OF NEW BEDFORD
SEWER AND/OR STORM DRAIN PERMIT

DATE 8-17-11
Exp. 8-17-12

This certifies that permission is granted to

D.P.M. Development 70 Lambeth St. New Bedford, MA 02745
Property Owner Address Tel. 508-993-0381

To connect a sewer and/or storm drain located at... Barnum St. E. X. Morris St.
Assessor's Plot 130 D Lot....., to the sewer and/or storm drain in... extend 2" Force Main (sewer)
extend 12" Storm drain 270' Street
extend 15" Storm drain 234'

To be laid in accordance with the conditions in this application and the City of New Bedford ordinances.

TYPE OF USE: RESIDENTIAL COMMERCIAL INDUSTRIAL FLOW — G.P.D.

If applicant other than actual property owner, attach Letter of Authorization from Property Owner.

Name..... Tel.....
Mailing Address.....

The Bonded Contractor/Drain Layer authorized to perform this work is:

D.P.M. Development 70 Lambeth St. New Bedford, MA 02745
Name Address Tel. 508-993-0381
Type of Pipe Required: per submitted plan per attached plan

PERMIT EXPIRES ONE YEAR AFTER DATE OF ISSUE

- Requires separate connections for sewage and storm drain where applicable. Storm water cannot be discharged to a sanitary sewer.
- All work must be inspected and approved by a D.P.I. inspector before backfilling.
- If this connection is to be part of a private service shared jointly with other building owners, attach copy of Recorded Joint Maintenance Agreement.
- Permits can be issued to Industrial and/or Commercial Applicants only upon receipt and approval by the Commissioner of Public Infrastructure of required plans and supplemental information.
- In addition, a City-issued Industrial User Discharge Permit and/or a Sewer Extension/Connection Permit issued by the Commonwealth of Massachusetts D.E.P. shall be required by the City for Industrial Discharge into the sewer system.

Industrial User Discharge Permit No..... Date.....

Comm. Mass. Sewer Conn./Ext. Permit No..... Date.....

A Filing and Inspection Fee of \$450, plus an Entrance Fee of \$..... where applicable, must accompany this application.
Sewer & Storm Drain Ext. 4316.00 Total 4,766.00

Bank# Webster Bank Check# 5669 Date 8/17/11 Receipt# 8992

Other requirements: 24 hour inspection notice @ 508-991-6150

must adhere to State requirements for a sewer extension under 1000'

Extension Sewer Connection made to Part of jointly-shared private line YES (NO)

Extension Storm Drain

Applicant agrees to abide by the above terms, as well as all pertinent ordinances of the City of New Bedford, and such other special rules as the Commissioner of Public Infrastructure and/or City Engineer may deem necessary

Duarte M. Andrade
City Engineer

Rose M. Mory
Signature of Property Owner or Representative

INSPECTOR'S REPORT

INSPECTED BY: _____
DATE: _____
COMMENTS: _____

APPROVED DISAPPROVED

SIGNATURE

SKETCH PLAN

2/8/11

Barnum St. Extension

Sewer:

$$2'' \text{ Force main : } 350' + 35' + 190' = 575'$$

Drainage:

$$12'' \text{ main : } 20' + 30' + 210' = 270'$$

$$15'' \text{ main : } 234' = 234'$$

$$\text{Total } \underline{1,079'}$$

$$\text{Sewer Permit : } 1079' \times \$4.450.0 = \$4,316.0$$

\$4,766.00

Water:

$$8'' \text{ water main : } 390'$$

$$\text{Water Permit : } 390' \times \$4.450.0 = \$1,560.0$$

\$2,010.00

Receipt No. 08992

CITY OF NEW BEDFORD
DEPARTMENT OF PUBLIC INFRASTRUCTURE
1105 Shawmut Avenue, New Bedford, MA 02746

8-17 2011

TO DPM Development

for Barnum Street

Sewer & Storm Drain
Extension

Sewer 2" Force main }
12" Storm Drain } \$ 4316.00
15" Storm Drain }

Sewer Permit # 24255
P 1300 \$450.00
4766.00

Deposit
ACCOUNT \$ 4766.00

ACCOUNT
DEPOSIT \$ 6001-439-44201-000

Check # 5669

DPM DEVELOPMENT CORP.
70 LAMBETH STREET
NEW BEDFORD, MA 02745

WEBSTER BANK
S EASTON, MA 02375
53-7023/2113

5669

8/17/2011

PAY TO THE
ORDER OF CITY OF NEW BEDFORD

\$4,766.00

Four Thousand Seven Hundred Sixty-Six and 00/100*****

CITY OF NEW BEDFORD

DOLLARS

MEMO

SEWER - BARNUM ST.
Permit

Rose Mary
AUTHORIZED SIGNATURE

005669 211370231 10 0133001164