



PERMIT NO.

24263

CITY OF NEW BEDFORD
SEWER AND/OR STORM DRAIN PERMIT

DATE 12/12/11

EXP. DATE 12/12/12

This certifies that permission is granted to

Property Owner Bristol Pacific Home Address 275 Martine St. Tel. 508 677-9234
Fall River MA 02723

To connect a sewer and/or storm drain located at 14 Appletree Lane

Assessor's Plot 130 Lot 155 to the sewer and/or storm drain in 14 Appletree Lane Street 2

To be laid in accordance with the conditions in this application and the City of New Bedford ordinances.

TYPE OF USE: RESIDENTIAL COMMERCIAL INDUSTRIAL FLOW 330 G.P.D.

If applicant other than actual property owner, attach Letter of Authorization from Property Owner.

Name Bristol Pacific Tel. 508 677-9234

Mailing Address 275 Martine St.

The Bonded Contractor/Drain Layer authorized to perform this work is:

Name J.B. Green Address 11A 02747

Type of Pipe Required: PVC 24" DN 25 Tel. (508) 981-1668

PERMIT EXPIRES ONE YEAR AFTER DATE OF ISSUE

- Requires separate connections for sewage and storm drain where applicable. Storm water cannot be discharged to a sanitary sewer.
 - All work must be inspected and approved by a D.P.I. inspector before backfilling.
 - If this connection is to be part of a private service shared jointly with other building owners, attach copy of Recorded Joint Maintenance Agreement.
 - Permits can be issued to Industrial and/or Commercial Applicants only upon receipt and approval by the Commissioner of Public Infrastructure of required plans and supplemental information.
 - In addition, a City-issued Industrial User Discharge Permit and/or a Sewer Extension/Connection Permit issued by the Commonwealth of Massachusetts D.E.P. shall be required by the City for Industrial Discharge into the sewer system.
- Industrial User Discharge Permit No. _____ Date _____

Comm. Mass. Sewer Conn./Ext. Permit No. _____ Date _____

A Filing and Inspection Fee of \$ 450, plus an Entrance Fee of \$ _____ where applicable, must accompany this application.

Bank# Bank of America Check# 19817 Date 12-12-11 Receipt# 9101

Other requirements: 24" PVC pipe for inspection

Connection made to Sewer Part of jointly-shared private line YES NO
Storm Drain


Applicant agrees to abide by the above terms, as well as all pertinent ordinances of the City of New Bedford, and such other special rules as the Commissioner of Public Infrastructure and/or City Engineer may deem necessary

Duarte M. Andrade City Engineer Sandra Pawa Signature of Property Owner or Representative

INSPECTOR'S REPORT

INSPECTED BY: 12/19/11
DATE: 12/19/11
COMMENTS:

APPROVED [Signature]
SIGNATURE

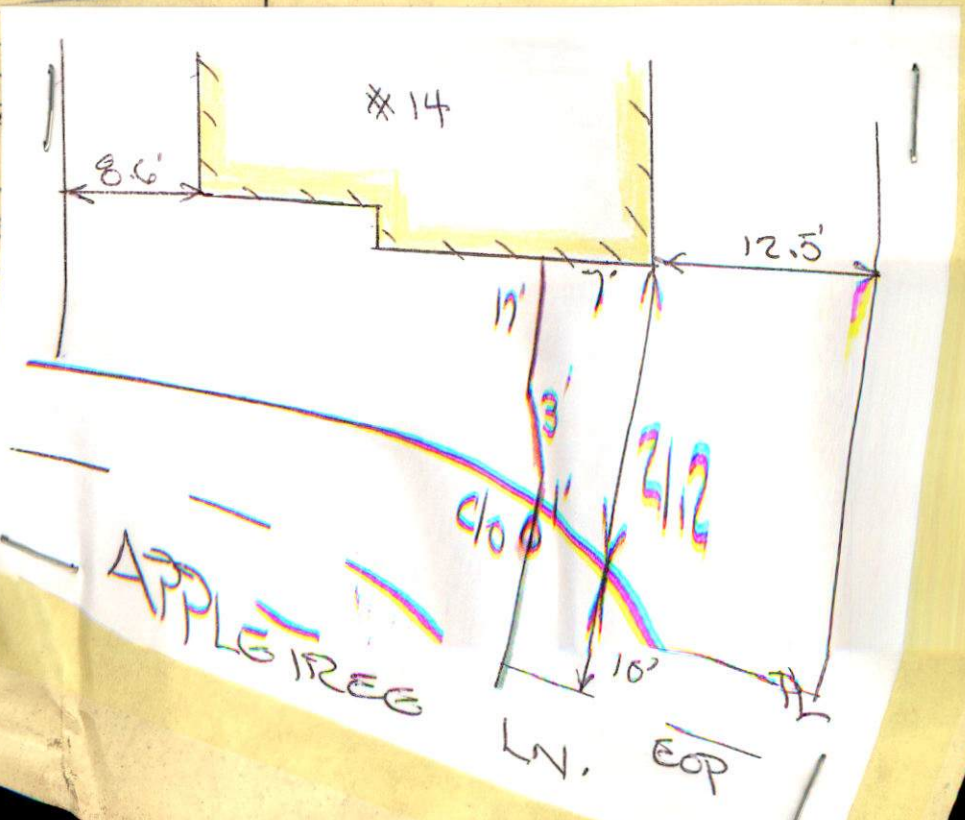



PERMIT NO.
24263

CITY OF NEW BEDFORD
SEWER AND/OR STORM DRAIN PERMIT

DATE 12/12/11
Expires: 12/12/12

This certifies that permission is granted to

Property Owner Bristol Pacific Homes 275 Martine St. Address Fall River, MA 02723 Tel. 508 677-9234

To connect a sewer and/or storm drain located at 14 Appletree Lane

Assessor's Plot 130 Lot 195, to the sewer and/or storm drain in 14 Appletree Lane Street 2

To be laid in accordance with the conditions in this application and the City of New Bedford ordinances.

TYPE OF USE: RESIDENTIAL COMMERCIAL INDUSTRIAL FLOW 330 G.P.D.

If applicant other than actual property owner, attach Letter of Authorization from Property Owner.

Name Bristol Pacific Tel. 508 677-9234
Mailing Address 275 Martine St.

The Bonded Contractor/Drain Layer authorized to perform this work is:

J.B. Dragen 21 E. River Dr Box Dartmouth, MA 02747

Name J.B. Dragen Address 21 E. River Dr Tel. (508) 984-1668
Type of Pipe Required: PVC SDM 35

PERMIT EXPIRES ONE YEAR AFTER DATE OF ISSUE

- Requires separate connections for sewage and storm drain where applicable. Storm water cannot be discharged to a sanitary sewer.
 - All work must be inspected and approved by a D.P.I. inspector before backfilling.
 - If this connection is to be part of a private service shared jointly with other building owners, attach copy of Recorded Joint Maintenance Agreement.
 - Permits can be issued to Industrial and/or Commercial Applicants only upon receipt and approval by the Commissioner of Public Infrastructure of required plans and supplemental information.
 - In addition, a City-issued Industrial User Discharge Permit and/or a Sewer Extension/Connection Permit issued by the Commonwealth of Massachusetts D.E.P. shall be required by the City for Industrial Discharge into the sewer system.
- Industrial User Discharge Permit No. _____ Date _____

Comm. Mass. Sewer Conn./Ext. Permit No. _____ Date _____
A Filing and Inspection Fee of \$ 450, plus an Entrance Fee of \$ _____ where applicable, must accompany this application.

Bank# Bank Five Check# 19817 Date 12-12-11 Receipt# 9101

Other requirements: 24 hour notice of inspection
(508) 991-6150

Connection made to Sewer Part of jointly-shared private line YES NO
Storm Drain

Applicant agrees to abide by the above terms, as well as all pertinent ordinances of the City of New Bedford, and such other special rules as the Commissioner of Public Infrastructure and/or City Engineer may deem necessary

Duarte M. Andrade
City Engineer


Sandra Pawa
Signature of Property Owner or Representative

INSPECTOR'S REPORT

INSPECTED BY: _____
DATE: _____
COMMENTS: _____

APPROVED _____ DISAPPROVED _____

SIGNATURE

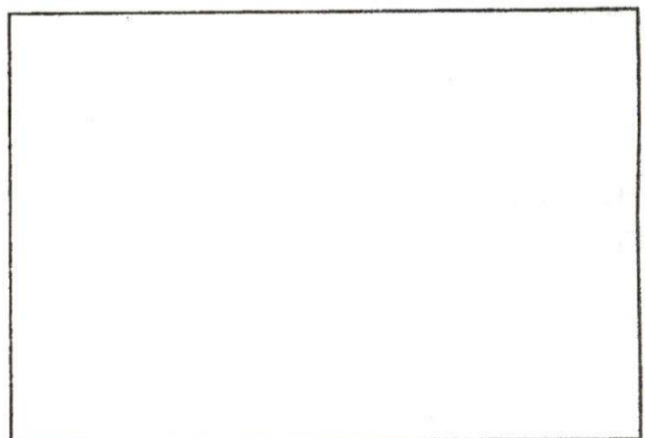

SKETCH PLAN



CITY OF NEW BEDFORD

1130

NO. 204510

LICENSE NO. _____

DATE 11/24 2010

FOUNDATION PERMIT

MSBC Sect. 111.8 - Any permit issued shall be deemed abandoned and invalid unless the work authorized by it shall have been commenced within six (6) months after its issuance.

This certifies that Bristol Pacific Homes owner/contractor
has permission to install foundation 54' x 28'
on 14 Apple Tree Ln Plot #55, Lot 155

providing that the person accepting this permit shall in every respect conform to the terms of the application therefor on file in this office; to the provisions of the Statute of the Commonwealth and to the By-Laws of the City of New Bedford relating to the Inspection, Erection, Enlarging, Altering, Raising, Moving, Repairing or Tearing Down of a Building.

WIRING INSPECTOR

PLUMBING INSPECTOR

BUILDING INSPECTOR

YOUR AREA INSPECTOR IS:

Thomas Wells

ROUGH FINISH

- Tel. 979-1540 Between 8:00 AM - 9:00 AM

NOTICE: NOTIFY INSPECTOR 48 HOURS
IN ADVANCE OF APPLYING
SHEATING OR LATHING


OCCUPANCY PERMIT REQUIRED BEFORE OCCUPANCY

No Building or Structure shall be used or occupied until the Certificate of Use and Occupancy shall have been issued by the Building Commissioner - MSBC. Sect. 120.1 - N.B. Zoning Ord. Sect. 9-269

THIS CARD MUST BE DISPLAYED IN A CONSPICUOUS PLACE ON THE PREMISES
AND NOT TORN DOWN OR REMOVED UNTIL COMPLETION OF WORK

SUBJECT TO MASSACHUSETTS STATE
BUILDING CODE REQUIREMENTS

Danny D. Brown
BUILDING INSPECTOR

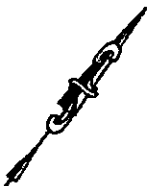


PLAT 120
LOT 157

PLAT 120
LOT 158

PLAT 120
LOT 159

APPLE TREE LANE

BENCHMARK

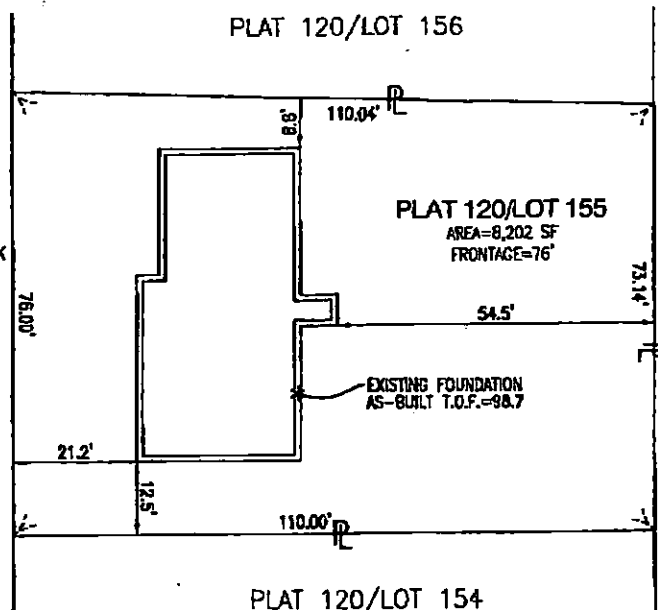



8/0/93
N/F
FIRST CHURCH OF THE NAZARENE

SITE BENCHMARK:

X-CUT IN BONNET BOLT OF HYDRANT
ELEV. = 98.88 (PLAN DATUM)

CONVERSION TO NEW BEDFORD CITY DATUM:

PLAN ELEVATION + 53.16 = NEW BEDFORD
CITY DATUM

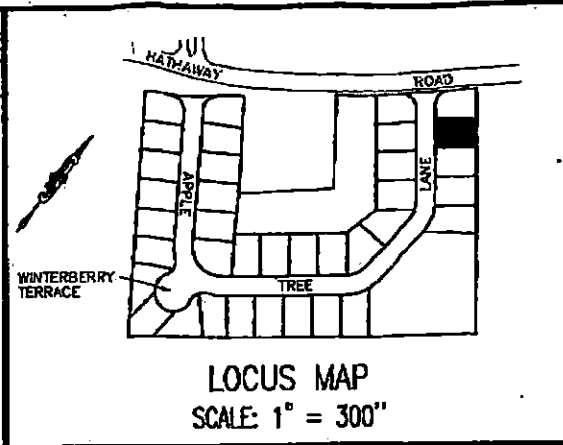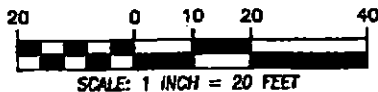

MARK A. BOUCHER, P.L.S.
MA REG. NO. 41246

DATE 12/08/11

FOUNDATION AS-BUILT PLAN PLAT 120, LOT 155 (HALL ESTATES LOT 19)

NEW BEDFORD, MASSACHUSETTS

SCALE: 1"=20' DATE: DECEMBER 8, 2011

PREPARED FOR

NEW BEDFORD HALL ESTATES, LLC.

PREPARED BY

BOUCHER & HEUREUX, INC.

CIVIL/ENVIRONMENTAL ENGINEERS, SCIENTISTS
LAND SURVEYORS AND PLANNERS

648 AMERICAN LEGION HIGHWAY, SUITE 1, WESTPORT, MASSACHUSETTS 02790
TEL: 508-636-5905 FAX: 508-636-2477

FILE: 1435-LOT19-FDNASBLT.dwg



Inspector

PERMIT NO.

24263

CITY OF NEW BEDFORD
SEWER AND/OR STORM DRAIN PERMIT

DATE 12/12/11
EXPIRES: 12/12

This certifies that permission is granted to

Property Owner

Address

Bristol Pacific Homes 275 Martine St.

508 677-9234

Fall River MA 02723 Tel.

To connect a sewer and/or storm drain located at

14 Appletree Lane

Assessor's Plot

150

Lot 155

to the sewer and/or storm drain in

14 Appletree Lane

Street

To be laid in accordance with the conditions in this application and the City of New Bedford ordinances.

TYPE OF USE:

RESIDENTIAL

COMMERCIAL

INDUSTRIAL

FLOW 330 G.P.D.

If applicant other than actual property owner, attach Letter of Authorization from Property Owner.

Name

Bristol Pacific

Tel.

508 677-9234

Mailing Address

275 Martine St.

The Bonded Contractor/Drain Layer authorized to perform this work is:

J.B. Strogen

21 E. River Dr.

Dorchester, MA

02747

Name

Address

Tel.

(508) 981-1668

Type of Pipe Required:

PVC

SD

35

PERMIT EXPIRES ONE YEAR AFTER DATE OF ISSUE

- Requires separate connections for sewage and storm drain where applicable. Storm water cannot be discharged to a sanitary sewer.
 - All work must be inspected and approved by a D.P.I. inspector before backfilling.
 - If this connection is to be part of a private service shared jointly with other building owners, attach copy of Recorded Joint Maintenance Agreement.
 - Permits can be issued to Industrial and/or Commercial Applicants only upon receipt and approval by the Commissioner of Public Infrastructure of required plans and supplemental information.
 - In addition, a City-issued Industrial User Discharge Permit and/or a Sewer Extension/Connection Permit issued by the Commonwealth of Massachusetts D.E.P. shall be required by the City for Industrial Discharge into the sewer system.
- Industrial User Discharge Permit No. Date

Comm. Mass. Sewer Conn./Ext. Permit No.

Date

A Filing and Inspection Fee of \$450, plus an Entrance Fee of \$..... where applicable, must accompany this application.

Bank#

Bank Five

Check#

19817

Date

12-12-11

Receipt#

9101

Other requirements:

24 hour notice of inspection

0

(508) 991-6150

Connection made to

Sewer

Part of jointly-shared private line

YES

NO

Storm Drain

Applicant agrees to abide by the above terms, as well as all pertinent ordinances of the City of New Bedford, and such other special rules as the Commissioner of Public Infrastructure and/or City Engineer may deem necessary

Duarte M. Andrade

City Engineer

Sandra Pavia

Signature of Property Owner or Representative

INSPECTOR'S REPORT

INSPECTED BY:

DATE:


COMMENTS:

APPROVED

DISAPPROVED

SIGNATURE

SKETCH PLAN

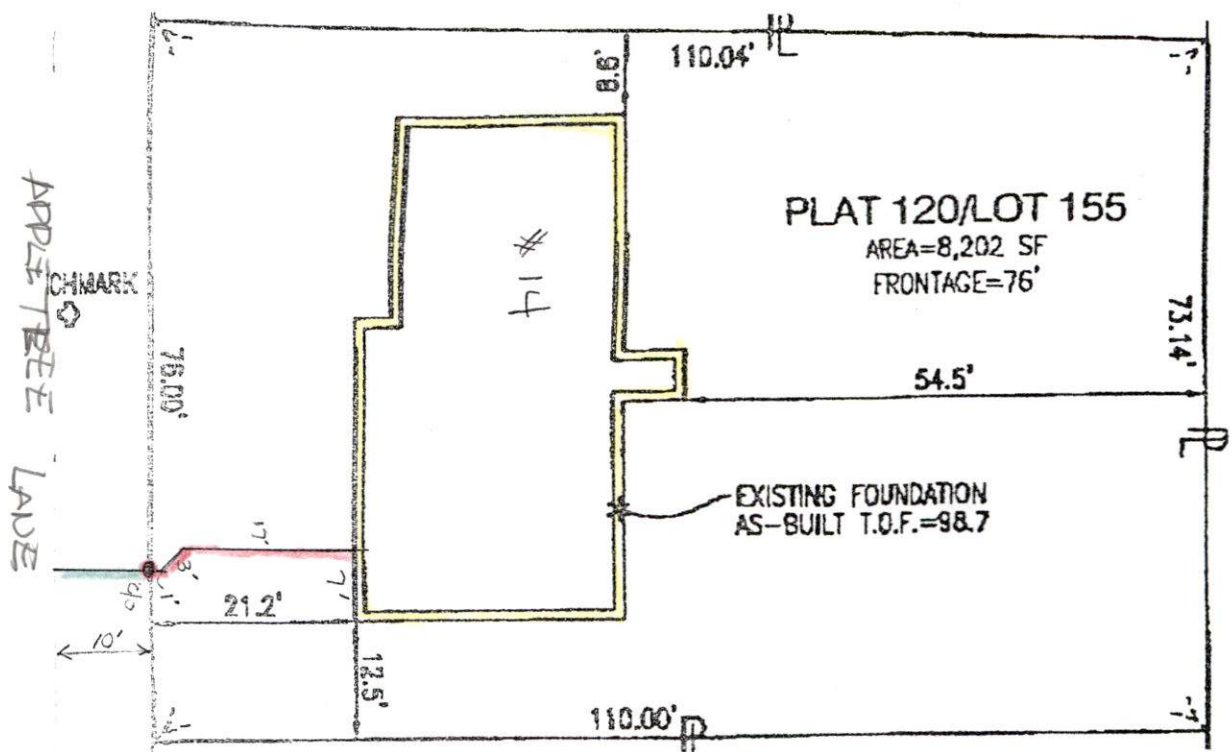

HAL ESTIMATES
 SENTINEL-111
 DATE: 12/15/11
 CONTRACTOR: Bristol Pacific
 HOMES
 INSPECTION: Bob R. Daniel
 PERMIT # 24263
 PLAT 120 LOT 155