



PERMIT NO.

CITY OF NEW BEDFORD
SEWER AND/OR STORM DRAIN PERMIT

DATE 3/26/10

24277

This certifies that permission is granted to

Property Owner D.P.M. Development Address 10 Lambeth St. #897 Tel. (508) 993 0381

To connect a sewer and/or storm drain located at Barnum St. (N.S.) 3654 (+) E x Morris St.

Assessor's Plot 130A Lot 328, to the sewer and/or storm drain in Barnum Street

To be laid in accordance with the conditions in this application and the City of New Bedford ordinances.

TYPE OF USE: RESIDENTIAL COMMERCIAL INDUSTRIAL FLOW 330 G.P.D.

If applicant other than actual property owner, attach Letter of Authorization from Property Owner.

Name 1710 Parsons Tel. (508) 993 0381

Mailing Address 10 Lambeth St. N.B. MA 02715

The Bonded Contractor/Drain Layer authorized to perform this work is:

Name P.J. Conessa Address PO Box 51643 Tel. (508) 998 3404

Type of Pipe Required: P.V.C. 12" 35'

PERMIT EXPIRES ONE YEAR AFTER DATE OF ISSUE

- Requires separate connections for sewage and storm drain where applicable. Storm water cannot be discharged to a sanitary sewer.
- All work must be inspected and approved by a D.P.I. inspector before backfilling.
- If this connection is to be part of a private service shared jointly with other building owners, attach copy of Recorded Joint Maintenance Agreement.
- Permits can be issued to Industrial and/or Commercial Applicants only upon receipt and approval by the Commissioner of Public Infrastructure of required plans and supplemental information.
- In addition, a City-issued Industrial User Discharge Permit and/or a Sewer Extension/Connection Permit issued by the Commonwealth of Massachusetts D.E.P. shall be required by the City for Industrial Discharge into the sewer system.

Industrial User Discharge Permit No. Date

Comm. Mass. Sewer Conn./Ext. Permit No. Date

A Filing and Inspection Fee of \$ 450, plus an Entrance Fee of \$ where applicable, must accompany this application.

Bank# Woods Bank 5752 Check# 5752 Date 3/20/10 Receipt# 09339

Other requirements: Please call ahead to (508) 991 6100 for 24 hr. notice on inspection

Connection made to Sewer Part of jointly-shared private line YES NO
Storm Drain

Applicant agrees to abide by the above terms, as well as all pertinent ordinances of the City of New Bedford, and such other special rules as the Commissioner of Public Infrastructure and/or City Engineer may deem necessary

Manuel H. Silva
City Engineer
Supervising Civil Engineer

[Signature]
Signature of Property Owner or Representative


INSPECTOR'S REPORT

INSPECTED BY: [Signature]
DATE: 8/23/10
COMMENTS:

APPROVED

DISAPPROVED

SIGNATURE

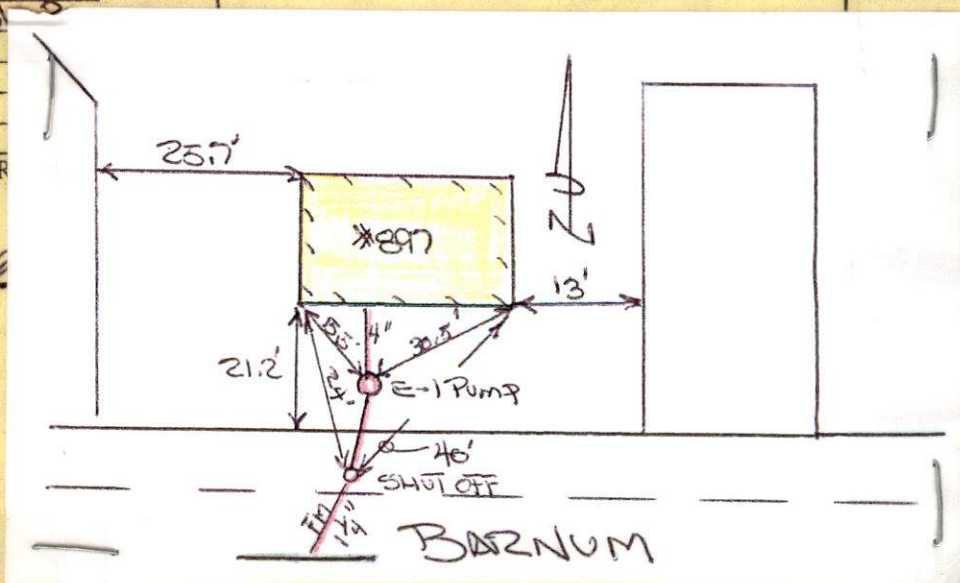



PERMIT NO.
24277

CITY OF NEW BEDFORD
SEWER AND/OR STORM DRAIN PERMIT

DATE 3/26/12
Exp. 3/26/13

This certifies that permission is granted to

D.P.M. Development 70 Lambeth St. (508) 993-0381
Property Owner Address Tel.

To connect a sewer and/or storm drain located at Barnum St (N.S.) 365 ft (+/-) E x Moses St.

Assessor's Plot 1301 Lot 328, to the sewer and/or storm drain in Barnum Street

To be laid in accordance with the conditions in this application and the City of New Bedford ordinances.

TYPE OF USE: RESIDENTIAL COMMERCIAL INDUSTRIAL FLOW 330 G.P.D.

If applicant other than actual property owner, attach Letter of Authorization from Property Owner.

Name Lino Ferreira Tel. (508) 993-0381
Mailing Address 70 Lambeth St. N.B. MA 02745

The Bonded Contractor/Drain Layer authorized to perform this work is:

Pro. Conessa
Name P.J. Conessa Address PO Box 51643 Tel. (508) 998-3404
Type of Pipe Required: P.V.C. SDR 35

PERMIT EXPIRES ONE YEAR AFTER DATE OF ISSUE

- Requires separate connections for sewage and storm drain where applicable. Storm water cannot be discharged to a sanitary sewer.
 - All work must be inspected and approved by a D.P.I. inspector before backfilling.
 - If this connection is to be part of a private service shared jointly with other building owners, attach copy of Recorded Joint Maintenance Agreement.
 - Permits can be issued to Industrial and/or Commercial Applicants only upon receipt and approval by the Commissioner of Public Infrastructure of required plans and supplemental information.
 - In addition, a City-issued Industrial User Discharge Permit and/or a Sewer Extension/Connection Permit issued by the Commonwealth of Massachusetts D.E.P. shall be required by the City for Industrial Discharge into the sewer system.
- Industrial User Discharge Permit No. _____ Date _____

Comm. Mass. Sewer Conn./Ext. Permit No. _____ Date _____
A Filing and Inspection Fee of \$ 450, plus an Entrance Fee of \$ _____ where applicable, must accompany this application.

Bank# Webster Bank Check# 5752 Date 3/20/12 Receipt# 09339

Other requirements: Please call ahead @ (508) 991-1100 for 24 hour
notice on inspection.

Connection made to Sewer Part of jointly-shared private line YES NO
Storm Drain

Applicant agrees to abide by the above terms, as well as all pertinent ordinances of the City of New Bedford, and such other special rules as the Commissioner of Public Infrastructure and/or City Engineer may deem necessary.

Manuel H. Silva
City Engineer
Supervising Civil Engineer

Lino Ferreira
Signature of Property Owner or Representative


INSPECTOR'S REPORT

INSPECTED BY: JB
DATE: 3/23/12
COMMENTS: _____

APPROVED

DISAPPROVED

Signature
SIGNATURE

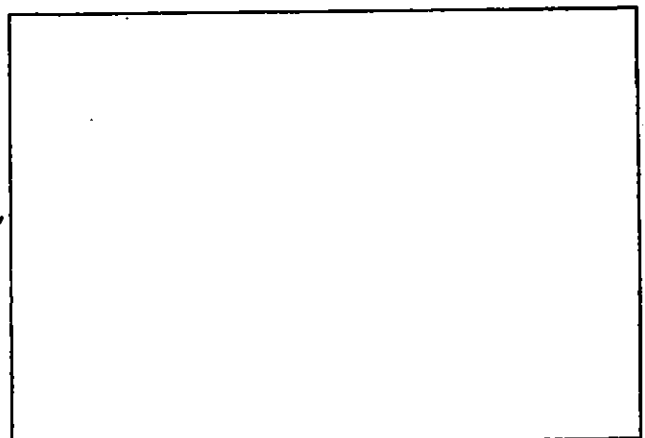

SKETCH PLAN



**CITY OF NEW BEDFORD
MASSACHUSETTS**

DEPARTMENT OF PUBLIC WORKS
ENGINEERING DIVISION
133 WILLIAM STREET, ROOM 303
NEW BEDFORD, MA 02740
Tel: (508) 979-1527
Fax: (508) 961-3043

To Whom It May Concern:

PRESIDENT OF DPM DEVELOPMENTS CORP
I, DANIEL MONIZ, 70 LAMBETH ST., N.B., MA 02745, being
(Name) (Mailing Address)

Owner of property located at BARNUM STREET

Plot 130A, Lot 328, hereby agree to allow LINO PEREIRA
(Name)

70 LAMBETH ST., N.B., MA 02745 to act on my behalf including affixing my
(Mailing Address)

signature in securing permit for:

☒ Sewer/Drain Service Permits
☒ Water Service Permits
☒ Driveway Installation Permits
☐ Sidewalk Installation Permits

I further agree to conform to, and abide by, all City rules and ask regulations applicable to the permit (s) being applied for:

Name

(Signature)


70 LAMBETH ST., N.B., MA 02745
(Address)

(Date)

(Telephone number)

OSGOOD

(UNCONSTRUCTED - 40')

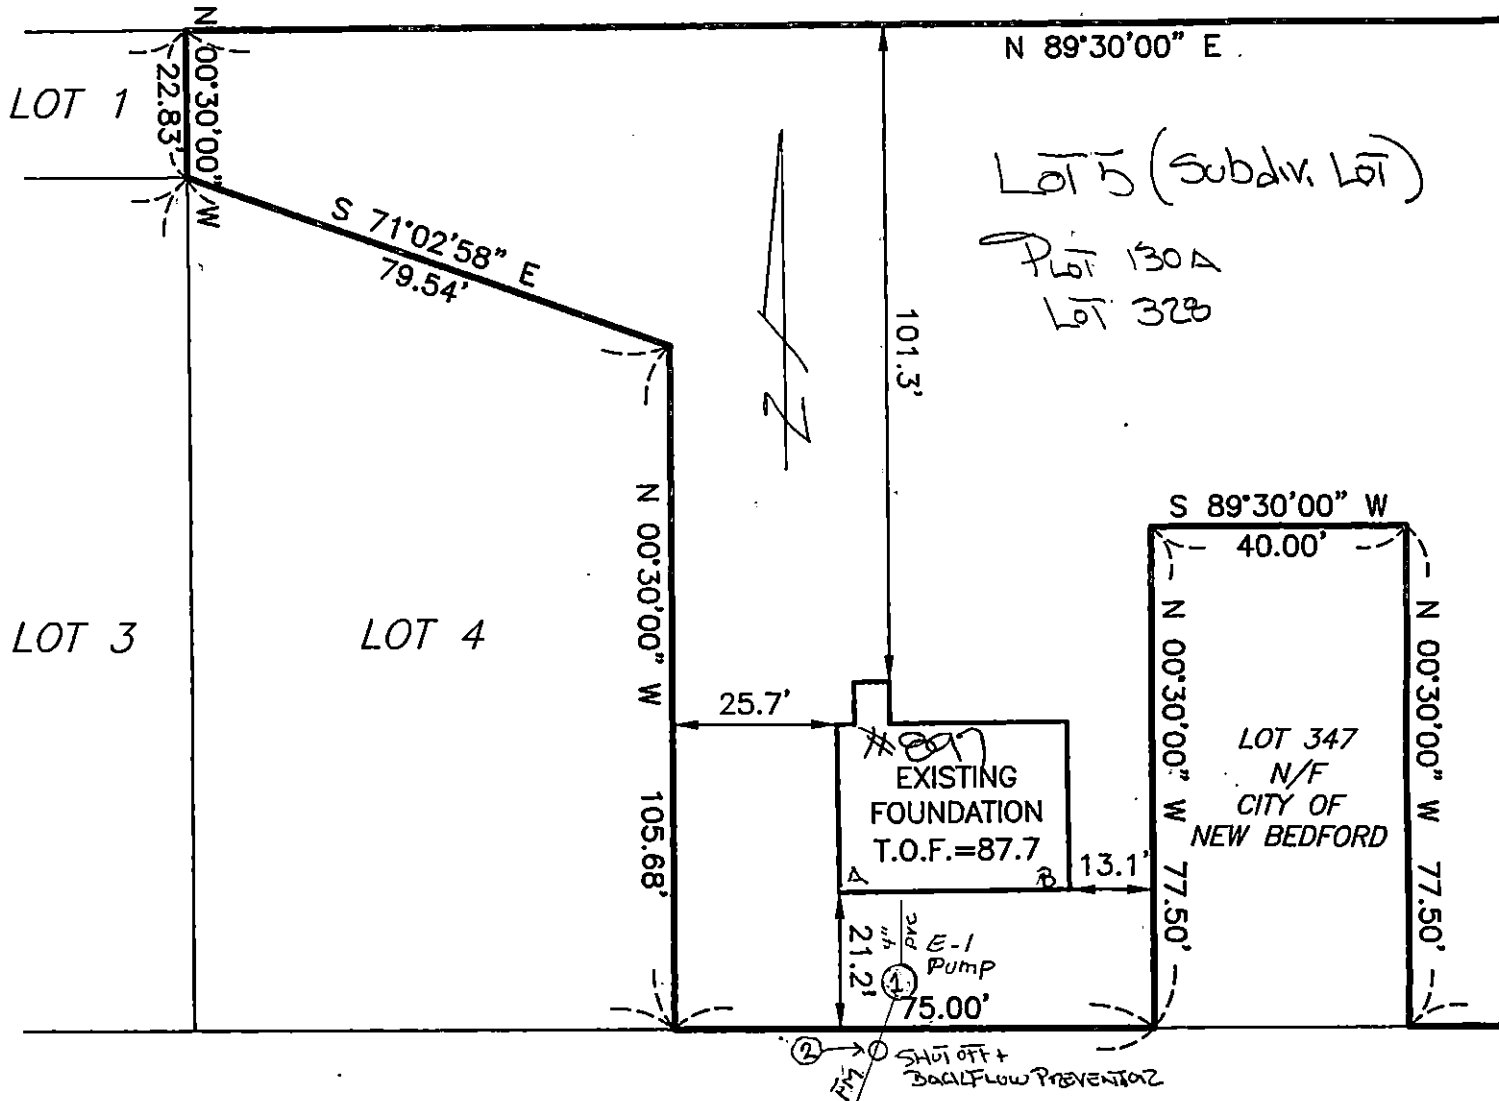

BARNUM (UNDER CONSTRUCTION - 40' WIDE) S'

A-1 = 15.5'
A-2 = 24.0'
B-1 = 30.5'
B-2 = 40'

ZONING REQUIREMENTS:

ZONE: RESIDENCE - B (RB)
MIN. LOT AREA = 8,000 SQ. FT.
MIN. UPLAND AREA = 6,400 SQ. FT.
MIN. LOT WIDTH = 75'
MIN. SETBACKS: FRONT = 20'
SIDES = 8' & 12'
REAR = 30'

I HEREBY CERTIFY THAT THE LOCATION
OF THE FOUNDATION SHOWN RESULTS
MADE ON THE GROUND AND IS ACCURATE

[Signature]
PROFESSIONAL LAND SURVEYOR

WLF 119

EROSION CONTROL BARRIER

250.00'

PROPOSED ROOF DRAIN
INFILTRATION SYSTEM (TYR.)AREA
9-553WETLANDS RESTORATION ARE
PER FINAL ORDER (SE 49-1)PROPOSED
STOCKADE**LOT 2**8,083 SQ. FT.
ALL UPLANDS**LOT 3**8,386 SQ. FT.
ALL UPLANDS**LOT 4**8,919 SQ. FT.
ALL UPLANDS**LOT 5**45,331 SQ. FT.
7,849 SQ. FT. UPLANDSPROPOSED
DWELLING
TOF=88.0PROPOSED
DWELLING
TOF=88.0PROPOSED
DWELLING
TOF=88.0PROPOSED
DWELLING
TOF=87.0PROPOSED
DWELLING
TOF=87.0PROP
BIT
CONC
DRIVEPROP
BIT
CONC
DRIVEPROP
BIT
CONC
DRIVEPROP
BIT
CONC
DRIVEPROP
PUMP

CHAMBER (TYP.)

EXIST. 2" SDR21
FORCE MAIN

EXIST. 8" WATER MAIN

LOT 504
N/F
ARGUIN**BENCHMARK:**TOP SPINDLE OF HYDRANT
LOCATED AT STA 3+87, 15'
LEFT. ELEVATION = 87.2812" ADS
S=0.005INLINE
FLUSHING
CONNECTION
MANHOLELOT 764
N/FLOT 523
N/F
SANIATKOWSKIT 782
V/F
RREIALOT 499
N/F
OTLEY

1"=30'

83.8
R/W

77.50'

PROJ
DECI

WLF 105

WLF 106

WLF 107

WLF 400

WLF 119

EROSION CONTROL BARRIER

AND TYLE FENCE

250.00'

PROPOSED ROOF DRAIN
INFILTRATION SYSTEM (TYR.)

WLF 109

WETLANDS RESTORATION ARE
PER FINAL ORDER (SE 49--)PROPOSED
STOCKADE**LOT 5**45,331 SQ. FT.
7,849 SQ. FT. UPLANDSPROI
DECI**LOT 3**8,386 SQ. FT.
ALL UPLANDS**LOT 4**8,919 SQ. FT.
ALL UPLANDS**LOT 2**8,083 SQ. FT.
ALL UPLANDSPROPOSED
DWELLING
TOF=88.0PROPOSED
DWELLING
TOF=88.0PROPOSED
DWELLING
TOF=88.0PROPOSED
DWELLING
TOF=87.0PROP
BIT
CONC
DRIVEPROP
BIT
CONC
DRIVEPROP
BIT
CONC
DRIVEPROP
BIT
CONC
DRIVECURB
STOP
(TYR.)PROP. PUMP
CHAMBER (TYR.)EXIST. 2" SDR21
FORCE MAIN

FM

EXIST. 8" WATER MAIN

LOT 504
N/F
ARGUIN**BENCHMARK:**TOP SPINDLE OF HYDRANT
LOCATED AT STA 3+87, 15'
LEFT. ELEVATION = 87.2812" ADS
S=0.005INLINE
FLUSHING
CONNECTION
MANHOLELOT 764
N/FLOT 523
N/F

SANIATKOWSKI

1"=30'

LOT 499
N/F
OTLEY782
F
EIA

897

BARNUM St.

OSGOOD

(UNCONSTRUCTED -

N 89°30'00" E

LOT 5 (subdiv. Lot)

PLOT 130A
LOT 328

S 71°02'58" E
79.54'

101.3'

LOT 4

N 00°30'00" W 105.68'

25.7'


EXISTING
FOUNDATION
T.O.F. = 87.7'

13.1'

S 89°30'00" W
40.00'

N 00°30'00" W 77.50'

LOT 347
N/F
CITY OF
NEW BEDFORD

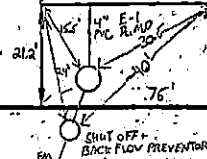

BARNUM (UNDER CONSTRUCTION - 40' WIDE)

8

SEWER INSPECTION

DATE: 8/23/2012

CONTRACTOR: R.J. CANESSA

INSP: R. BICHEL

PERMIT #: 24277

PLOT 130A LOT 328