



PERMIT NO.

24294

CITY OF NEW BEDFORD
SEWER AND/OR STORM DRAIN PERMIT

DATE 8/30/12
Exp. 8/30/13

This certifies that permission is granted to

Triple Horn LLC
Kristen Bendiksen Manager 10 Water St. Fairhaven MA 02718
Property Owner Address Tel. 508-999-4616

To connect a sewer and/or storm drain located at Tarklin Place (SS) of side of road

Assessor's Plot 130f Lot 19, to the sewer and/or storm drain in Tarklin Place 10" Street
Sewer

To be laid in accordance with the conditions in this application and the City of New Bedford ordinances.

TYPE OF USE: RESIDENTIAL COMMERCIAL INDUSTRIAL FLOW G.P.D.

If applicant other than actual property owner, attach Letter of Authorization from Property Owner.

Name John Folino, Cape Building Systems Tel.
Mailing Address 13 Industrial Dr. Mattapoisett MA 02739

The Bonded Contractor/Drain Layer authorized to perform this work is:
MHT Excavating 1213 Way Mattapoisett MA 02739

Name Address Tel. 774-263-2943
Type of Pipe Required: SDR 35 PVC

PERMIT EXPIRES ONE YEAR AFTER DATE OF ISSUE

- Requires separate connections for sewage and storm drain where applicable. Storm water cannot be discharged to a sanitary sewer.
- All work must be inspected and approved by a D.P.I. inspector before backfilling.
- If this connection is to be part of a private service shared jointly with other building owners, attach copy of Recorded Joint Maintenance Agreement.
- Permits can be issued to Industrial and/or Commercial Applicants only upon receipt and approval by the Commissioner of Public Infrastructure of required plans and supplemental information.
- In addition, a City-issued Industrial User Discharge Permit and/or a Sewer Extension/Connection Permit issued by the Commonwealth of Massachusetts D.E.P. shall be required by the City for Industrial Discharge into the sewer system.

Industrial User Discharge Permit No. Date

Comm. Mass. Sewer Conn./Ext. Permit No. Date

A Filing and Inspection Fee of \$450, plus an Entrance Fee of \$ where applicable, must accompany this application.

Bank# Eastern Bank Check# 32876 Date 8/29/12 Receipt# 9563

Adhere to Conservation Conditions. Install as per attached plan
Other requirements: 24 hour notice for inspection @ 508-991-6150. Also to

include a clean out in City layout in green area & install a new manhole at end of line in street

Connection made to Sewer Part of jointly-shared private line YES NO
Storm Drain

Applicant agrees to abide by the above terms, as well as all pertinent ordinances of the City of New Bedford, and such other special rules as the Commissioner of Public Infrastructure and/or City Engineer may deem necessary


Manuel H. Silva Co. City Engineer
Supervising Civil Engineer
John W. Folino Signature of Property Owner or Representative

INSPECTOR'S REPORT

INSPECTED BY:
DATE:
COMMENTS:

APPROVED DISAPPROVED

SEE WHITE
SIGNATURE

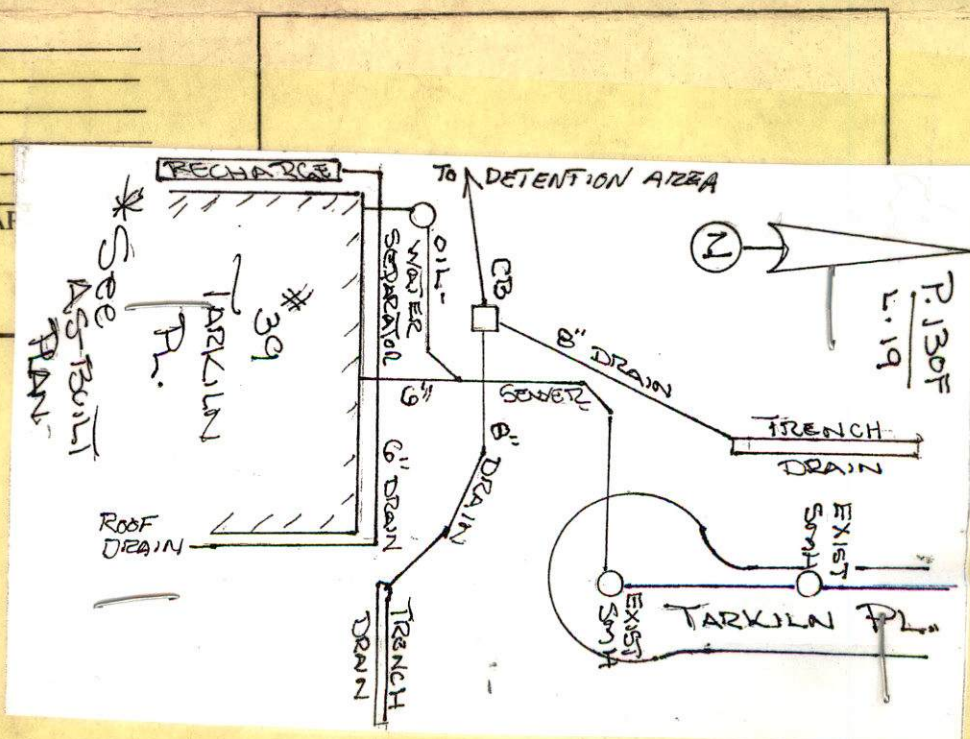



Inspector

PERMIT NO.

24294

CITY OF NEW BEDFORD
SEWER AND/OR STORM DRAIN PERMIT

DATE 8/30/12

Exp. 8/30/13

This certifies that permission is granted to

Triple Horn LLC
Kristen Bendiksen, Manager 10 Water St., Fair Haven, MA 02718
Property Owner Address Tel. 508-999-4616

To connect a sewer and/or storm drain located at Tarklin Place (SS) of cul de sac
Assessor's Plot 130f Lot 19, to the sewer and/or storm drain in Tarklin Place 10" connected into sewer Street

To be laid in accordance with the conditions in this application and the City of New Bedford ordinances.

TYPE OF USE: RESIDENTIAL COMMERCIAL INDUSTRIAL FLOW 225 G.P.D.

If applicant other than actual property owner, attach Letter of Authorization from Property Owner.

Name John Folino, Cape Building Systems Tel. 02739
Mailing Address 13 Industrial Dr., Mattapoisett, MA
The Bonded Contractor/Drain Layer authorized to perform this work is:
M.H.T. Excavating 1 Lil's Way, Mattapoisett, MA 02739
Name Address Tel. 774-263-2943
Type of Pipe Required: SDR 35 PVC

PERMIT EXPIRES ONE YEAR AFTER DATE OF ISSUE

- Requires separate connections for sewage and storm drain where applicable. Storm water cannot be discharged to a sanitary sewer.
 - All work must be inspected and approved by a D.P.I. inspector before backfilling.
 - If this connection is to be part of a private service shared jointly with other building owners, attach copy of Recorded Joint Maintenance Agreement.
 - Permits can be issued to Industrial and/or Commercial Applicants only upon receipt and approval by the Commissioner of Public Infrastructure of required plans and supplemental information.
 - In addition, a City-issued Industrial User Discharge Permit and/or a Sewer Extension/Connection Permit issued by the Commonwealth of Massachusetts D.E.P. shall be required by the City for Industrial Discharge into the sewer system.
- Industrial User Discharge Permit No. _____ Date _____

Comm. Mass. Sewer Conn./Ext. Permit No. _____ Date _____
A Filing and Inspection Fee of \$ 450, plus an Entrance Fee of \$ _____ where applicable, must accompany this application.

Bank# Eastern Bank Check# 32876 Date 8/29/12 Receipt# 9563
Adhere to Conservation Conditions. Install as per attached plan
Other requirements: 24 hour notice for inspection @ 508-991-6150. Also to

include a clean out in City layout in green area & install a new manhole
at end of line in street
Connection made to Sewer Part of jointly-shared private line YES ☒ NO
Storm Drain


Applicant agrees to abide by the above terms, as well as all pertinent ordinances of the City of New Bedford, and such other special rules as the Commissioner of Public Infrastructure and/or City Engineer may deem necessary

Manuel H. Silva co. John W. Folino
City Engineer Signature of Property Owner or Representative
Supervising Civil Engineer

INSPECTOR'S REPORT

INSPECTED BY: [Signature]
DATE: 11/29/12
COMMENTS: _____

APPROVED ☒ DISAPPROVED ☐
[Signature]
SIGNATURE

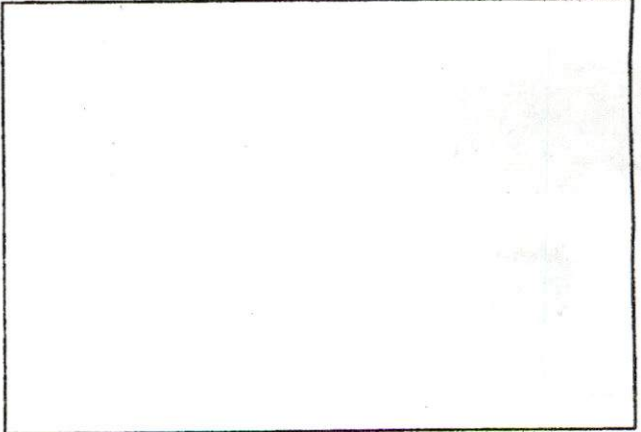

SKETCH PLAN

DRAIN Plot 124 D



WORK ORDER

CHECK LEAK
MARK OFF
INSPECTION
~~POOR PRESSURE~~

Sewer

HYDRANT
INVESTIGATE
SHUT-OFF
TURN-ON

DATE: 11/28/12 TIME: _____ FROM: Carol

TO: Bob

LOCATION: Tackila Place

COMMENTS: Sewer Inspection

Friday 11/29/12 @ 1:00

for Mike Saunders

MHT Excavating (774-263-2943)

RESPONSE: _____

DATE: _____ FROM: _____