



PERMIT NO.

24297

CITY OF NEW BEDFORD  
SEWER AND/OR STORM DRAIN PERMIT

DATE 9/14/12  
Exp 9/14/13

This certifies that permission is granted to

Carlos Da Costa 510 Hawthorn St. Dartmouth MA 02747  
Property Owner Address Tel. 774-263-8134

To connect a sewer and/or storm drain located at Sparrow St. (N.S.) 1201  
239+ W. X. Robin St. (Private St.) Connect 6" SDR 35

Assessor's Plot 138 Lot 239+ to the sewer and/or storm drain in Sparrow St. into New Street  
8" sewer main

To be laid in accordance with the conditions in this application and the City of New Bedford ordinances.

TYPE OF USE: RESIDENTIAL COMMERCIAL INDUSTRIAL FLOW 330 G.P.D.

If applicant other than actual property owner, attach Letter of Authorization from Property Owner.

Name..... Tel.....

Mailing Address.....

The Bonded Contractor/Drain Layer authorized to perform this work is:

M.H.T. Excavating 1 Lil's Way MARHARAI SEH, MA 02729  
Name Address Tel.

Type of Pipe Required: 6" SDR 35

PERMIT EXPIRES ONE YEAR AFTER DATE OF ISSUE

- Requires separate connections for sewage and storm drain where applicable. Storm water cannot be discharged to a sanitary sewer.
  - All work must be inspected and approved by a D.P.I. inspector before backfilling.
  - If this connection is to be part of a private service shared jointly with other building owners, attach copy of Recorded Joint Maintenance Agreement.
  - Permits can be issued to Industrial and/or Commercial Applicants only upon receipt and approval by the Commissioner of Public Infrastructure of required plans and supplemental information.
  - In addition, a City-issued Industrial User Discharge Permit and/or a Sewer Extension/Connection Permit issued by the Commonwealth of Massachusetts D.E.P. shall be required by the City for Industrial Discharge into the sewer system.
- Industrial User Discharge Permit No..... Date.....

Comm. Mass. Sewer Conn./Ext. Permit No..... Date.....

A Filing and Inspection Fee of \$ 450., plus an Entrance Fee of \$..... where applicable, must accompany this application.

Bank# St. Anne's C.U. Check# 775000 Date 9/14/12 Receipt# 9582

Other requirements: 24 hour notice for inspection @ 508-991-6150

Connection made to Sewer Part of jointly-shared private line YES ☒ NO  
Storm Drain

Applicant agrees to abide by the above terms, as well as all pertinent ordinances of the City of New Bedford, and such other special rules as the Commissioner of Public Infrastructure and/or City Engineer may deem necessary

Michael E. Silva  
City Engineer  
Clerk of Works

Carlos P. Da Costa  
Signature of Property Owner or Representative

INSPECTOR'S REPORT

INSPECTED BY: \_\_\_\_\_

DATE: \_\_\_\_\_


COMMENTS: \_\_\_\_\_

APPROVED \_\_\_\_\_

DISA \_\_\_\_\_

SEE WHITE SHEET

SIGNATURE

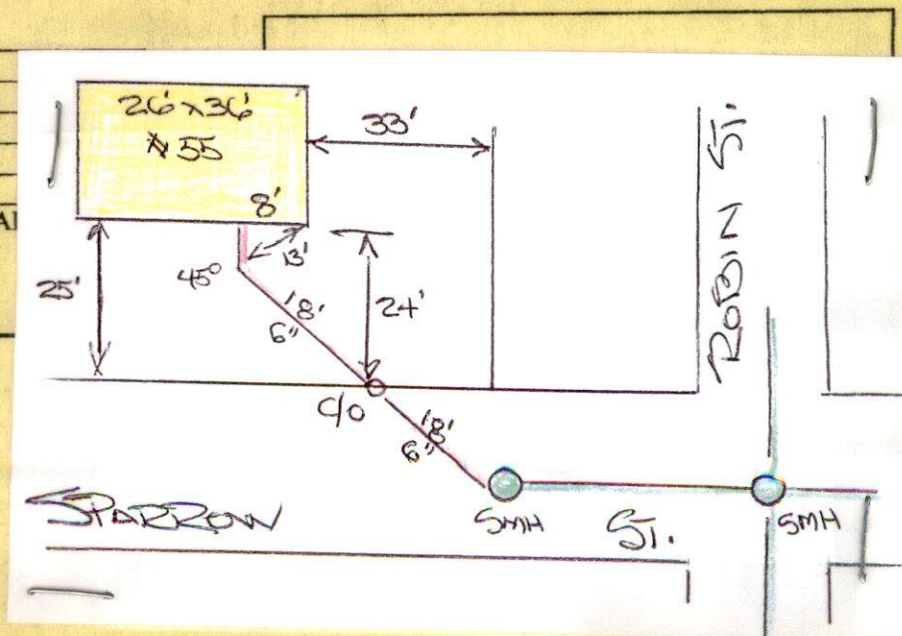



WW-12-25



Engineer's

PERMIT NO.

24297

CITY OF NEW BEDFORD  
SEWER AND/OR STORM DRAIN PERMIT

DATE 9/14/12  
Exp 9/14/13

This certifies that permission is granted to

Carlos DaCosta 510 Hawthorn St Dartmouth MA 02747  
Property Owner Address Tel. 774-263-8134

To connect a sewer and/or storm drain located at Sparrow St W.X. Robin St (PRIVATE ST.)  
Assessor's Plot 138 Lot 239 to the sewer and/or storm drain in Sparrow St into NEW Street  
8" sewer main

To be laid in accordance with the conditions in this application and the City of New Bedford ordinances.  
TYPE OF USE: RESIDENTIAL COMMERCIAL INDUSTRIAL FLOW 330 G.P.D.

If applicant other than actual property owner, attach Letter of Authorization from Property Owner.

Name..... Tel.....  
Mailing Address.....  
The Bonded Contractor/Drain Layer authorized to perform this work is:  
M.H.T. Excavating, 1 Hill's Way, MAHARAJA SEIT, MA 02735  
Name Address Tel.  
Type of Pipe Required: 6" SDR 35

PERMIT EXPIRES ONE YEAR AFTER DATE OF ISSUE

- Requires separate connections for sewage and storm drain where applicable. Storm water cannot be discharged to a sanitary sewer.
  - All work must be inspected and approved by a D.P.I. inspector before backfilling.
  - If this connection is to be part of a private service shared jointly with other building owners, attach copy of Recorded Joint Maintenance Agreement.
  - Permits can be issued to Industrial and/or Commercial Applicants only upon receipt and approval by the Commissioner of Public Infrastructure of required plans and supplemental information.
  - In addition, a City-issued Industrial User Discharge Permit and/or a Sewer Extension/Connection Permit issued by the Commonwealth of Massachusetts D.E.P. shall be required by the City for Industrial Discharge into the sewer system.
- Industrial User Discharge Permit No..... Date.....

Comm. Mass. Sewer Conn./Ext. Permit No..... Date.....  
A Filing and Inspection Fee of \$450, plus an Entrance Fee of \$..... where applicable, must accompany this application.

Bank# St. Anne's C.U. Check# 775000 Date 9/14/12 Receipt# 9582

Other requirements: 24 hour notice for inspection @ 508-991-6150

Connection made to Sewer Part of jointly-shared private line YES (NO)  
Storm Drain

Applicant agrees to abide by the above terms, as well as all pertinent ordinances of the City of New Bedford, and such other special rules as the Commissioner of Public Infrastructure and/or City Engineer may deem necessary

Michael E. Silva  
City Engineer  
Clerk of Works


Signature of Property Owner or Representative

INSPECTOR'S REPORT

INSPECTED BY: [Signature]  
DATE: 9/19/12  
COMMENTS:

APPROVED DISAPPROVED

SIGNATURE

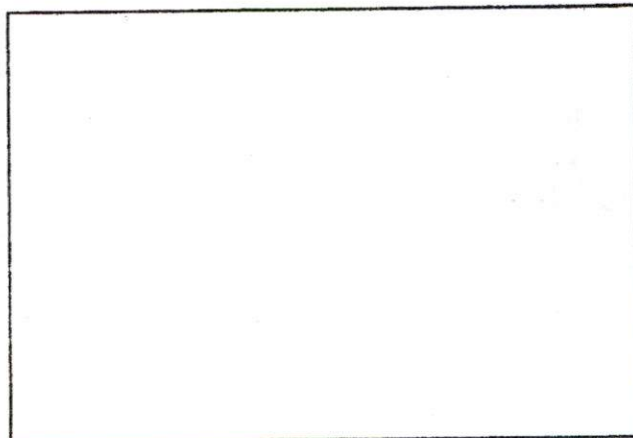

SKETCH PLAN



**DISPLAY PERMIT IN A CONSPICUOUS PLACE ON THE PREMISES**



Commonwealth of Massachusetts  
**City of New Bedford**  
133 William Street New Bedford, MA 02740  
**SEWER PERMIT**



Date: **10/2/2012**

No. **WW-12-25**

Sewer Connection Fee: **\$450.00**

Pipe Size: **0.00**

Trench Length: **0.00**

Service Location: **NS SPARROW ST**

Owner Name: **DACOSTA CARLOSPINHANCOS**

Type of Occupancy: **Residential**

Type of Work: **Sewer - New Sewer Service**

Work Description: **SEWER PERMIT # 24297 - CONNECT 6" INTO NEW 8" SEWER MAIN IN SPARROW ST**

No. of Units : **3**

Required Design Daily Flow : **330.00**

Provided Daily Flow : **330.00**

The undersigned petitions you to grant permission to ENTER INTO THE MAIN SEWER and, if such permission is granted, hereby agrees to the following:

1. To abide by the conditions and regulations imposed by the Commissioner of Public Works by statute or by ordinance now in force, or as amended from time to time.
2. That the connection of said sewer with the main sewer shall be inspected by an employee of the department of Public Works or by a designated agent of the Town before burial of said connection.
3. That the work shall at all times be under the direction and control of the Commissioner of Public Works or his authorized agent, and that any expense incurred by the Town shall be charged to the permittee, and said permittee agrees to reimburse the Town for said expense.

Installing Company Name: \_\_\_\_\_ License Type: \_\_\_\_\_

Address: \_\_\_\_\_ City/Town/State: \_\_\_\_\_

**GRANTED WITH THE USUAL CONDITIONS**

\_\_\_\_\_  
COMMISSIONER

**Call (781) 942-9077 For Inspection**

CITY OF NEW BEDFORD  
INSPECTIONAL SERVICES  
APPLICATION FOR BUILDING PERMIT  
DEPARTMENT/COMMISSION REVIEW

Received

JUL 05 2007

The attached Application for the Building Permit has been submitted to the Department of Public Infrastructure and is requested for the following location:

PLOT 138 LOT 239 NO. SPARROW ST.  
BY: Carlos La Costa On behalf of the owner Same  
STREET (N.S.) 40' E. X HANSON ST.

Due to the type of construction proposed by this application the Inspectional Superintendent has determined that this application for Building Permit should be reviewed by the departments and/or commissions indicated below. Plans and specifications accompanying this application are available for review in the Inspectional Services Department. After you have reviewed this application and the submitted building plans, please provide your comments in the space provided below attaching additional information as necessary and return this form to the Inspectional Services Department no later than

7/17/07 This review form must be signed by a person authorized to conduct review on behalf of your Department or Commission.

REVIEW REQUESTED BY THE FOLLOWING CITY DEPARTMENTS

- |  |   |                                      |
|--|---|--------------------------------------|
| <input type="checkbox"/> AIRPORT COMMISSION OFFICE                   | <input type="checkbox"/> INSPECTIONAL SERVICES        | <input type="checkbox"/> DPI (WATER) |
| <input type="checkbox"/> ASSESSOR'S DEPARTMENT                       | <input type="checkbox"/> HEALTH                       |                                      |
| <input type="checkbox"/> ENVIRONMENTAL STEWARDSHIP<br>(CONSERVATION) | <input type="checkbox"/> WIRE                         |                                      |
| <input type="checkbox"/> HISTORICAL COMMISSION                       | <input type="checkbox"/> PLUMBING                     |                                      |
| <input checked="" type="checkbox"/> ENGINEERING                      | <input type="checkbox"/> OTHER <u>Fire Prevention</u> |                                      |
| <input type="checkbox"/> TREASURES OFFICE                            | <input type="checkbox"/> PLANNING DEPARTMENT          |                                      |

DEPARTMENT/COMMISSION REVIEW COMMENTS

VIEWED SUBMITTED BUILDING PLANS ☐ YES ☐ NO  
OMMENTS:

RECOMMENDED ACTION

COMMENDED BUILDING PERMIT BE ☐ APPROVED ☐ REJECTED  
APPROVED CONDITIONALLY

NDITIONS:

A Rider will need to be recorded at the Registry of Deeds prior to Building Permit being issued. Engineering Dept. must receive a copy of the recorded document.  
Eng. Rosa DPI-Engineering 7/6/07

ECOMMENDATION OF PERMIT REJECTION IS MADE, CITE SPECIFIC REASONS  
TINENT LAW

CITY OF NEW BEDFORD  
INSPECTIONAL SERVICES  
APPLICATION FOR BUILDING PERMIT  
DEPARTMENT/COMMISSION REVIEW

Received

JUL 05 2007

The attached Application for the Building Permit has been submitted to the Building Department and is requested for the following location:

Department of  
Public Infrastructure

138 PLOT 239 LOT Sparrow St. NO. STREET

BY: Carlos La Costa On behalf of the owner Same

Due to the type of construction proposed by this application the Inspectional Superintendent has determined that this application for Building Permit should be reviewed by the departments and/or commissions indicated below. Plans and specifications accompanying this application are available for review in the Inspectional Services Department. After you have reviewed this application and the submitted building plans, please provide your comments in the space provided below attaching additional information as necessary and return this form to the Inspectional Services Department no later than

7/17/07 This review form must be signed by a person authorized to conduct review on behalf of your Department or Commission.

REVIEW REQUESTED BY THE FOLLOWING CITY DEPARTMENTS

- |  |   |   |
|--|---|---|
| <input type="checkbox"/> AIRPORT COMMISSION OFFICE                   | <input type="checkbox"/> INSPECTIONAL SERVICES        | <input checked="" type="checkbox"/> DPI (WATER) |
| <input type="checkbox"/> ASSESSOR'S DEPARTMENT                       | <input type="checkbox"/> HEALTH                       |   |
| <input type="checkbox"/> ENVIRONMENTAL STEWARDSHIP<br>(CONSERVATION) | <input type="checkbox"/> WIRE                         |   |
| <input type="checkbox"/> HISTORICAL COMMISSION                       | <input type="checkbox"/> PLUMBING                     |   |
| <input type="checkbox"/> ENGINEERING                                 | <input type="checkbox"/> OTHER <u>Fire Prevention</u> |   |
| <input type="checkbox"/> TREASURES OFFICE                            | <input type="checkbox"/> PLANNING DEPARTMENT          |   |

DEPARTMENT/COMMISSION REVIEW COMMENTS

REVIEWED SUBMITTED BUILDING PLANS ☐ YES ☐ NO  
COMMENTS:

RECOMMENDED ACTION

RECOMMENDED BUILDING PERMIT BE ☐ APPROVED ☐ REJECTED  
☒ APPROVED CONDITIONALLY

CONDITIONS: OWNER TO APPLY FOR A MAIN PIPE EXTENSION, AND WATER  
PERMIT, SUBMIT ENGINEER'S PLAN FOR DEPT. APPROVAL

IF RECOMMENDATION OF PERMIT REJECTION IS MADE, CITE SPECIFIC REASONS &  
PERTINENT LAW.

NO. 5366-07

**APPLICATION TO BUILD**

**TO INSPECTOR OF BUILDINGS:**

7/6/ 19-2007

CARLOS DA COSTA has this day made

application for the line and grade of SPARROW ST. (N.S.)

40' E. X MONSON ST.

in front of property of CARLOS DA COSTA

31-600

Quarte M. Andrade  
COMMISSIONER OF PUBLIC WORKS  
ACTING CITY ENGINEER

Permit  
Number:

195507 10/10/07

CITY of NEW BEDFORD BUILDING DEPT.

Location: SPARROW St.

Plot: 138 Lot: 239 Zone:

Contractor: OWNER

Address: SAME

License No.: Telephone: 774-2638134

Property Owner: CARLOS DACOSTA

Address: 510 HAWTHORN St.

License:

Building Use: SING. FAM.

PERMIT STIPULATION

DIRECTION TO INSPECTOR

Foundation

# RECORD OF INSPECTIONS


Inspector:	<i>M. W. L.</i>	11/9/07
Location:		
Foundation, set backs and		
Sideyards:		
Center Beams, Floor Joists:		
Framing:		
Exterior Work:		
Insulation:		
Closing In:		
Heating:		
Egresses:		
Stairs, Handrails:		
Safety Reqm'ts:		
Street Paved:		
Off Street Parking:		
Insp. Certificate:		
Fee Payment:		

## INSPECTOR NOTES

*Forting FOUND. INST. } 11/9/07*  
*MOIST PROOF APPLIED*

Approved Use or Occupancy	
By:	<i>M. W. L.</i> 11/9/07
Filing or Certificate	
By:	<i>Dennis J. Pomeroy</i>



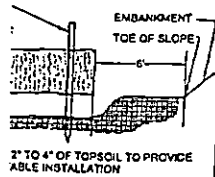


HAYBALE  
INSTALLATION  
DETAIL  
(TO SCALE)

WOODEN POST  
PROPEX "SILT STOP" SEDIMENT  
CONTROL FABRIC (OR EQUAL)  
STRESS REINFORCEMENT BAND

NATIVE SOIL  
PTH  
TRENCH

FENCE  
INSTALLATION  
DETAIL  
(TO SCALE)

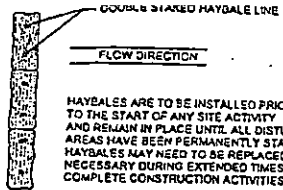

HAYBALE  
PLACEMENT  
DETAIL  
(NOT TO SCALE)


## ZONING REQUIREMENTS:

ZONING IS RA - RESIDENCE A

MINIMUM LOT FRONTAGE	75.00'
MINIMUM TOTAL AREA	8,000 sq. ft.
MAXIMUM % LOT COVERAGE	30% (Required)

### SETBACK REQUIREMENTS:

MINIMUM FRONT YARD	20.00' (or Avg)
MINIMUM REAR & SIDE YARD	8.0' & 12.0'
% LOT COVERAGE PROVIDED	17.6%

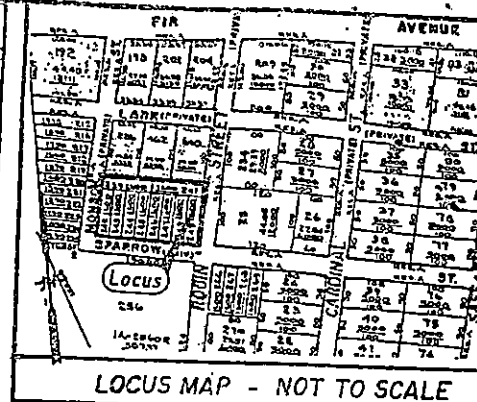

### REQUEST FOR DETERMINATION / NOTICE OF INTENT NOTES:

1. Site is not located within an estimated habitat of rare wetland wildlife species.
2. Locus is not located within a Special Flood Hazard Zone A as delineated on Flood Insurance Rate Map #255216-0005 dated 1-5-84.
3. It is the Contractor's Responsibility to secure a copy of the Recorded Order Conditions and all necessary permits prior to any site activity.
4. A Preconstruction Conference, if required, is to be held between the Contractor and the Conservation Agent prior to construction.
5. Any Siltation Fencing or Hayboles are to be installed, as shown on the site plan prior to any activity and are to remain in place until all activities are complete and vegetation established.
6. Any Substantial Silt Accumulation against the silt fence is to be removed by labor. All Construction Litter and Debris is to be removed from the vicinity of Silt Fence or haybale line daily.
7. NO Refueling of Vehicles is allowed within 100ft. of the resource area.
8. If a Certificate of Compliance is required at the completion of the project, not the Conservation Agent and the Engineering Co. for any required inspections, reports or as-built plans that may be required.
9. Existing utilities shown have been taken from surface evidence obtained by on ground survey. No representation as to the accuracy or completeness of these shown is made by the surveyor/engineer. Verification of utilities and locations the responsibility of the contractor with the aid of DIG SAFE and other respective utility companies.
10. Property lines shown are approximate and taken from Assessor Maps and Plat Record and not the result of a perimeter type survey.

### PLAN TO ACCOMPANY REQUEST FOR DETERMINATION

Scale: 1" = 40'

Date: MAY 9, 2007

Checked by: S.M.B

Drawn by: L.C. Hall

prepared for: CARLOS DaCOSTA  
ASSESSOR MAP 138, LOTS 239, & 241-249

ALPHA ENGINEERING  
32 VALERIE STREET, NEW BEDFORD, MA. 02740


SE 1459-0

SP-392C?



REV. 6-29-07 BLDG. LOCATION


WETLANDS AS DELINEATED BY  
WETLANDS CONSULTING INC.  
DATED 4-20-07

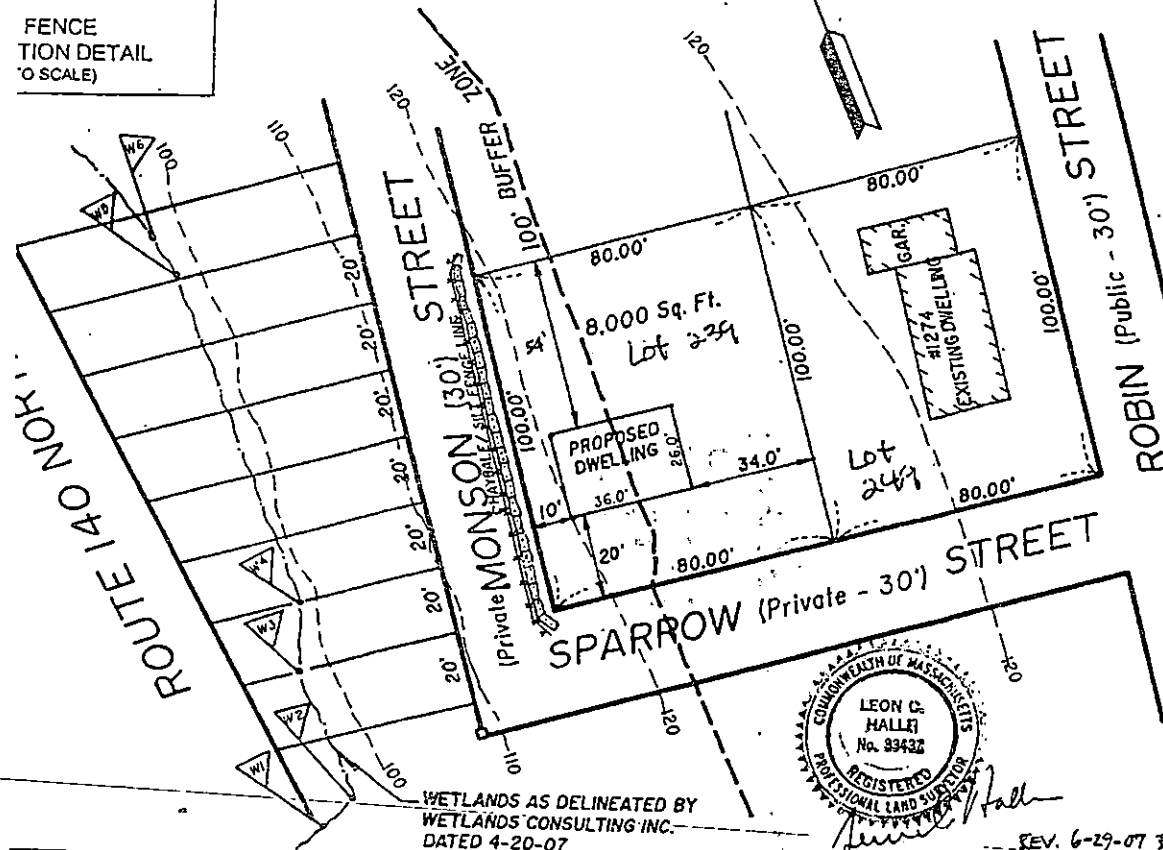







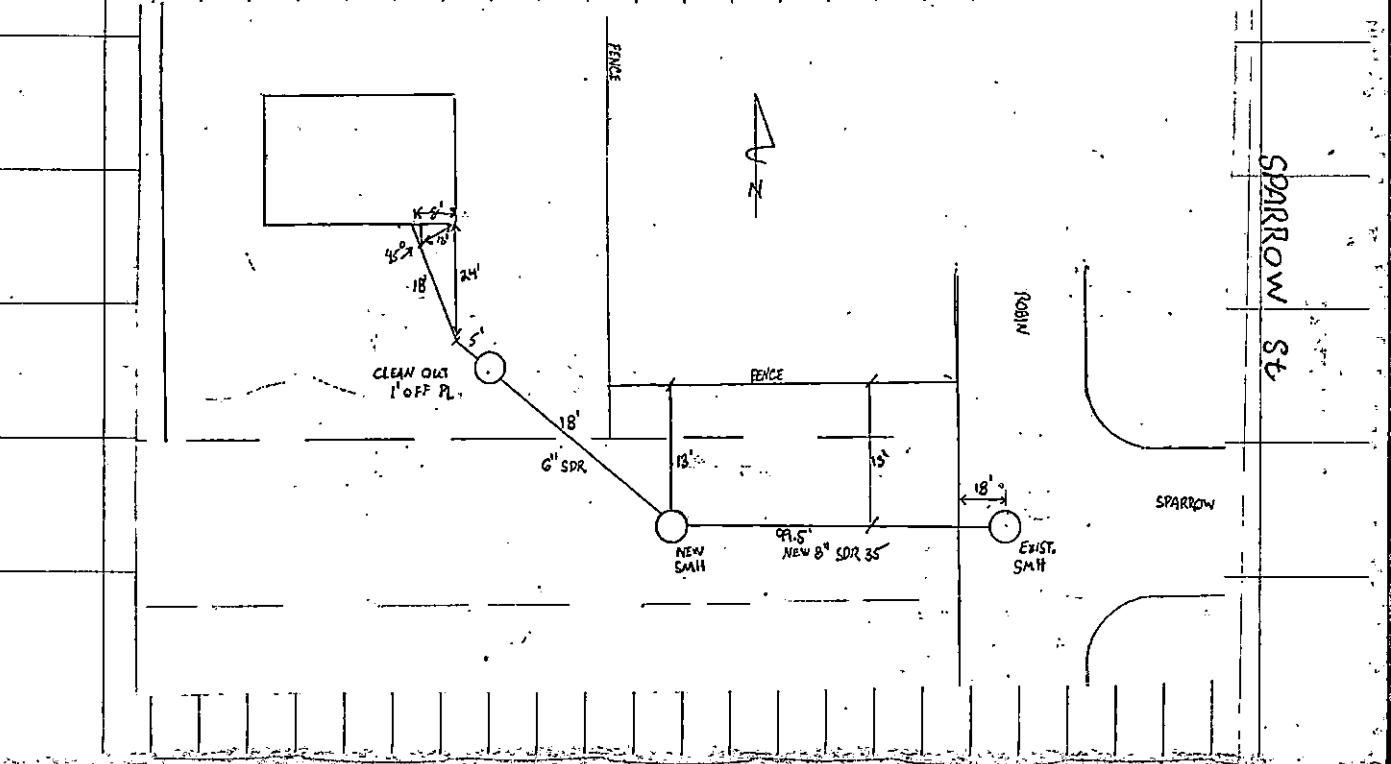

SEWER INSPECTION/TILE-IN

DATE: 9/19/2012

CONTRACTOR: MHT EXCAVATING

INSR. R. BICHEL

PERMIT #: 24296

PLOT 138 LOT 239