



PERMIT NO.

CITY OF NEW BEDFORD
SEWER AND/OR STORM DRAIN PERMIT

DATE 10/9/10

24302

This certifies that permission is granted to

Property Owner Elisario Pires Address 26 Angene Avenue Tel. (508) 985-0908
Assessor's Plot 92 Lot 292

To connect a sewer and/or storm drain located at (E.S.) x JEAN ST to the sewer and/or storm drain in JEAN ST 10 inch Street

To be laid in accordance with the conditions in this application and the City of New Bedford ordinances.

TYPE OF USE: RESIDENTIAL COMMERCIAL INDUSTRIAL FLOW 110 G.P.D.

If applicant other than actual property owner, attach Letter of Authorization from Property Owner.

Name N/A Tel.

Mailing Address N/A

The Bonded Contractor/Drain Layer authorized to perform this work is:

Name R.J. Conessa Address P.O. Box 51643 Tel. (508) 991-8210

Type of Pipe Required: SDR 35 D.O.

PERMIT EXPIRES ONE YEAR AFTER DATE OF ISSUE

- Requires separate connections for sewage and storm drain where applicable. Storm water cannot be discharged to a sanitary sewer.
 - All work must be inspected and approved by a D.P.I. inspector before backfilling.
 - If this connection is to be part of a private service shared jointly with other building owners, attach copy of Recorded Joint Maintenance Agreement.
 - Permits can be issued to Industrial and/or Commercial Applicants only upon receipt and approval by the Commissioner of Public Infrastructure of required plans and supplemental information.
 - In addition, a City-issued Industrial User Discharge Permit and/or a Sewer Extension/Connection Permit issued by the Commonwealth of Massachusetts D.E.P. shall be required by the City for Industrial Discharge into the sewer system.
- Industrial User Discharge Permit No. Date

Comm. Mass. Sewer Conn./Ext. Permit No. Date
A Filing and Inspection Fee of \$ 450, plus an Entrance Fee of \$ N/A where applicable, must accompany this application.

Bank# Sovereign Bank Check# 3905 Date 10/9/10 Receipt# 096616

Other requirements: Please call ahead 24 hr. notice for inspection
@ (508) 991-6150

Connection made to Sewer Part of jointly-shared private line YES NO
Storm Drain

Applicant agrees to abide by the above terms, as well as all pertinent ordinances of the City of New Bedford, and such other special rules as the Commissioner of Public Infrastructure and/or City Engineer may deem necessary


Michael E. Silva
City Engineer
Clerk of the Works

[Signature]
Signature of Property Owner or Representative

INSPECTOR'S REPORT

INSPECTED BY: [Signature]
DATE: 10/12/12
COMMENTS:

APPROVED [Signature] DISAP
SIGNATURE

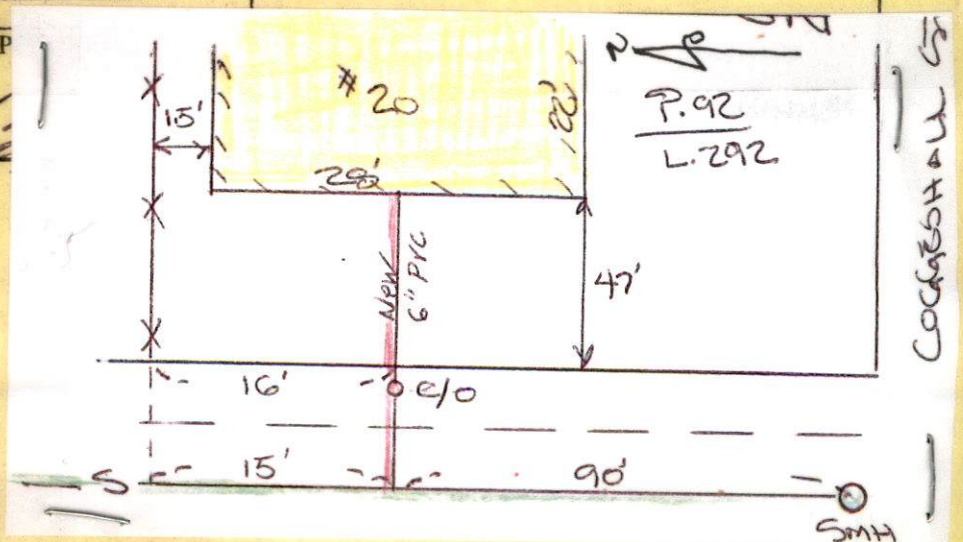



PERMIT NO.

24302

WW-12-32

CITY OF NEW BEDFORD
SEWER AND/OR STORM DRAIN PERMIT

DATE 10/9/12
Expires 10/9/13

This certifies that permission is granted to

Elisario Mies

Property Owner

26 Angora Avenue

Address

Acushnet MA 02743

(508) 985-0968

Tel.

To connect a sewer and/or storm drain located at (E.S.) x Jean St 130 ft S x Sawyer

Assessor's Plot 92 Lot 292, to the sewer and/or storm drain in Jean St 10 inch Street

To be laid in accordance with the conditions in this application and the City of New Bedford ordinances.

TYPE OF USE: RESIDENTIAL

COMMERCIAL

INDUSTRIAL

FLOW 110 G.P.D.

If applicant other than actual property owner, attach Letter of Authorization from Property Owner.

Name

N/A

Tel.

Mailing Address

The Bonded Contractor/Drain Layer authorized to perform this work is:

Name R.J. Conessa

Address P.O. Box 51643

Tel. (508) 988-8210

Type of Pipe Required: SDR 35

DR

PERMIT EXPIRES ONE YEAR AFTER DATE OF ISSUE

- Requires separate connections for sewage and storm drain where applicable. Storm water cannot be discharged to a sanitary sewer.
 - All work must be inspected and approved by a D.P.I. inspector before backfilling.
 - If this connection is to be part of a private service shared jointly with other building owners, attach copy of Recorded Joint Maintenance Agreement.
 - Permits can be issued to Industrial and/or Commercial Applicants only upon receipt and approval by the Commissioner of Public Infrastructure of required plans and supplemental information.
 - In addition, a City-issued Industrial User Discharge Permit and/or a Sewer Extension/Connection Permit issued by the Commonwealth of Massachusetts D.E.P. shall be required by the City for Industrial Discharge into the sewer system.
- Industrial User Discharge Permit No. Date

Comm. Mass. Sewer Conn./Ext. Permit No. Date

A Filing and Inspection Fee of \$ 450.00, plus an Entrance Fee of \$ N/A, where applicable, must accompany this application.

Bank# Sovereign Bank Check# 3905 Date 10/9/12 Receipt# 09616

Other requirements: Please call ahead 24 hr notice for inspection

(508) 991-6150

Connection made to Sewer Part of jointly-shared private line YES NO
Storm Drain

Applicant agrees to abide by the above terms, as well as all pertinent ordinances of the City of New Bedford, and such other special rules as the Commissioner of Public Infrastructure and/or City Engineer may deem necessary

Michael E. Selva

City Engineer

Clerk of the Works

Signature of Property Owner or Representative

INSPECTOR'S REPORT

INSPECTED BY: [Signature]
DATE: 10/12/12
COMMENTS:

APPROVED

DISAPPROVED

SIGNATURE

SKETCH PLAN

DISPLAY PERMIT IN A CONSPICUOUS PLACE ON THE PREMISES



Commonwealth of Massachusetts

City of New Bedford

133 William Street New Bedford, MA 02740

SEWER PERMIT



Date: **10/9/2012**

No. **WW-12-32**

Sewer Connection Fee: **\$450.00**

Pipe Size: **0.00**

Trench Length: **0.00**

Service Location: **20 JEAN ST**

Owner Name: **E REIS PAINTNG CONTRACTORS**

Type of Occupancy: **Residential**

Type of Work: **Sewer - New Sewer Service**

Work Description: **(E.S) X JEAN sT 130 FT S X SAWYER ST TO CONNECT SEWER TO 10 INCH ON JEAN STREET**

No. of Units : **1** Required Design Daily Flow : **0.00** Provided Daily Flow : **110.00**

The undersigned petitions you to grant permission to ENTER INTO THE MAIN SEWER and, if such permission is granted, hereby agrees to the following:

1. To abide by the conditions and regulations imposed by the Commissioner of Public Works by statute or by ordinance now in force, or as amended from time to time.
2. That the connection of said sewer with the main sewer shall be inspected by an employee of the department of Public Works or by a designated agent of the Town before burial of said connection.
3. That the work shall at all times be under the direction and control of the Commissioner of Public Works or his authorized agent, and that any expense incurred by the Town shall be charged to the permittee, and said

permittee

agrees to reimburse the Town for said expense.

Installing Company Name: **Robert J. Canessa**

License Type: **DPI - Other**

Address: **P. O. Box 51643**

City/Town/State: **New Bedford**

MA

GRANTED WITH THE USUAL CONDITIONS

COMMISSIONER



Call (781) 942-9077 For Inspection

- Counting Bld -

20 JEAN ST

2nd Floor

Bath Room

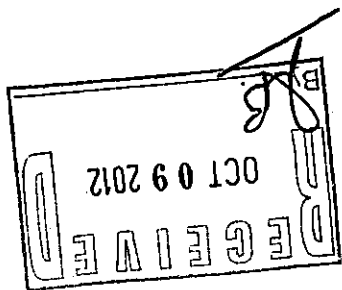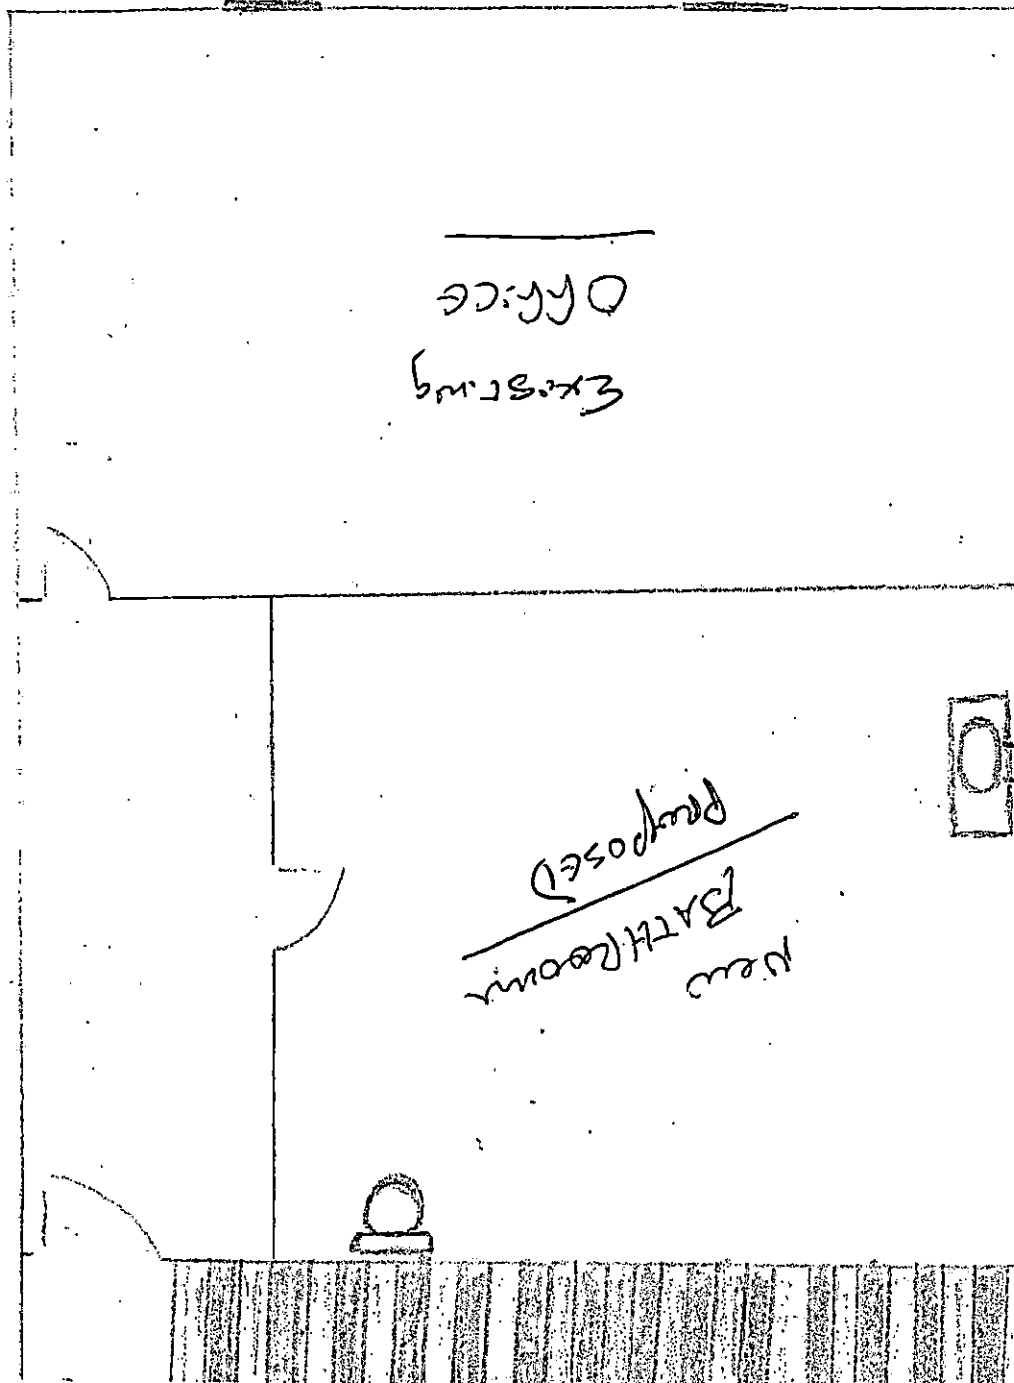

NEED
COPY -
Contractors
- Williams's Comp.
IF Faxed
ADDRESS



Massachusetts Department of Transportation
Board of Engineering Registration

Construction Supervisor

License CS-049980



MICHAEL A BERNIER
24 AMIES WAY
WESTPORT MA 02790

Thomas M. McGee

09/18/2014

Ana S. Rosa

From: James E. Berube
Sent: Friday, October 05, 2012 9:01 AM
To: Ana S. Rosa
Cc: Danny Romanowicz
Subject: RE: Eli Reis-P92/L292 (using illegal address of 20 Jean St.)

Good morning Ana, Mr Reis will have to add onto his existing permit 1st before he can install his bathroom. He should be aware of this ,if not I'll inform him of this. We just sent him there to see if water and sewer could be installed into the property jim b.


From: Ana S. Rosa
Sent: Thursday, October 04, 2012 11:17 AM
To: James E. Berube
Cc: Danny Romanowicz; Zeb Arruda
Subject: Eli Reis-P92/L292 (using illegal address of 20 Jean St.)

Hi Jim,

Mr. Eli Reis came in a short while ago. He said that you told him to speak with Zeb and that the Building Permit issued to him for "Change of Tenant" will cover the bathroom he is proposing to install in the office space he has over this 2 stall garage (previously a 3 stall garage that was on the same lot as the house just north of it, until it got subdivided out onto a separate lot).


When Mr. Reis came in yesterday to pull permits to install water and sewer to this structure and his Building Permit only said "Change of Tenant", we didn't know if this bathroom installation had been approved by Inspectional Services. We looked up the property on the City System, and on the tax parcel screen it is listed as an Accessory Building (Code 106). We wanted to make sure D.P.I. was not issuing water and sewer permits to what could potentially become an "apartment over a garage rental property" without the consent of Inspectional Services, since the Building Permit only said "Change of Tenant". As far as we are concerned, if you and Danny are o.k. with D.P.I. issuing Mr. Reis water and sewer permits to service this structure, and you've discussed it with Zeb, then Mr. Reis should be all set. When Zeb heads back into the office, I will speak to him. Mr. Reis is having R. J. Canessa do the work, and Mr. Reis said Canessa would provide us with a sketch of where the water and the sewer is going to be installed, and what size services, etc...

As far as Mr. Reis's illegal address is concerned, I explained to him that chances are that when this structure was separated from the house lot and the three stall garage was converted to a 2 stall garage with a door access to an upstairs office space, that whoever converted the structure took it upon themselves to slap the number 20 on the structure. Unfortunately, there is no indication on City records that #20 was assigned by the City-Engineering Dept. to this structure when it was separated from the house lot. Being that this structure was originally part of the house lot just north of it, it would not have ever been assigned an independent number from the house, unless the person who owned the property when it was subdivided had properly contacted the City for a legal address for the garage then they sold it as a structure on an independent lot. After they subdivided the property and before they sold it independently, the City should have been contacted to assign a legal address to the structure. I told Mr. Reis I would work with him to get the address issue resolved, and that we'd go out and do the measures for his building and give him a proper legal address which will be forwarded to all departments and private entities (i.e. 911, NSTAR, Verizon, Comcast, etc...).

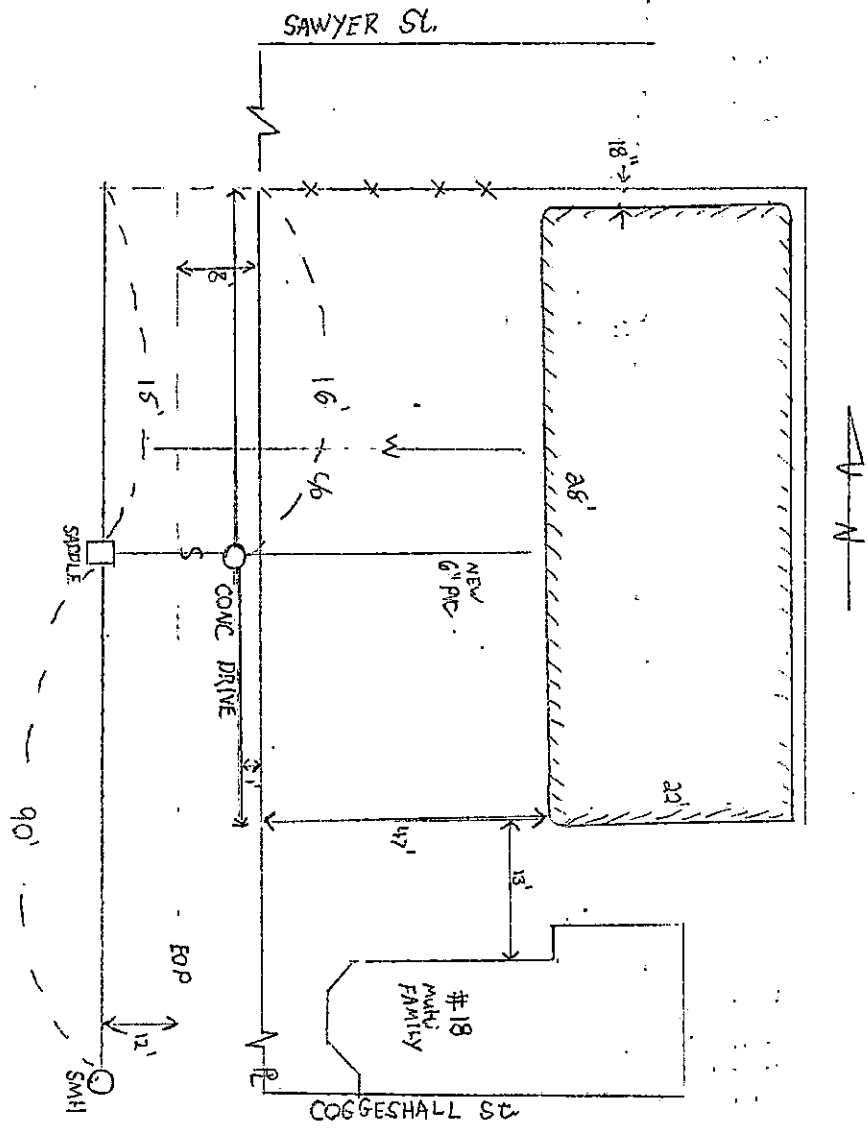

JEAN ST.

SAVYER ST.

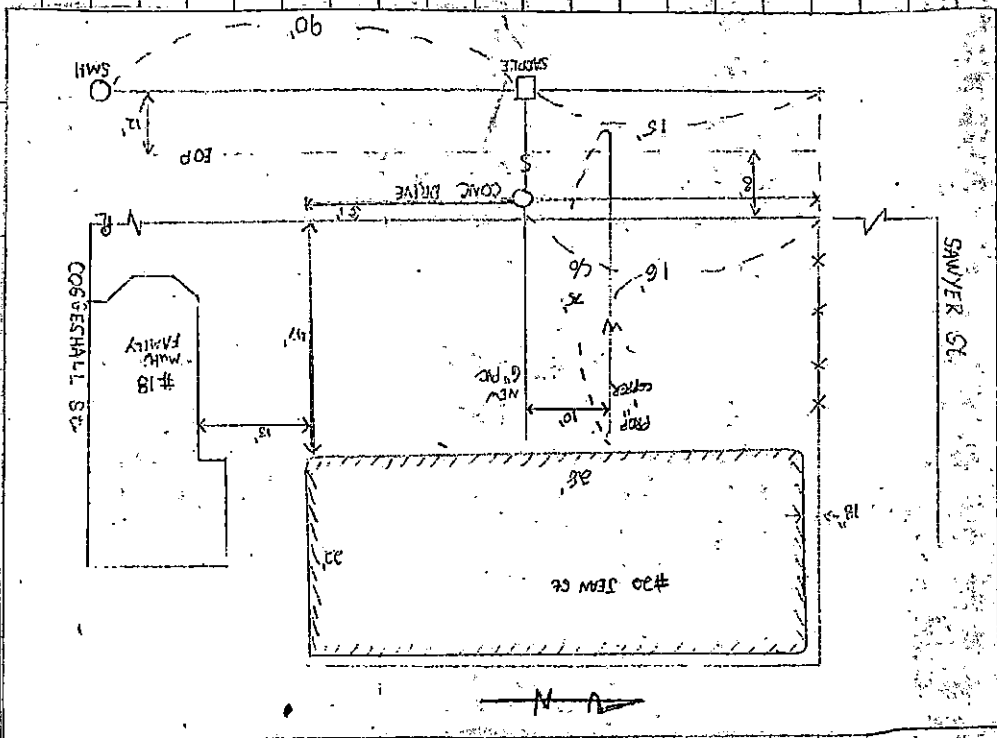

SEWER INSPECTION

DATE: 10/12/2015

CONTRACTOR: R.J. CANESSA

INSR: R. BICHEL

PERMIT #: 24302

PLOT 92 LOT 292