



PERMIT NO.

CITY OF NEW BEDFORD  
SEWER AND/OR STORM DRAIN PERMIT

DATE 2/20/13

24321

This certifies that permission is granted to

Property Owner Christopher Simmons Address 1160 Rockdale Avenue Tel. (508) 326-7261

To connect a sewer and/or storm drain located at Rockdale Avenue (E) Side 200' S of Sawyer St

Assessor's Plot 81 Lot 162, to the sewer and/or storm drain in Rockdale Avenue Street

To be laid in accordance with the conditions in this application and the City of New Bedford ordinances.  
TYPE OF USE: RESIDENTIAL COMMERCIAL INDUSTRIAL FLOW 830 G.P.D.

If applicant other than actual property owner, attach Letter of Authorization from Property Owner.  
Name Christopher Simmons Tel. (508) 326-7261  
Mailing Address 1160 Rockdale Avenue

The Bonded Contractor/Drain Layer authorized to perform this work is:  
Name P.O. Box 51613 Address PO Box 51613 Tel. (508) 979-3404  
Type of Pipe Required: SDR 35 PVC

PERMIT EXPIRES ONE YEAR AFTER DATE OF ISSUE

- Requires separate connections for sewage and storm drain where applicable. Storm water cannot be discharged to a sanitary sewer.
  - All work must be inspected and approved by a D.P.I. inspector before backfilling.
  - If this connection is to be part of a private service shared jointly with other building owners, attach copy of Recorded Joint Maintenance Agreement.
  - Permits can be issued to Industrial and/or Commercial Applicants only upon receipt and approval by the Commissioner of Public Infrastructure of required plans and supplemental information.
  - In addition, a City-issued Industrial User Discharge Permit and/or a Sewer Extension/Connection Permit issued by the Commonwealth of Massachusetts D.E.P. shall be required by the City for Industrial Discharge into the sewer system.
- Industrial User Discharge Permit No. \_\_\_\_\_ Date \_\_\_\_\_

Comm. Mass. Sewer Conn./Ext. Permit No. \_\_\_\_\_ Date \_\_\_\_\_  
A Filing and Inspection Fee of \$ 450.00, plus an Entrance Fee of \$ \_\_\_\_\_ where applicable, must accompany this application.

Bank# Sovereign Bank Check# 1170 Date 2/20/13 Receipt# 9738

Other requirements: Please call ahead 24 hour notice for inspection @ (508) 979-1550 / Per City-issued Plans as built structure.

Connection made to Sewer Part of jointly-shared private line YES NO  
Storm Drain XNO JUB put in under new structure


Applicant agrees to abide by the above terms, as well as all pertinent ordinances of the City of New Bedford, and such other special rules as the Commissioner of Public Infrastructure and/or City Engineer may deem necessary

Clayton M. Amodeo City Engineer  
Christopher Simmons Signature of Property Owner or Representative

INSPECTOR'S REPORT

INSPECTED BY: \_\_\_\_\_  
DATE: \_\_\_\_\_  
COMMENTS: \_\_\_\_\_

APPROVED \_\_\_\_\_  
SEE WHATE SHEET  
SIGNATURE

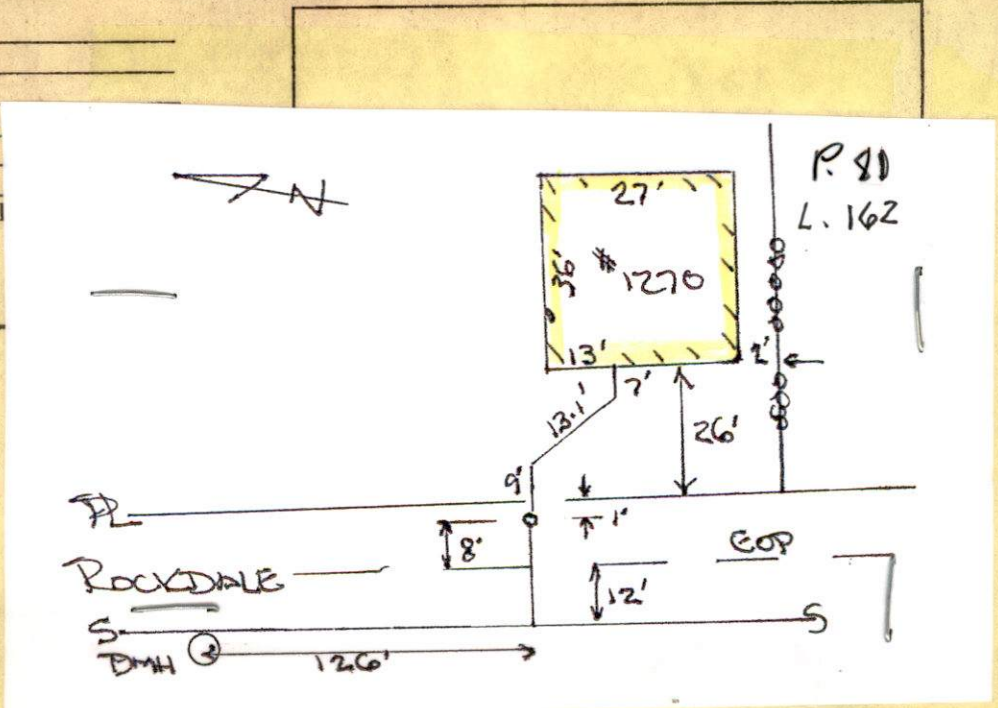





Inspector

PERMIT NO.

CITY OF NEW BEDFORD  
SEWER AND/OR STORM DRAIN PERMIT

DATE 2/20/13

24321

This certifies that permission is granted to

Christopher Simmons 1160 Rockdale Avenue (508) 326-7261  
Property Owner Address New Bedford NB, MA 02748 Tel.

To connect a sewer and/or storm drain located at Rockdale Avenue (E) Side 300' S x Sawyer St.

Assessor's Plot 81 Lot 162, to the sewer and/or storm drain in Rockdale Avenue Street

To be laid in accordance with the conditions in this application and the City of New Bedford ordinances.

TYPE OF USE: RESIDENTIAL COMMERCIAL INDUSTRIAL FLOW 330 G.P.D.

If applicant other than actual property owner, attach Letter of Authorization from Property Owner.

Name N/A Tel.

Mailing Address N/A

The Bonded Contractor/Drain Layer authorized to perform this work is:

R.O. Conessa P.O. Box 51643 Tel. (508) 998-3404

Name Address Type of Pipe Required: SDR 35 PVC

PERMIT EXPIRES ONE YEAR AFTER DATE OF ISSUE

- Requires separate connections for sewage and storm drain where applicable. Storm water cannot be discharged to a sanitary sewer.
  - All work must be inspected and approved by a D.P.I. inspector before backfilling.
  - If this connection is to be part of a private service shared jointly with other building owners, attach copy of Recorded Joint Maintenance Agreement.
  - Permits can be issued to Industrial and/or Commercial Applicants only upon receipt and approval by the Commissioner of Public Infrastructure of required plans and supplemental information.
  - In addition, a City-issued Industrial User Discharge Permit and/or a Sewer Extension/Connection Permit issued by the Commonwealth of Massachusetts D.E.P. shall be required by the City for Industrial Discharge into the sewer system.
- Industrial User Discharge Permit No. Date

Comm. Mass. Sewer Conn./Ext. Permit No. Date

A Filing and Inspection Fee of \$450.00, plus an Entrance Fee of \$ where applicable, must accompany this application.

Bank# Sovereign Bank Check# 1170 Date 2/20/13 Receipt# 9738

Other requirements: Please call ahead 24 hour notice for inspection @ (508) 999-1550 / Per Attached Plan as built structure.

Connection made to Sewer Storm Drain Part of jointly-shared private line YES NO

Applicant agrees to abide by the above terms, as well as all pertinent ordinances of the City of New Bedford, and such other special rules as the Commissioner of Public Infrastructure and/or City Engineer may deem necessary

David M. Amodeo  
City Engineer

Signature of Property Owner or Representative

INSPECTOR'S REPORT

INSPECTED BY: [Signature]  
DATE: 7/3/13  
COMMENTS:

APPROVED

DISAPPROVED

SIGNATURE

SKETCH PLAN

PERMIT NO.



CITY OF NEW BEDFORD  
SEWER AND/OR STORM DRAIN PERMIT

DATE 2/20/13

24321

This certifies that permission is granted to

Property Owner Christopher Simmons Address 1160 Rockdale Avenue New Bedford NB, MA 02740 Tel. (508) 326-7261

To connect a sewer and/or storm drain located at Rockdale Avenue (E) Side 300' +/- S x Sawyer St  
Assessor's Plot 81 Lot 162 to the sewer and/or storm drain in Rockdale Avenue 8" sewer on Street

To be laid in accordance with the conditions in this application and the City of New Bedford ordinances.

TYPE OF USE: RESIDENTIAL COMMERCIAL INDUSTRIAL FLOW 330 G.P.D.

If applicant other than actual property owner, attach Letter of Authorization from Property Owner.

Name N/A Tel.

Mailing Address N/A

The Bonded Contractor/Drain Layer authorized to perform this work is:

Name P.O. Box 51643 Address  Tel. (508) 998-3404

Type of Pipe Required: S.D.R. 35 PVC

PERMIT EXPIRES ONE YEAR AFTER DATE OF ISSUE

- Requires separate connections for sewage and storm drain where applicable. Storm water cannot be discharged to a sanitary sewer.
  - All work must be inspected and approved by a D.P.I. inspector before backfilling.
  - If this connection is to be part of a private service shared jointly with other building owners, attach copy of Recorded Joint Maintenance Agreement.
  - Permits can be issued to Industrial and/or Commercial Applicants only upon receipt and approval by the Commissioner of Public Infrastructure of required plans and supplemental information.
  - In addition, a City-issued Industrial User Discharge Permit and/or a Sewer Extension/Connection Permit issued by the Commonwealth of Massachusetts D.E.P. shall be required by the City for Industrial Discharge into the sewer system.
- Industrial User Discharge Permit No.  Date

Comm. Mass. Sewer Conn./Ext. Permit No.  Date   
A Filing and Inspection Fee of \$ 450.00 plus an Entrance Fee of \$  where applicable, must accompany this application.

Bank# Sovereign Bank Check# 1170 Date 2/20/13 Receipt# 9738

Other requirements: Please call ahead 24 hour notice for inspection @ (508) 979-1550 / Per Attached Plan as built structure.

Connection made to Sewer Part of jointly-shared private line YES NO  
Storm Drain X NO Sub put in under main St project

Applicant agrees to abide by the above terms, as well as all pertinent ordinances of the City of New Bedford, and such other special rules as the Commissioner of Public Infrastructure and/or City Engineer may deem necessary

Dan M. Amodeo  
City Engineer

Clark of The Works


Signature of Property Owner or Representative

INSPECTOR'S REPORT

INSPECTED BY:   
DATE:   
COMMENTS:

APPROVED DISAPPROVED

SIGNATURE

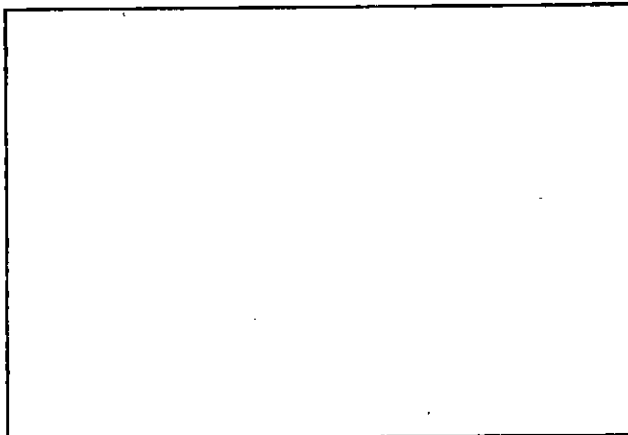

SKETCH PLAN



Commonwealth of Massachusetts

# City of New Bedford

133 William Street New Bedford, MA 02740

## SEWER PERMIT



Date: **3/26/2013**

No. **WW-13-6**

Sewer Connection Fee: **\$450.00**

Pipe Size: **0.00**

Trench Length: **0.00**

Service Location: **1160 ROCKDALE AVE**

Owner Name: **SIMMONS CHRISTOPHER**

Type of Occupancy: **Commercial**

Type of Work: **Sewer - New Sewer Service**

Work Description: **installing sewer service**

**Rockdale Avenue E Side  
302 +/- S x Sawyer St**

**into 8"sewer On Rockdale Ave**

**P81  
L162  
SEWER PERMIT #24321**

**\*No stub put under Row St Project**

No. of Units : **0** Required Design Daily Flow : **0.00** Provided Daily Flow : **0.00**

Installing Company Name: **Robert J. Canessa**

License Type: **DPI - Other**

Address: **P. O. Box 51643** City/Town/State: **New Bedford MA**

**Call (781) 942-9077 For Inspection**

Receiver

APPLICATION/AGREEMENT

For Trench/Disturbance Permit within the City of New Bedford

Permit # 233-13  
Dig Safe # 2013-260-8567

JUN 27 2013

Date 06/27/2013  
6510-01/1

TO THE MAYOR AND CITY COUNCIL:

DISTURBANCE PERMIT/TRENCH SAFETY PERMIT

Department of  
Public Infrastructure

Permission is hereby requested to excavate the surface of: ☒ City Property and/or ☒ Private Property

Location of Work: 1270 Backdale Avenue

Provide Sketch  
Roadway closures will require  
Authorization from the  
Commissioner of Public  
Infrastructure. Traffic Management  
Plans may be required.

Substantially as per plan annexed, for the purpose of: Installing Sewer/Water

Sewer Permit # 24321 Water Service # 33726

Work will begin (weather permitting) on: 6/28/13

CONTRACTORS ARE TO CALL THE  
DPI OFFICE AT 508-991-6150 - 24 HRS.  
PRIOR TO ANY EXCAVATION (NON-  
COMPLIANCE WILL RESULT IN  
IMMEDIATE REVOCATION OF BONDS

Work will end (weather permitting) on: 7/28/13

Applicant Name: Robert J. Camesa

Excavator(s) Name: R. J. Camesa

Company Name: R. J. Camesa Excavation

Hoisting Equipment License Number: 137555  
Grade: 2A Expiration Date: 7/24/2014

Contact Number: 5089161144

Name & Contact Number of Insurer: Ben Omerouti/508-673-5808

Competent Person on Work Site: Bob Camesa

APPROVED BY: Dan M. Amador DATE: 6/27/13

TITLE: Close of the Works

This permit shall be posted at the work site, and shall remain until the work is completed. It is subject to inspection at all times.



RJ CAISSA  
Sewer Tie-in

7/3/13  
RJ

