



PERMIT NO.

24343

CITY OF NEW BEDFORD  
SEWER AND/OR STORM DRAIN PERMIT

DATE 6/7/13

expires 6/7/14

This certifies that permission is granted to

Joseph Lech Jr. 45 Ethel St. 508-965-8026  
Property Owner Address Tel.

To connect a sewer and/or storm drain located at 870 ~~Stafford St~~ Terry Ln.

Assessor's Plot 132A Lot 747 to the sewer and/or storm drain in 2" LPEM in Terry Ln. Street

To be laid in accordance with the conditions in this application and the City of New Bedford ordinances.

TYPE OF USE: RESIDENTIAL COMMERCIAL INDUSTRIAL FLOW G.P.D.

If applicant other than actual property owner, attach Letter of Authorization from Property Owner.

Name R.J. Carassa Tel. 508-971-4911

Mailing Address Same

The Bonded Contractor/Drain Layer authorized to perform this work is:

Name R.J. Carassa Address PO Box 51643 Tel. 508-971-4911

Type of Pipe Required: SDR 35 PVC

PERMIT EXPIRES ONE YEAR AFTER DATE OF ISSUE

- Requires separate connections for sewage and storm drain where applicable. Storm water cannot be discharged to a sanitary sewer.
- All work must be inspected and approved by a D.P.I. inspector before backfilling.
- If this connection is to be part of a private service shared jointly with other building owners, attach copy of Recorded Joint Maintenance Agreement.
- Permits can be issued to Industrial and/or Commercial Applicants only upon receipt and approval by the Commissioner of Public Infrastructure of required plans and supplemental information. *SEE NOTE BELOW*
- In addition, a City-issued Industrial User Discharge Permit and/or a Sewer Extension/Connection Permit issued by the Commonwealth of Massachusetts D.E.P. shall be required by the City for Industrial Discharge into the sewer system.

Industrial User Discharge Permit No. Date

Comm. Mass. Sewer Conn./Ext. Permit No. Date

A Filing and Inspection Fee of \$450, plus an Entrance Fee of \$ where applicable, must accompany this application.

Bank# Bay Coast Check# 7872 Date 6/10/13 Receipt# 10075

Other requirements: Please call ahead 24 hrs for inspection at 508-979-1550 ext 506. Sewer stub already at property line.

Connection made to Sewer Part of jointly-shared private line YES NO  
Storm Drain

\*THIS SERVICE REQUIRES THE SSLATERAL KIT TO BE SUPPLIED BY E-ONE

Applicant agrees to abide by the above terms, as well as all pertinent ordinances of the City of New Bedford, and such other special rules as the Commissioner of Public Infrastructure and/or City Engineer may deem necessary

City Engineer

Signature of Property Owner or Representative

INSPECTOR'S REPORT

INSPECTED BY:


DATE:

COMMENTS:

APPROVED

DISA

SIGNATURE

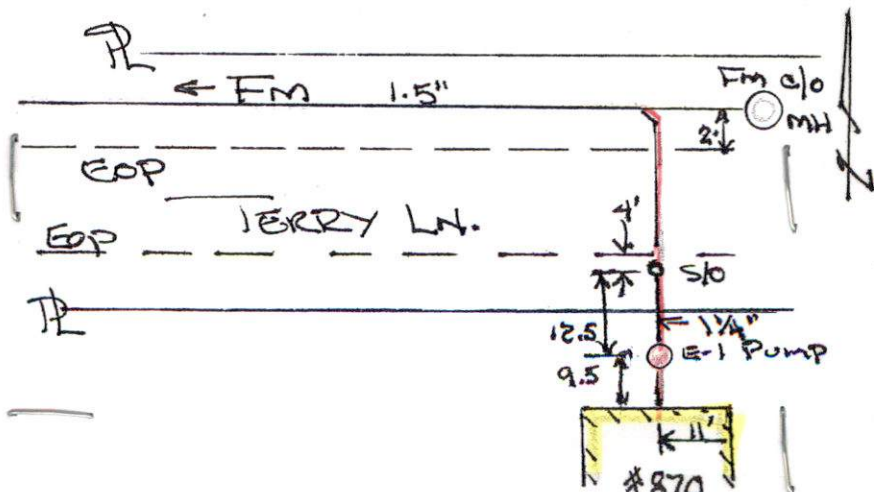



11-15-17



PERMIT NO.  
24343

CITY OF NEW BEDFORD  
SEWER AND/OR STORM DRAIN PERMIT

DATE 6/7/13  
expires 6/7/14

This certifies that permission is granted to

Joseph Lech Jr. 45 Ethel St. 508-965-8026  
Property Owner Address Tel.

To connect a sewer and/or storm drain located at 870 ~~Chaffee St~~ Terry Ln.

Assessor's Plot 130A Lot 747 to the sewer and/or storm drain in 2" LPFM in Terry Ln Street

To be laid in accordance with the conditions in this application and the City of New Bedford ordinances.

TYPE OF USE: RESIDENTIAL COMMERCIAL INDUSTRIAL FLOW G.P.D.

If applicant other than actual property owner, attach Letter of Authorization from Property Owner.

Name R.J. Canessa Tel. 508-971-4911

Mailing Address Same

The Bonded Contractor/Drain Layer authorized to perform this work is:

Name RJ Canessa Address PO Box 51643 Tel. 508-971-4911  
Type of Pipe Required: SDR 35 PVC

PERMIT EXPIRES ONE YEAR AFTER DATE OF ISSUE

- Requires separate connections for sewage and storm drain where applicable. Storm water cannot be discharged to a sanitary sewer.
  - All work must be inspected and approved by a D.P.I. inspector before backfilling.
  - If this connection is to be part of a private service shared jointly with other building owners, attach copy of Recorded Joint Maintenance Agreement.
  - Permits can be issued to Industrial and/or Commercial Applicants only upon receipt and approval by the Commissioner of Public Infrastructure of required plans and supplemental information. \*SEE NOTE BELOW
  - In addition, a City-issued Industrial User Discharge Permit and/or a Sewer Extension/Connection Permit issued by the Commonwealth of Massachusetts D.E.P. shall be required by the City for Industrial Discharge into the sewer system.
- Industrial User Discharge Permit No. Date

Comm. Mass. Sewer Conn./Ext. Permit No. Date  
A Filing and Inspection Fee of \$450 plus an Entrance Fee of \$ where applicable, must accompany this application.

Bank# Bay Coast Check# 7872 Date 6/10/13 Receipt# 16075

Other requirements: Please call ahead 24 hrs for inspection at 508-979-1550 ext 506. Sewer stub already at property line.

Connection made to Sewer Storm Drain Part of jointly-shared private line YES NO

\*THIS SERVICE REQUIRES THE SSLATERAL KIT TO BE SUPPLIED BY E-ONE

Applicant agrees to abide by the above terms, as well as all pertinent ordinances of the City of New Bedford, and such other special rules as the Commissioner of Public Infrastructure and/or City Engineer may deem necessary


City Engineer

Signature of Property Owner or Representative

INSPECTOR'S REPORT

INSPECTED BY: DATE: 6/13/13 COMMENTS:

APPROVED DISAPPROVED  
SIGNATURE

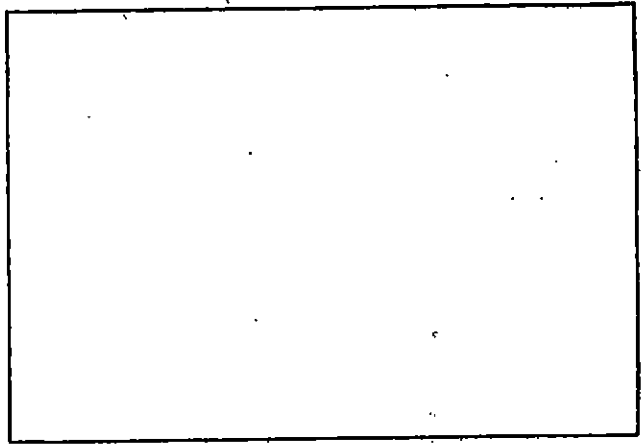

SKETCH PLAN



Dr. Lawrence  
M. Fa. Services  
9/10/13  
②

