



PERMIT NO.

24347

CITY OF NEW BEDFORD
SEWER AND/OR STORM DRAIN PERMIT

DATE 6/19/13

This certifies that permission is granted to

David + Melissa Wojnar 35 Ludlow St. Acushnet, MA
Property Owner Address Tel.

To connect a sewer and/or storm drain located at 35 Ludlow St. Acushnet
Assessor's Plot 24 Lot 15-R, to the sewer and/or storm drain in Ludlow Street

To be laid in accordance with the conditions in this application and the City of New Bedford ordinances.

TYPE OF USE: RESIDENTIAL COMMERCIAL INDUSTRIAL FLOW 330 G.P.D.

If applicant other than actual property owner, attach Letter of Authorization from Property Owner.

Name Town of Acushnet Tel. 508-998-0230

Mailing Address

The Bonded Contractor/Drain Layer authorized to perform this work is: Greco Const.

Name Address Tel.

Type of Pipe Required: 6" SDR 35

PERMIT EXPIRES ONE YEAR AFTER DATE OF ISSUE

- Requires separate connections for sewage and storm drain where applicable. Storm water cannot be discharged to a sanitary sewer.
- All work must be inspected and approved by a D.P.I. inspector before backfilling.
- If this connection is to be part of a private service shared jointly with other building owners, attach copy of Recorded Joint Maintenance Agreement.
- Permits can be issued to Industrial and/or Commercial Applicants only upon receipt and approval by the Commissioner of Public Infrastructure of required plans and supplemental information.
- In addition, a City-issued Industrial User Discharge Permit and/or a Sewer Extension/Connection Permit issued by the Commonwealth of Massachusetts D.E.P. shall be required by the City for Industrial Discharge into the sewer system.

Industrial User Discharge Permit No. Date

Comm. Mass. Sewer Conn./Ext. Permit No. Date

A Filing and Inspection Fee of \$450., plus an Entrance Fee of \$ where applicable, must accompany this application.

Bank# Bank of America Check# 16371 Date 6/19/13 Receipt# 10092

Other requirements: install sewer service into new sewer man. extension

Connection made to Sewer Part of jointly-shared private line YES NO
Storm Drain

Applicant agrees to abide by the above terms, as well as all pertinent ordinances of the City of New Bedford, and such other special rules as the Commissioner of Public Infrastructure and/or City Engineer may deem necessary


Donna Amato City Engineer
Signature of Property Owner or Representative 6/19/13

INSPECTOR'S REPORT

INSPECTED BY:
DATE:
COMMENTS:

APPROVED DISA

SEE WHITE SHEET
SIGNATURE

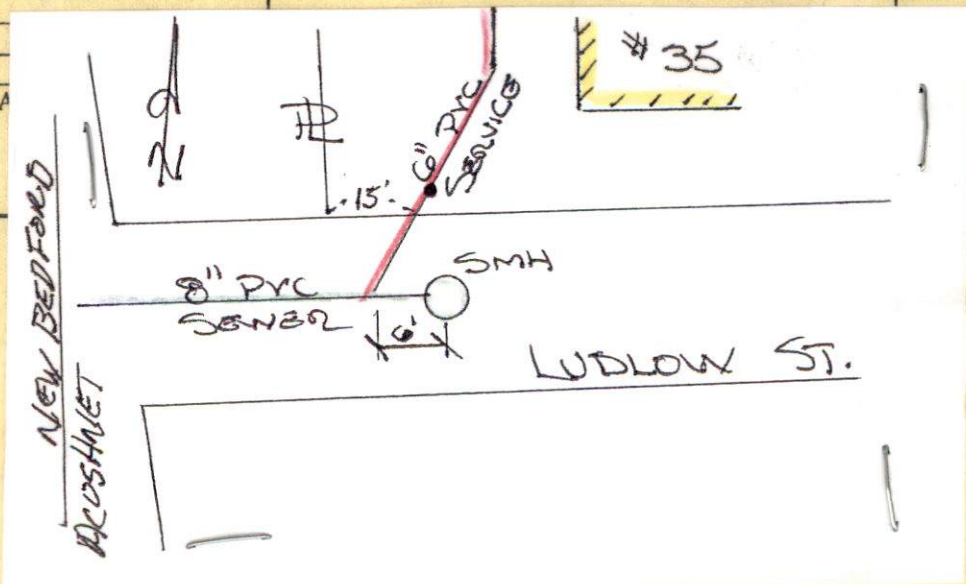



PERMIT NO.

24347

CITY OF NEW BEDFORD
SEWER AND/OR STORM DRAIN PERMIT

DATE 6/19/13

This certifies that permission is granted to

DAVID + MELISSA WOJNAR 35 Ludlow St. Acushnet, MA
Property Owner Address Tel.

To connect a sewer and/or storm drain located at 35 Ludlow St. Acushnet
Acushnet Assessor's Plot 24 Lot 15-R, to the sewer and/or storm drain in Ludlow Street

To be laid in accordance with the conditions in this application and the City of New Bedford ordinances.

TYPE OF USE: RESIDENTIAL COMMERCIAL INDUSTRIAL FLOW 330 G.P.D.

If applicant other than actual property owner, attach Letter of Authorization from Property Owner.

Name: Town at Acushnet Tel: 508-998-0230

Mailing Address:

The Bonded Contractor/Drain Layer authorized to perform this work is: Greico Const.

Name Address Tel.

Type of Pipe Required: 6" SDR 35

PERMIT EXPIRES ONE YEAR AFTER DATE OF ISSUE

- Requires separate connections for sewage and storm drain where applicable. Storm water cannot be discharged to a sanitary sewer.
 - All work must be inspected and approved by a D.P.I. inspector before backfilling.
 - If this connection is to be part of a private service shared jointly with other building owners, attach copy of Recorded Joint Maintenance Agreement.
 - Permits can be issued to Industrial and/or Commercial Applicants only upon receipt and approval by the Commissioner of Public Infrastructure of required plans and supplemental information.
 - In addition, a City-issued Industrial User Discharge Permit and/or a Sewer Extension/Connection Permit issued by the Commonwealth of Massachusetts D.E.P. shall be required by the City for Industrial Discharge into the sewer system.
- Industrial User Discharge Permit No. Date.

Comm. Mass. Sewer Conn./Ext. Permit No. Date.

A Filing and Inspection Fee of \$450., plus an Entrance Fee of \$ where applicable, must accompany this application.

Bank# Bank of America Check# 16371 Date 6/19/13 Receipt# 10092

Other requirements: install sewer service into new sewer
man extension

Connection made to Sewer Part of jointly-shared private line YES NO
Storm Drain

Applicant agrees to abide by the above terms, as well as all pertinent ordinances of the City of New Bedford, and such other special rules as the Commissioner of Public Infrastructure and/or City Engineer may deem necessary.

Donna Amadio
City Engineer

6/19/13
Signature of Property Owner or Representative


INSPECTOR'S REPORT

INSPECTED BY: [Signature]
DATE: 6/19/13
COMMENTS:

APPROVED

DISAPPROVED

SIGNATURE

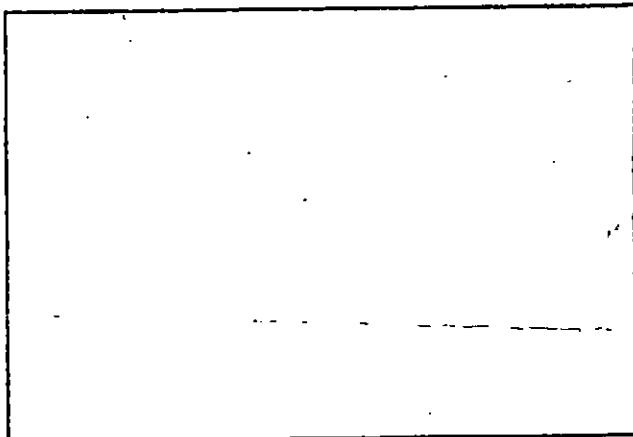

SKETCH PLAN

Acushnet

Expires: 6/19/14



PERMIT NO.

24347

CITY OF NEW BEDFORD
SEWER AND/OR STORM DRAIN PERMIT

DATE 6/19/13

This certifies that permission is granted to

DAVID + Melissa Wojnar 35 Ludlow St. Acushnet, MA
Property Owner Address Tel.

To connect a sewer and/or storm drain located at 35 Ludlow St. Acushnet
Assessor's Plot 24 Lot 15-R, to the sewer and/or storm drain in Ludlow Street

To be laid in accordance with the conditions in this application and the City of New Bedford ordinances.
TYPE OF USE: RESIDENTIAL COMMERCIAL INDUSTRIAL FLOW 330 G.P.D.

If applicant other than actual property owner, attach Letter of Authorization from Property Owner.
Name Town of Acushnet Tel. 508-998-0230
Mailing Address

The Bonded Contractor/Drain Layer authorized to perform this work is: Greico Const.
Name Address Tel.
Type of Pipe Required: 6" SDR 35

PERMIT EXPIRES ONE YEAR AFTER DATE OF ISSUE

- Requires separate connections for sewage and storm drain where applicable. Storm water cannot be discharged to a sanitary sewer.
- All work must be inspected and approved by a D.P.I. inspector before backfilling.
- If this connection is to be part of a private service shared jointly with other building owners, attach copy of Recorded Joint Maintenance Agreement.
- Permits can be issued to Industrial and/or Commercial Applicants only upon receipt and approval by the Commissioner of Public Infrastructure of required plans and supplemental information.
- In addition, a City-issued Industrial User Discharge Permit and/or a Sewer Extension/Connection Permit issued by the Commonwealth of Massachusetts D.E.P. shall be required by the City for Industrial Discharge into the sewer system.

Industrial User Discharge Permit No. Date

Comm. Mass. Sewer Conn./Ext. Permit No. Date
A Filing and Inspection Fee of \$450., plus an Entrance Fee of \$ where applicable, must accompany this application.

Bank# Bank of America Check# 16371 Date 6/19/13 Receipt# 10092

Other requirements: install sewer service into new sewer
main extension

Connection made to Sewer Part of jointly-shared private line YES NO
Storm Drain

Applicant agrees to abide by the above terms, as well as all pertinent ordinances of the City of New Bedford, and such other special rules as the Commissioner of Public Infrastructure and/or City Engineer may deem necessary


Donna M. Amadio City Engineer
Clerk of the Works
Signature of Property Owner or Representative 6/19/13

INSPECTOR'S REPORT

INSPECTED BY: _____
DATE: _____
COMMENTS: _____

APPROVED DISAPPROVED

SIGNATURE

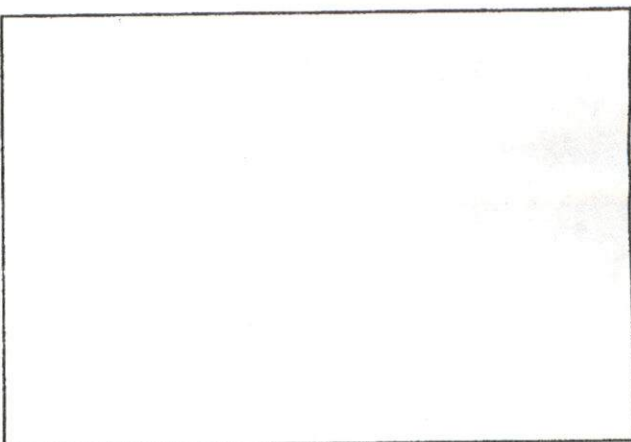

SKETCH PLAN

✓



DRAIN	#40
	LUDLOW ST. 7145 - ACUSHNET, MA
Permit	P.24 L.15
No. 23095-01	
Enters	INTERSECTION LUDLOW & BARTLETT
Drain Plot No.	
From Property of THOMAS HEYS JR.	
Inspected by Joseph Martin on 7/11/01 - said to see Acushnet D.P.W. for As-Built. See back of card for sewer connection plan.	
31-910	

DRAIN	ACUSHNET
	#35 LUDLOW ST.
Permit	150' EAST of BARTLETT ST.
No. 24347-2013	
Enters	LUDLOW
Drain Plot No.	184
From Property of DAVID & MELISSA WOJNAR	
31-910	

DRAIN	ACUSHNET
	35 LUDLOW ST.
SEWER EXTENSION Permit	ACUSH. P. 24 L. 15R
No. 24346-2013	
Enters	LUDLOW ST.
Drain Plot No.	184
From Property of DAVID & MELISSA WOJNAR	
31-910	

