



PERMIT NO.  
24367

CITY OF NEW BEDFORD  
SEWER AND/OR STORM DRAIN PERMIT

DATE 11/21/13

This certifies that permission is granted to

Property Owner Dennis Demos Address 32 Nye Avenue Tel. (508) 995-9674  
Acushnet, MA 02718

To connect a sewer and/or storm drain located at Acushnet Avenue (E.S.) 160' x Sharon Street

Assessor's Plot 137A Lot 3, to the sewer and/or storm drain in Finish sewer on Sharon Street

To be laid in accordance with the conditions in this application and the City of New Bedford ordinances.

TYPE OF USE: RESIDENTIAL COMMERCIAL INDUSTRIAL FLOW        G.P.D.

If applicant other than actual property owner, attach Letter of Authorization from Property Owner.

Name Suzanne Ellis Tel. (508) 995-9674

Mailing Address 32 Nye Avenue - Acushnet, MA 02743

The Bonded Contractor/Drain Layer authorized to perform this work is:

Name        Address        Tel.       

Type of Pipe Required: SDM PVC 35

PERMIT EXPIRES ONE YEAR AFTER DATE OF ISSUE

- Requires separate connections for sewage and storm drain where applicable. Storm water cannot be discharged to a sanitary sewer.
- All work must be inspected and approved by a D.P.I. inspector before backfilling.
- If this connection is to be part of a private service shared jointly with other building owners, attach copy of Recorded Joint Maintenance Agreement.
- Permits can be issued to Industrial and/or Commercial Applicants only upon receipt and approval by the Commissioner of Public Infrastructure of required plans and supplemental information.
- In addition, a City-issued Industrial User Discharge Permit and/or a Sewer Extension/Connection Permit issued by the Commonwealth of Massachusetts D.E.P. shall be required by the City for Industrial Discharge into the sewer system.

Industrial User Discharge Permit No.        Date       

Comm. Mass. Sewer Conn./Ext. Permit No.        Date       

A Filing and Inspection Fee of \$       , plus an Entrance Fee of \$        where applicable, must accompany this application.

Bank# Citi 1200 Bank Check# 2250 Date 11/21/13 Receipt# 09920

Other requirements: Please call ahead 24 hr notice for inspection

(508) 979-1550 ext. 502

Connection made to Sewer Part of jointly-shared private line YES NO  
Storm Drain

Applicant agrees to abide by the above terms, as well as all pertinent ordinances of the City of New Bedford, and such other special rules as the Commissioner of Public Infrastructure and/or City Engineer may deem necessary

Dennis Demos City Engineer Dennis Demos Signature of Property Owner or Representative

INSPECTOR'S REPORT

INSPECTED BY:       


DATE:       

COMMENTS:       

APPROVED

DISAP

SEE WHITE SHEET  
SIGNATURE

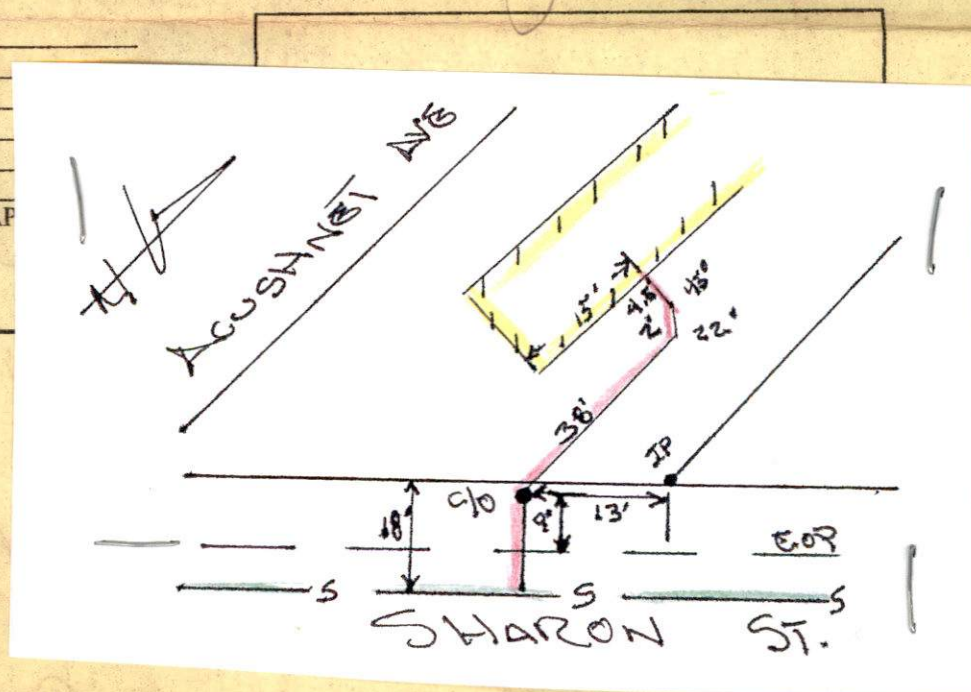





Inspector *COPY*  
Sewer inspection: Dec 26 @ 1:00 PM  
Monday DATE 12/13

PERMIT NO.  
24367

CITY OF NEW BEDFORD  
SEWER AND/OR STORM DRAIN PERMIT

This certifies that permission is granted to

Property Owner Dennis Demee Address 32 Nye Avenue Tel. (508) 995-9674  
Cashnet, MA 02743

To connect a sewer and/or storm drain located at Cashnet Avenue (E.S.) 160' Wx Sharon Street,  
Assessor's Plot 137A Lot 3, to the sewer and/or storm drain in 8 inch sewer on Sharon Street

To be laid in accordance with the conditions in this application and the City of New Bedford ordinances.

TYPE OF USE: RESIDENTIAL COMMERCIAL INDUSTRIAL FLOW \_\_\_\_\_ G.P.D.

If applicant other than actual property owner, attach Letter of Authorization from Property Owner.

Name Suzanne Ellis Tel. (508) 995-9674

Mailing Address 32 Nye Avenue - Cashnet, MA 02743

The Bonded Contractor/Drain Layer authorized to perform this work is:

Name \_\_\_\_\_ Address \_\_\_\_\_ Tel. \_\_\_\_\_

Type of Pipe Required: SDM PVC 35

PERMIT EXPIRES ONE YEAR AFTER DATE OF ISSUE

- Requires separate connections for sewage and storm drain where applicable. Storm water cannot be discharged to a sanitary sewer.
- All work must be inspected and approved by a D.P.I. inspector before backfilling.
- If this connection is to be part of a private service shared jointly with other building owners, attach copy of Recorded Joint Maintenance Agreement.
- Permits can be issued to Industrial and/or Commercial Applicants only upon receipt and approval by the Commissioner of Public Infrastructure of required plans and supplemental information.
- In addition, a City-issued Industrial User Discharge Permit and/or a Sewer Extension/Connection Permit issued by the Commonwealth of Massachusetts D.E.P. shall be required by the City for Industrial Discharge into the sewer system.

Industrial User Discharge Permit No. \_\_\_\_\_ Date \_\_\_\_\_

Comm. Mass. Sewer Conn./Ext. Permit No. \_\_\_\_\_ Date \_\_\_\_\_

A Filing and Inspection Fee of \$ \_\_\_\_\_, plus an Entrance Fee of \$ \_\_\_\_\_ where applicable, must accompany this application.

Bank# Citizens Bank Check# 2250 Date 11/21/13 Receipt# 09920

Other requirements: Please call ahead 24hr notice for inspection

(508) 979-1550 ext. 506

Connection made to Sewer Part of jointly-shared private line YES ☒ NO ☐  
Storm Drain

Applicant agrees to abide by the above terms, as well as all pertinent ordinances of the City of New Bedford, and such other special rules as the Commissioner of Public Infrastructure and/or City Engineer may deem necessary

City Engineer Dennis Demee Signature of Property Owner or Representative Dennis Demee

INSPECTOR'S REPORT

INSPECTED BY: [Signature]

DATE: 12/27/13

COMMENTS: \_\_\_\_\_

APPROVED

DISAPPROVED

SIGNATURE

SKETCH PLAN

TWN-13-38

Expenses: 11/21/14



PERMIT NO.  
24367

CITY OF NEW BEDFORD  
SEWER AND/OR STORM DRAIN PERMIT

DATE 11/21/13

This certifies that permission is granted to

Dennis Demee 32 Nye Avenue (508) 995-9674  
Property Owner Address Acushnet, MA 02743 Tel.

To connect a sewer and/or storm drain located at Acushnet Avenue (E.S.) 66' Wx Sharon Street,  
Assessor's Plot 137A Lot 3, to the sewer and/or storm drain in 8 inch sewer on Sharon Street

To be laid in accordance with the conditions in this application and the City of New Bedford ordinances.  
TYPE OF USE: RESIDENTIAL COMMERCIAL INDUSTRIAL FLOW G.P.D.

If applicant other than actual property owner, attach Letter of Authorization from Property Owner.  
Name Suzanne Ellis Tel (508) 995-9674  
Mailing Address 32 Nye Avenue - Acushnet, MA 02743  
The Bonded Contractor/Drain Layer authorized to perform this work is:

Name Address Tel.  
Type of Pipe Required: SDM PVC 35

PERMIT EXPIRES ONE YEAR AFTER DATE OF ISSUE

- Requires separate connections for sewage and storm drain where applicable. Storm water cannot be discharged to a sanitary sewer.
  - All work must be inspected and approved by a D.P.I. inspector before backfilling.
  - If this connection is to be part of a private service shared jointly with other building owners, attach copy of Recorded Joint Maintenance Agreement.
  - Permits can be issued to Industrial and/or Commercial Applicants only upon receipt and approval by the Commissioner of Public Infrastructure of required plans and supplemental information.
  - In addition, a City-issued Industrial User Discharge Permit and/or a Sewer Extension/Connection Permit issued by the Commonwealth of Massachusetts D.E.P. shall be required by the City for Industrial Discharge into the sewer system.
- Industrial User Discharge Permit No. Date.

Comm. Mass. Sewer Conn./Ext. Permit No. Date.  
A Filing and Inspection Fee of \$, plus an Entrance Fee of \$, where applicable, must accompany this application.

Bank# Citizens Bank Check# 2250 Date 11/21/13 Receipt# 09920

Other requirements: Please call ahead 24hr notice for inspection  
Tel (508) 979-1550 ext. 506.

Connection made to Sewer Storm Drain Part of jointly-shared private line YES NO

Applicant agrees to abide by the above terms, as well as all pertinent ordinances of the City of New Bedford, and such other special rules as the Commissioner of Public Infrastructure and/or City Engineer may deem necessary


Dennis M. Demee City Engineer  
Clerk of the Works  
Signature of Property Owner or Representative

INSPECTOR'S REPORT

INSPECTED BY:  
DATE:  
COMMENTS:

APPROVED DISAPPROVED

SIGNATURE

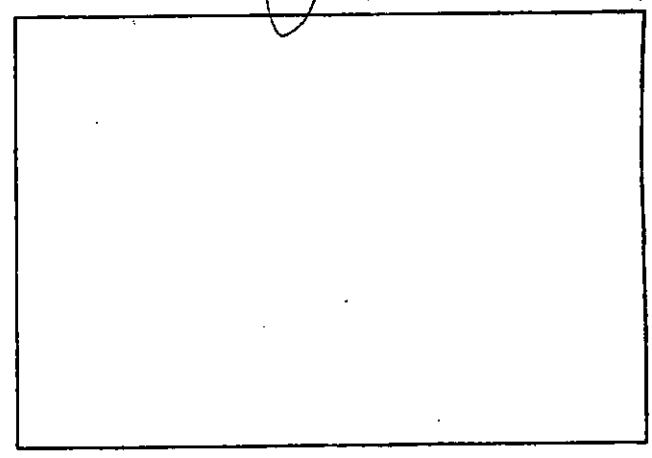

SKETCH PLAN

P

137A

202





Department of Public Infrastructure

Ronald H. Labelle  
Commissioner

CITY OF NEW BEDFORD

Jonathan Mitchell, Mayor

Water  
Wastewater  
Highways  
Engineering  
Cemeteries  
Park Maintenance

To Whom It May Concern:

I Dennis J. Doree, being  
(Name) (Mailing Address)

Owner of property located at

Plot \_\_\_\_\_, Lot 413, hereby agree to allow Shanne Ellis  
(Name)  
32 NYC Avenue, Acushnet MA 02743 to act on my behalf including affixing my  
(Mailing Address)

signature in securing permit for:

☒ Sewer/Drain Service Permits  
☐ Water Service Permits  
☐ Driveway Installation Permits  
☐ Sidewalk Installation Permits

I further agree to conform to, and abide by, All City rules and ask regulations applicable to the permit (s) being applied for:

Name Dennis J. Doree  
Signature

32 NYC Ave Acushnet  
Address

11/14/13  
Date

5089999674  
Telephone number

**DISPLAY PERMIT IN A CONSPICUOUS PLACE ON THE PREMISES**



Commonwealth of Massachusetts  
**City of New Bedford**

133 William Street New Bedford, MA 02740

**SEWER PERMIT**



Date: **2/4/2014**

No. **WW-13-38**

Sewer Connection Fee: **\$450.00**

Pipe Size: **0.00**

Trench Length: **0.00**

Service Location: **ES ACUSHNET AVE**

Owner Name: **DEREE DENNIS JBENNETT PAUL D**

Type of Occupancy: **Residential**

Type of Work: **Sewer - New Sewer Service**

Work Description: **SEWER PERMIT# 24367  
P.137A L3**

**ACUSHNET AVENUE (ES) 66' N X SHARON ST**

**TIEING INTO 8INCH SEWER ON SHARON ST**

No. of Units : **0** Required Design Daily Flow : **0.00** Provided Daily Flow : **0.00**

The undersigned petitions you to grant permission to ENTER INTO THE MAIN SEWER and, if such permission is granted, hereby agrees to the following:

1. To abide by the conditions and regulations imposed by the Commissioner of Public Works by statute or by ordinance now in force, or as amended from time to time.
2. That the connection of said sewer with the main sewer shall be inspected by an employee of the department of Public Works or by a designated agent of the Town before burial of said connection.
3. That the work shall at all times be under the direction and control of the Commissioner of Public Works or his authorized agent, and that any expense incurred by the Town shall be charged to the permittee, and said

permittee

agrees to reimburse the Town for said expense.

Installing Company Name: \_\_\_\_\_ License Type: \_\_\_\_\_

Address: \_\_\_\_\_ City/Town/State: \_\_\_\_\_

**Call (781) 942-9077 For Inspection**



Commonwealth of Massachusetts

# CITY OF NEW BEDFORD

City Hall, Room 308, 133 William Street New Bedford, MA 02740 (508) 979-1540



## FOUNDATION PERMIT

11/4/2013

No. **B-13-2048**

MSBC Sect. 111.8 - Any permit issued shall be deemed abandoned and invalid unless the work authorized by it shall have been commenced within six (6) months after its issuance.

FEE PAID \$**Error**

This certifies that **DEREE DENNIS JBENNETT PAUL D**

owner/contractor has permission to: **ES ACUSHNET AVE**

on: **Foundations Only 1-2 Family - 100.00**

Providing that the person accepting this permit shall in every respect conform to the terms of application therefore on file in this office; to the provisions of the statute of the Commonwealth and to the by-laws of the City of New Bedford relating to the inspection, erection, enlarging, altering, raising, moving, repairing, or tearing down of a building.

Permit is issued subject to the following special requirements: (Restrictions)



**Wiring Inspector**

---

---

---

---



**Plumbing Inspector**

---

---

---

---



**Building Inspector**

---

---

---

---

YOUR AREA INSPECTOR IS: **Thomas Welch**

Tel. (508) 979-1540 Between 8:00am - 9:00am

**NOTICE: NOTIFY INSPECTOR 48 HOURS IN ADVANCE OF APPLYING SHEATHING OR LATHING.**

**OCCUPANCY PERMIT REQUIRED BEFORE OCCUPANCY**

No Building or Structure shall be used or occupied until the Certificate of Use and Occupancy shall have been Issued by the Building Commissioner - MSBC, Sect. 120.1

**This Card Must Be Displayed in a Conspicuous Place on the Premises and Not Torn Down or Removed Until Completion of Work.**

SUBJECT TO MASSACHUSETTS  
STATE BUILDING CODE

*Thomas Welch*

Building Inspector




85.38'



2 U

ACUSHNET AVE.

Channel SW

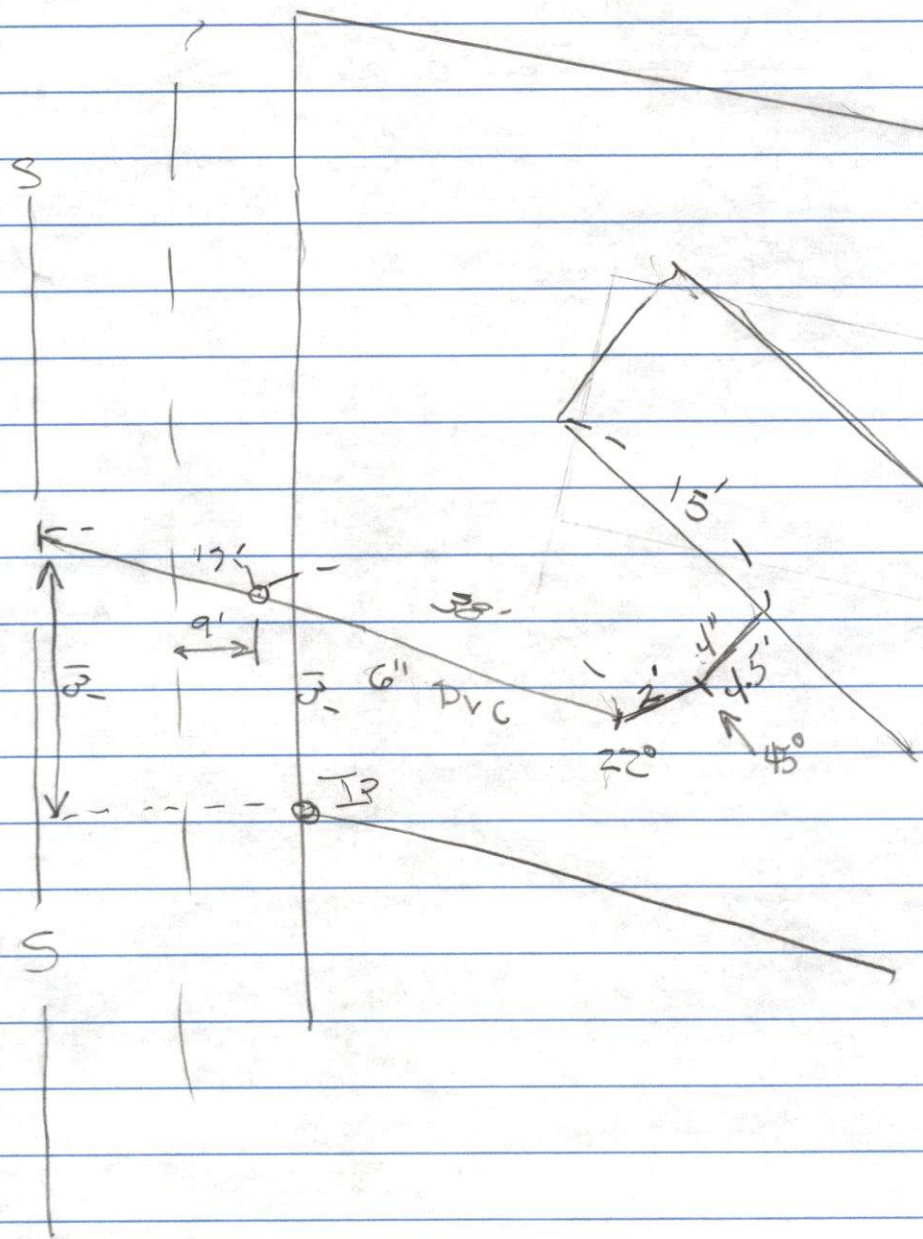

R.J. Canessa  
12/26/13, Main To C/O  
Insp: R. Richel  
12/27/13 C/O To Bldg.