



PERMIT NO.

24380

CITY OF NEW BEDFORD SEWER AND/OR STORM DRAIN PERMIT

DATE 3/19/14 expires 3/19/15

This certifies that permission is granted to

David Cardon 18 Avis St. Dartmouth 508-617-3778

To connect a sewer and/or storm drain located at (W.I.) 627' S x Chaffee St Assessor's Plot 130F Lot 6 to the sewer and/or storm drain in Wildwood Rd Street

To be laid in accordance with the conditions in this application and the City of New Bedford ordinances. TYPE OF USE: RESIDENTIAL COMMERCIAL INDUSTRIAL FLOW G.P.D.

If applicant other than actual property owner, attach Letter of Authorization from Property Owner. Name Mailing Address

The Bonded Contractor/Drain Layer authorized to perform this work is:

Name Chris Mendoza Address Type of Pipe Required: 30" PVC 35

PERMIT EXPIRES ONE YEAR AFTER DATE OF ISSUE

- Requires separate connections for sewage and storm drain where applicable. Storm water cannot be discharged to a sanitary sewer. All work must be inspected and approved by a D.P.I. inspector before backfilling. If this connection is to be part of a private service shared jointly with other building owners, attach copy of Recorded Joint Maintenance Agreement. Permits can be issued to Industrial and/or Commercial Applicants only upon receipt and approval by the Commissioner of Public Infrastructure of required plans and supplemental information. In addition, a City-issued Industrial User Discharge Permit and/or a Sewer Extension/Connection Permit issued by the Commonwealth of Massachusetts D.E.P. shall be required by the City for Industrial Discharge into the sewer system.

Industrial User Discharge Permit No. Date

Comm. Mass. Sewer Conn./Ext. Permit No. Date

A Filing and Inspection Fee of \$450, plus an Entrance Fee of \$ where applicable, must accompany this application.

Bank# Bank Five Check# 2650 Date 3/19/14 Receipt# 13700

Other requirements: Please call ahead 24hrs for inspection.

Must be done according to attached plan.

Connection made to Sewer Part of jointly-shared private line YES NO Storm Drain

Applicant agrees to abide by the above terms, as well as all pertinent ordinances of the City of New Bedford, and such other special rules as the Commissioner of Public Infrastructure and/or City Engineer may deem necessary

David M. Anade City Engineer


Signature of Property Owner or Representative

INSPECTOR'S REPORT

INSPECTED BY: DATE: COMMENTS:

APPROVED DISAPPROVED

SIGNATURE

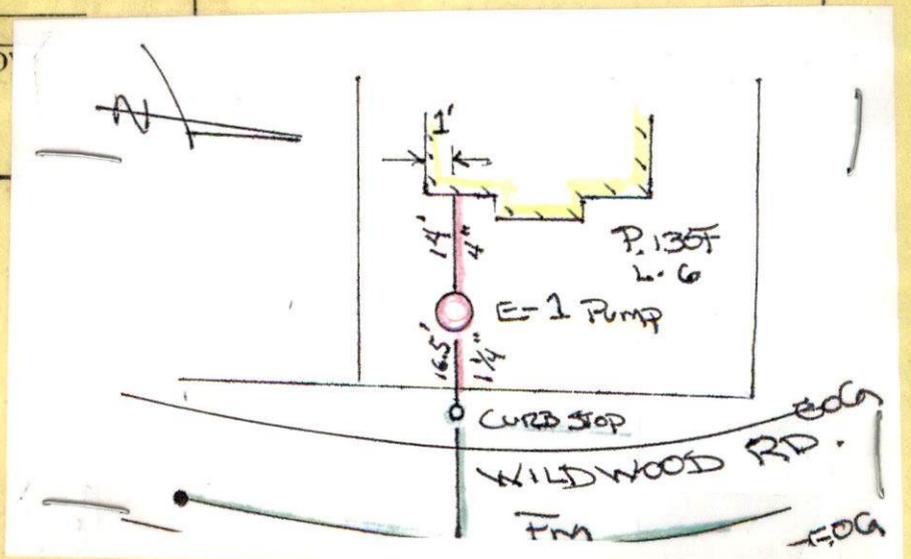

WW-14-8 -



PERMIT NO.

24380

CITY OF NEW BEDFORD  
SEWER AND/OR STORM DRAIN PERMIT

DATE 3/19/14  
expires 3/19/15

This certifies that permission is granted to

David Cardoso 18 Avis St. S Dartmouth 508-617-3778  
Property Owner Address Tel.

To connect a sewer and/or storm drain located at (W.S) 627' S x Chaffee St  
Assessor's Plot 130F Lot 6, to the sewer and/or storm drain in Wildwood Rd Street  
stop @ prop line  
extension # 24330

To be laid in accordance with the conditions in this application and the City of New Bedford ordinances.  
TYPE OF USE: RESIDENTIAL COMMERCIAL INDUSTRIAL FLOW \_\_\_\_\_ G.P.D.

If applicant other than actual property owner, attach Letter of Authorization from Property Owner.  
Name \_\_\_\_\_ Tel. \_\_\_\_\_  
Mailing Address \_\_\_\_\_

The Bonded Contractor/Drain Layer authorized to perform this work is:  
Name Chris Mendoza Address \_\_\_\_\_ Tel. \_\_\_\_\_  
Type of Pipe Required: SDR PVC 35

PERMIT EXPIRES ONE YEAR AFTER DATE OF ISSUE

- Requires separate connections for sewage and storm drain where applicable. Storm water cannot be discharged to a sanitary sewer.
  - All work must be inspected and approved by a D.P.I. inspector before backfilling.
  - If this connection is to be part of a private service shared jointly with other building owners, attach copy of Recorded Joint Maintenance Agreement.
  - Permits can be issued to Industrial and/or Commercial Applicants only upon receipt and approval by the Commissioner of Public Infrastructure of required plans and supplemental information.
  - In addition, a City-issued Industrial User Discharge Permit and/or a Sewer Extension/Connection Permit issued by the Commonwealth of Massachusetts D.E.P. shall be required by the City for Industrial Discharge into the sewer system.
- Industrial User Discharge Permit No. \_\_\_\_\_ Date \_\_\_\_\_

Comm. Mass. Sewer Conn./Ext. Permit No. \_\_\_\_\_ Date \_\_\_\_\_  
A Filing and Inspection Fee of \$ 450, plus an Entrance Fee of \$ \_\_\_\_\_ where applicable, must accompany this application.  
Bank# Bank Five Check# 2650 Date 3/19/14 Receipt# 13700

Other requirements: Please call ahead 24hrs for inspection.  
Must be done according to attached plan.

Connection made to Sewer Part of jointly-shared private line YES NO  
Storm Drain

Applicant agrees to abide by the above terms, as well as all pertinent ordinances of the City of New Bedford, and such other special rules as the Commissioner of Public Infrastructure and/or City Engineer may deem necessary


[Signature]  
City Engineer  
Clark of the Work

[Signature]  
Signature of Property Owner or Representative

INSPECTOR'S REPORT

INSPECTED BY: \_\_\_\_\_  
DATE: \_\_\_\_\_  
COMMENTS: \_\_\_\_\_  
\_\_\_\_\_  
APPROVED DISAPPROVED

\_\_\_\_\_  
SIGNATURE

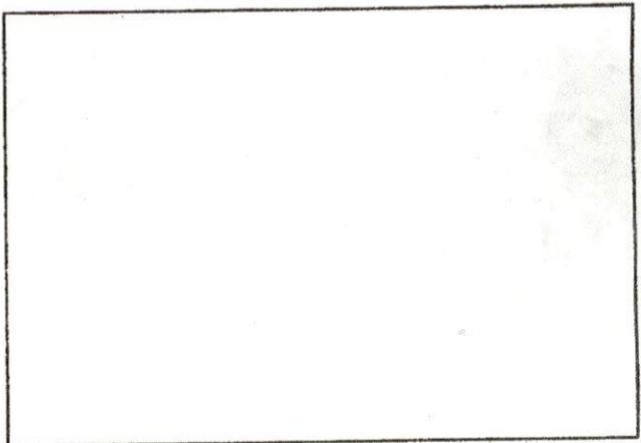

SKETCH PLAN

V ✓

**DISPLAY PERMIT IN A CONSPICUOUS PLACE ON THE PREMISES**



Commonwealth of Massachusetts

**City of New Bedford**

133 William Street New Bedford, MA 02740

**SEWER PERMIT**



Date: **4/23/2014**

No. **WW-14-8**

Sewer Connection Fee: **\$450.00**

Pipe Size: **0.00**

Trench Length: **0.00**

Service Location: **WS WILDWOOD RD**

Owner Name: **CARDOSO DAVID M**

Type of Occupancy: **Residential**

Type of Work: **Sewer - New Sewer Service**

Work Description: **sewer service #24380  
P.130F L.6**

**(W.S.) 627' S x Chaffee St  
stub @ prop line Wildwood Rd**

**Stub @ property line  
extension# 24330**

**permit expires 3/19/15**

No. of Units : **3** Required Design Daily Flow : **330.00** Provided Daily Flow : **0.00**

The undersigned petitions you to grant permission to ENTER INTO THE MAIN SEWER and, if such permission is granted, hereby agrees to the following:

1. To abide by the conditions and regulations imposed by the Commissioner of Public Works by statute or by ordinance now in force, or as amended from time to time.
2. That the connection of said sewer with the main sewer shall be inspected by an employee of the department of Public Works or by a designated agent of the Town before burial of said connection.
3. That the work shall at all times be under the direction and control of the Commissioner of Public Works or his authorized agent, and that any expense incurred by the Town shall be charged to the permittee, and said

permittee agrees to reimburse the Town for said expense.

Installing Company Name: **CHRISTOPHER L. MENDOZA**

License Type: **Hoisting Engineer**

Address: **45 CHASE RD** City/Town/State: **DARTMOUTH MA**

**Call (781) 942-9077 For Inspection**



4/1/14

Tuesday @ 1:30 P.M.

Inspector

PERMIT NO. 24380

CITY OF NEW BEDFORD SEWER AND/OR STORM DRAIN PERMIT

DATE 3/19/14 expires 3/19/15

This certifies that permission is granted to David Cardoso 18 Avila St. S Dartmouth 508-617-3778

To connect a sewer and/or storm drain located at (W.D.) 627' S x Chaffee St. Assessor's Plot 130F Lot 6 to the sewer and/or storm drain in Wildwood Rd

To be laid in accordance with the conditions in this application and the City of New Bedford ordinances. TYPE OF USE: RESIDENTIAL COMMERCIAL INDUSTRIAL FLOW G.P.D.

If applicant other than actual property owner, attach Letter of Authorization from Property Owner. Name Mailing Address The Bonded Contractor/Drain Layer authorized to perform this work is: Chris Mendoza SDR PVC 35

PERMIT EXPIRES ONE YEAR AFTER DATE OF ISSUE

- Requires separate connections for sewage and storm drain where applicable. Storm water cannot be discharged to a sanitary sewer. All work must be inspected and approved by a D.P.I. inspector before backfilling. If this connection is to be part of a private service shared jointly with other building owners, attach copy of Recorded Joint Maintenance Agreement. Permits can be issued to Industrial and/or Commercial Applicants only upon receipt and approval by the Commissioner of Public Infrastructure of required plans and supplemental information. In addition, a City-issued Industrial User Discharge Permit and/or a Sewer Extension/Connection Permit issued by the Commonwealth of Massachusetts D.E.P. shall be required by the City for Industrial Discharge into the sewer system.

Comm. Mass. Sewer Conn./Ext. Permit No. Date A Filing and Inspection Fee of \$450, plus an Entrance Fee of \$ where applicable, must accompany this application.

Bank# Bank Five Check# 2650 Date 3/19/14 Receipt# 13700

Other requirements: Please call ahead 24hrs for inspection. Must be done according to attached plan.

Connection made to Sewer Storm Drain Part of jointly-shared private line YES NO


Applicant agrees to abide by the above terms, as well as all pertinent ordinances of the City of New Bedford, and such other special rules as the Commissioner of Public Infrastructure and/or City Engineer may deem necessary

Signatures of David M. Anade (City Engineer) and X. Juan C. P... (Signature of Property Owner or Representative)

INSPECTOR'S REPORT

INSPECTED BY: JB DATE: 4/2/14 COMMENTS:



APPROVED DISAPPROVED SIGNATURE

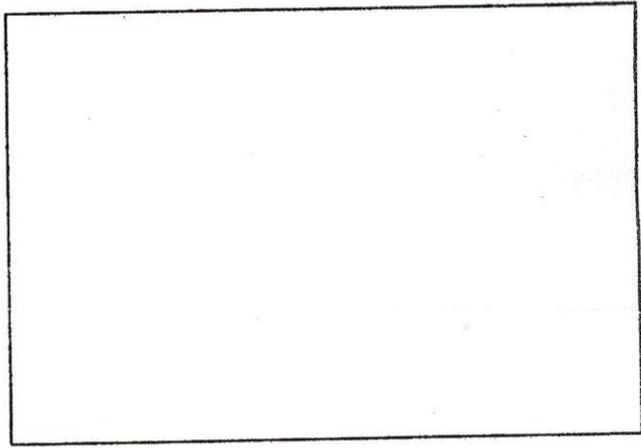

SKETCH PLAN

CARRS MENDOTA  
 SERVICE TIE-IN  
 4/2/14 - (RPA)

CONTR:

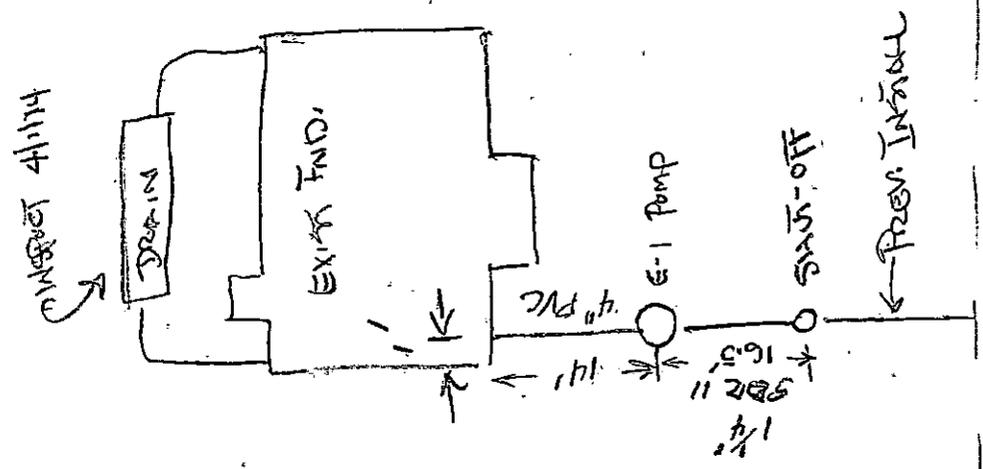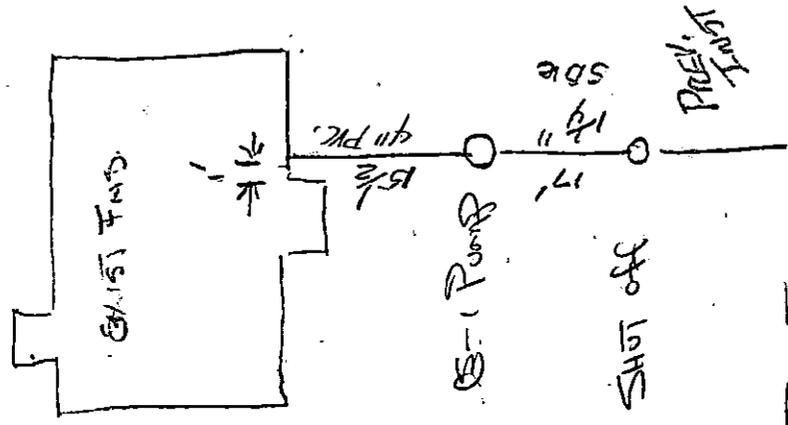

WILDWOOD RD. (PRIVATE)

22