

PERMIT NO.



CITY OF NEW BEDFORD
SEWER AND/OR STORM DRAIN PERMIT

DATE 7/31/14

24396

This certifies that permission is granted to

Joe Pacheco 130 Winslow Street (508) 998-8015 3069
Property Owner Address Tel. John Westgate / Don Menevel

To connect a sewer and/or storm drain located at Lucy St S x Al - nk - Sac

Assessor's Plot 18 Lot 46 to the sewer and/or storm drain in from manhole on Lucy Street
maintaining into drain going easterly 116 ft.

To be laid in accordance with the conditions in this application and the City of New Bedford ordinances.

TYPE OF USE: RESIDENTIAL COMMERCIAL INDUSTRIAL FLOW G.P.D.

If applicant other than actual property owner, attach Letter of Authorization from Property Owner.

Name Mailing Address Tel. 508-998-0230 (John Westgate) Don Menevel

The Bonded Contractor/Drain Layer authorized to perform this work is:

Name Address Tel.

Type of Pipe Required: PVC 35 8 inch

PERMIT EXPIRES ONE YEAR AFTER DATE OF ISSUE

- Requires separate connections for sewage and storm drain where applicable. Storm water cannot be discharged to a sanitary sewer.
- All work must be inspected and approved by a D.P.I. inspector before backfilling.
- If this connection is to be part of a private service shared jointly with other building owners, attach copy of Recorded Joint Maintenance Agreement.
- Permits can be issued to Industrial and/or Commercial Applicants only upon receipt and approval by the Commissioner of Public Infrastructure of required plans and supplemental information.
- In addition, a City-issued Industrial User Discharge Permit and/or a Sewer Extension/Connection Permit issued by the Commonwealth of Massachusetts D.E.P. shall be required by the City for Industrial Discharge into the sewer system.

Industrial User Discharge Permit No. Date

Comm. Mass. Sewer Conn./Ext. Permit No. Date

A Filing and Inspection Fee of \$150, plus an Entrance Fee of \$150, where applicable, must accompany this application.

Bank# St. Anne's Credit Union Check# 104 Date 7/29/14 Receipt# 21402

Other requirements: Please call ahead 24 hr notice for inspection @ 508-998-1150

41 500 Owner/contractor must provide city with a Bill of Sewer

Connection made to Sewer Part of jointly-shared private line YES NO Service # 24395
Storm Drain

Applicant agrees to abide by the above terms, as well as all pertinent ordinances of the City of New Bedford, and such other special rules as the Commissioner of Public Infrastructure and/or City Engineer may deem necessary

Manuel H. Silva City Engineer Supervising Civil Engineer John Westgate WWS Super. Signature of Property Owner or Representative

INSPECTOR'S REPORT

INSPECTED BY:


DATE:

COMMENTS:

APPROVED

DISAP

SEE WHITE SHEET
SIGNATURE

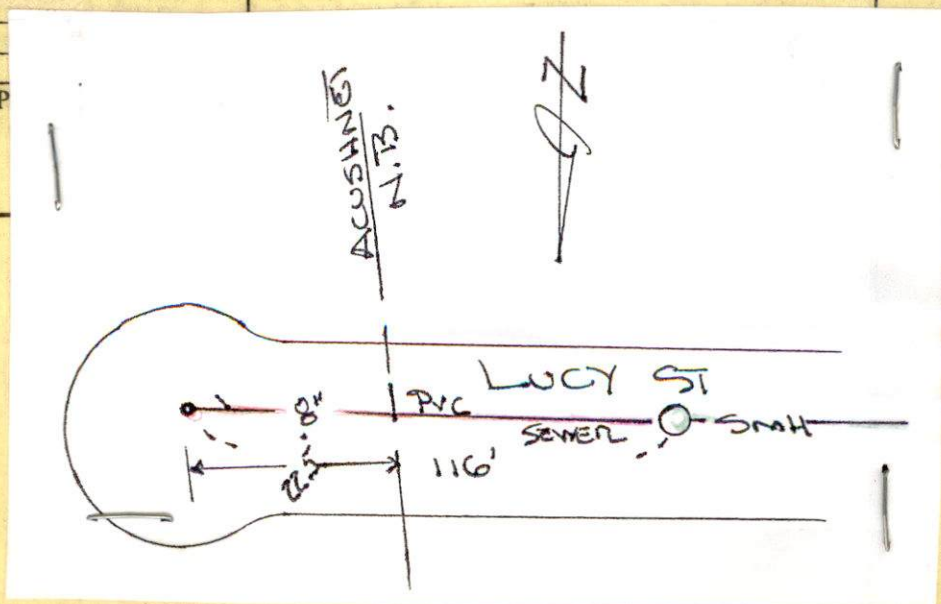



This certifies that permission is granted to
Joe Pacheco 130 Winston Street Acushnet, MA 02745 (508) 801-1669
Property Owner Address Tel.

To connect a sewer and/or storm drain located at Lucy St S x Cul-de-Sac
Assessor's Plot 18 Lot 46 to the sewer and/or storm drain in From manhole on Lucy Street
maintaining into 12 inch going east 116 ft.
To be laid in accordance with the conditions in this application and the City of New Bedford ordinances.
TYPE OF USE: RESIDENTIAL COMMERCIAL INDUSTRIAL FLOW G.P.D.

If applicant other than actual property owner, attach Letter of Authorization from Property Owner. 508-998-0230
Name Town of Acushnet Tel. (John Westgate)
Mailing Address Don Mendonca
The Bonded Contractor/Drain Layer authorized to perform this work is:

Name Address Tel.
Type of Pipe Required: PVC SDR 35 8 inch

PERMIT EXPIRES ONE YEAR AFTER DATE OF ISSUE

- Requires separate connections for sewage and storm drain where applicable. Storm water cannot be discharged to a sanitary sewer.
 - All work must be inspected and approved by a D.P.I. inspector before backfilling.
 - If this connection is to be part of a private service shared jointly with other building owners, attach copy of Recorded Joint Maintenance Agreement.
 - Permits can be issued to Industrial and/or Commercial Applicants only upon receipt and approval by the Commissioner of Public Infrastructure of required plans and supplemental information.
 - In addition, a City-issued Industrial User Discharge Permit and/or a Sewer Extension/Connection Permit issued by the Commonwealth of Massachusetts D.E.P. shall be required by the City for Industrial Discharge into the sewer system.
- Industrial User Discharge Permit No. Date

Comm. Mass. Sewer Conn./Ext. Permit No. Date
A Filing and Inspection Fee of \$450, plus an Entrance Fee of \$90, where applicable, must accompany this application.

Bank# St. Anne's Credit Union Check# 104 Date 7/29/11 Receipt# 21402

Other requirements: Please call ahead 24hr notice for inspection @ 508-998-1250
Ext 500
Owner/contractor must provide city with a Bill of Sewer with profile.
Connection made to Sewer Part of jointly-shared private line YES NO Service # 24395
Storm Drain


Applicant agrees to abide by the above terms, as well as all pertinent ordinances of the City of New Bedford, and such other special rules as the Commissioner of Public Infrastructure and/or City Engineer may deem necessary

Mamuel H. Silva City Engineer
Supervising Civil Engineer
John Westgate W.S. Super. Signature of Property Owner or Representative

INSPECTOR'S REPORT

INSPECTED BY: [Signature]
DATE: 8/18/11
COMMENTS:

APPROVED DISAPPROVED
[Signature]
SIGNATURE

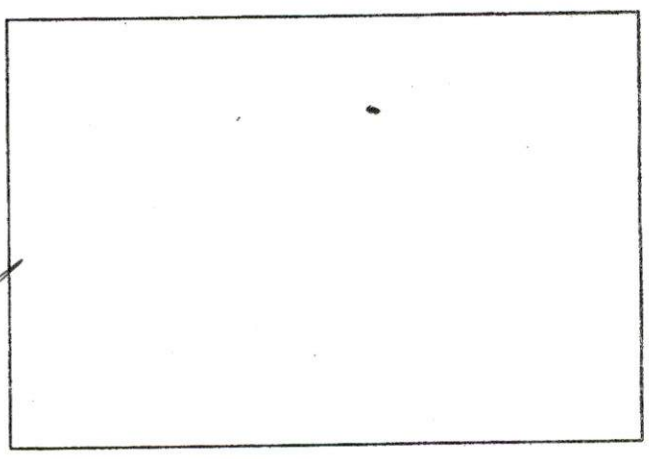

SKETCH PLAN

SEWER LINE TESTED 8/18/11 - PASSED
F-17 P. 193A outlet

Expires: 7/31/15

PERMIT NO.



CITY OF NEW BEDFORD
SEWER AND/OR STORM DRAIN PERMIT

DATE 7/31/14

24396

This certifies that permission is granted to

Joe Pacheco 130 Winston Street (508) 801-1669
Property Owner Address Acushnet, MA 02745 Tel. Joe

To connect a sewer and/or storm drain located at Lucy St S x Cul-de-Sac

Assessor's Plot 18 Lot 46 to the sewer and/or storm drain in from manhole on Lucy Street
main tying into 12 inch going eastward 116 ft.

To be laid in accordance with the conditions in this application and the City of New Bedford ordinances.
TYPE OF USE: RESIDENTIAL COMMERCIAL INDUSTRIAL FLOW G.P.D.

If applicant other than actual property owner, attach Letter of Authorization from Property Owner. 508-998-0230
Name Town of Acushnet Tel. John Westgate
Mailing Address Don Menezes
The Bonded Contractor/Drain Layer authorized to perform this work is:

Name Address Tel.
Type of Pipe Required: PVC SDR 35 8 inch

PERMIT EXPIRES ONE YEAR AFTER DATE OF ISSUE

- Requires separate connections for sewage and storm drain where applicable. Storm water cannot be discharged to a sanitary sewer.
- All work must be inspected and approved by a D.P.I. inspector before backfilling.
- If this connection is to be part of a private service shared jointly with other building owners, attach copy of Recorded Joint Maintenance Agreement.
- Permits can be issued to Industrial and/or Commercial Applicants only upon receipt and approval by the Commissioner of Public Infrastructure of required plans and supplemental information.
- In addition, a City-issued Industrial User Discharge Permit and/or a Sewer Extension/Connection Permit issued by the Commonwealth of Massachusetts D.E.P. shall be required by the City for Industrial Discharge into the sewer system.

Industrial User Discharge Permit No. Date

Comm. Mass. Sewer Conn./Ext. Permit No. Date
A Filing and Inspection Fee of \$450, plus an Entrance Fee of \$90, where applicable, must accompany this application.

Bank# St. Anne's Credit Check# 104 Date 7/29/14 Receipt# 21402

Other requirements: Please call ahead 24hr notice for inspection to 508-979-1550

Ext 500 Owner/contractor must provide City with a Bill of Sewer with profile

Connection made to Sewer Part of jointly-shared private line YES NO Service # 24395
Storm Drain

Applicant agrees to abide by the above terms, as well as all pertinent ordinances of the City of New Bedford, and such other special rules as the Commissioner of Public Infrastructure and/or City Engineer may deem necessary


Manuel H. Silva City Engineer Supervising Civil Engineer
John Westgate Signature of Property Owner or Representative

INSPECTOR'S REPORT

INSPECTED BY: _____
DATE: _____
COMMENTS: _____

APPROVED _____ DISAPPROVED _____

SIGNATURE

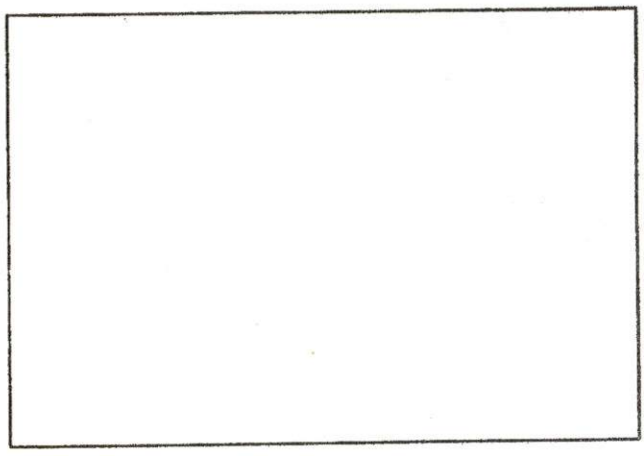

SKETCH PLAN





12/21/14 - (24)



01/14/14

CAVENDISH
SEWER EX. + SERVICES

8/18/14
SEWER MAIN TESTED
+ PASSED PRESSURE TEST

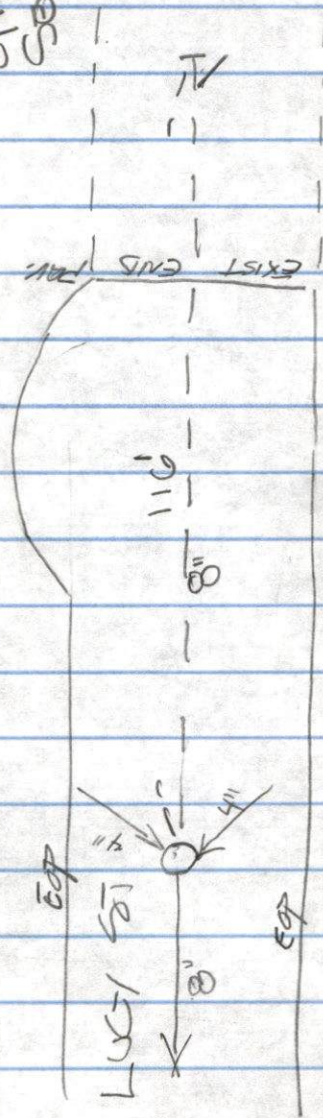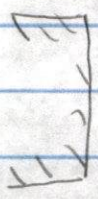

#830

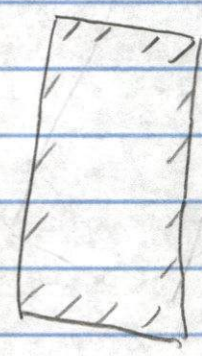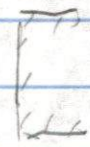

City of New Bedford
Dept of Public Infrastructure
1105 Shawmut Ave
New Bedford, MA 02740
(508) 979-1550

001259-0001 Erin I. 08/01/2014 10:01AM

MISCELLANEOUS

Description: DPI SEWER
PERMITS AND EXTENSIONS
(DPISEW)

DPI SEWER PERMITS AND
EXTENSIONS

1 @ 842.00

DPI SEWER PERMITS AND
EXTENSIONS

Principal 842.00

Interest 0.00

-TW05-101009- 842.00D

63906000-422185- 842.00C

Payment Id: 21400

842.00

Subtotal 842.00

Total 842.00

CHECK 842.00

Check Number 104

Change due 0.00

Paid by: joe pacheco

Thank you for your payment

CUSTOMER COPY