



24411-35 10/31/15

PERMIT NO.

CITY OF NEW BEDFORD
SEWER AND/OR STORM DRAIN PERMIT

DATE 10/29/14

24411

This certifies that permission is granted to

Property Owner Sharon Constant Address 26 Morning French Blvd Tel. (508) 965-2428

To connect a sewer and/or storm drain located at Acushnet Ave (S) 65' N x Kathleen Street

Assessor's Plot 139 Lot 5101912 to the sewer and/or storm drain in Acushnet Ave Street

To be laid in accordance with the conditions in this application and the City of New Bedford ordinances.

TYPE OF USE: RESIDENTIAL COMMERCIAL INDUSTRIAL FLOW 330 G.P.D.

If applicant other than actual property owner, attach Letter of Authorization from Property Owner.

Name Sharon Constant Tel. (508) 965-2428

Mailing Address 26 Morning French Blvd

The Bonded Contractor/Drain Layer authorized to perform this work is:

Name Sharon Constant Address 26 Morning French Blvd Tel. (508) 965-2428

Type of Pipe Required: 6" SDP 35

PERMIT EXPIRES ONE YEAR AFTER DATE OF ISSUE

- Requires separate connections for sewage and storm drain where applicable. Storm water cannot be discharged to a sanitary sewer.
 - All work must be inspected and approved by a D.P.I. inspector before backfilling.
 - If this connection is to be part of a private service shared jointly with other building owners, attach copy of Recorded Joint Maintenance Agreement.
 - Permits can be issued to Industrial and/or Commercial Applicants only upon receipt and approval by the Commissioner of Public Infrastructure of required plans and supplemental information.
 - In addition, a City-issued Industrial User Discharge Permit and/or a Sewer Extension/Connection Permit issued by the Commonwealth of Massachusetts D.E.P. shall be required by the City for Industrial Discharge into the sewer system.
- Industrial User Discharge Permit No. N/A Date N/A

Comm. Mass. Sewer Conn./Ext. Permit No. N/A Date N/A

A Filing and Inspection Fee of \$ 0.00, plus an Entrance Fee of \$ 0.00 where applicable, must accompany this application.

Bank# Bank of America Check# 198 Date 10/29/14 Receipt# 26059

Other requirements: Please call ahead 24hrs notice for inspection @

Connection made to Sewer Part of jointly-shared private line YES NO
Storm Drain

Applicant agrees to abide by the above terms, as well as all pertinent ordinances of the City of New Bedford, and such other special rules as the Commissioner of Public Infrastructure and/or City Engineer may deem necessary


City Engineer Clark at the Water Signature of Property Owner or Representative Sharon Constant

INSPECTOR'S REPORT

INSPECTED BY: SEE WHITE SHEET
DATE: SEE WHITE SHEET
COMMENTS: SEE WHITE SHEET

APPROVED DIS

SIGNATURE

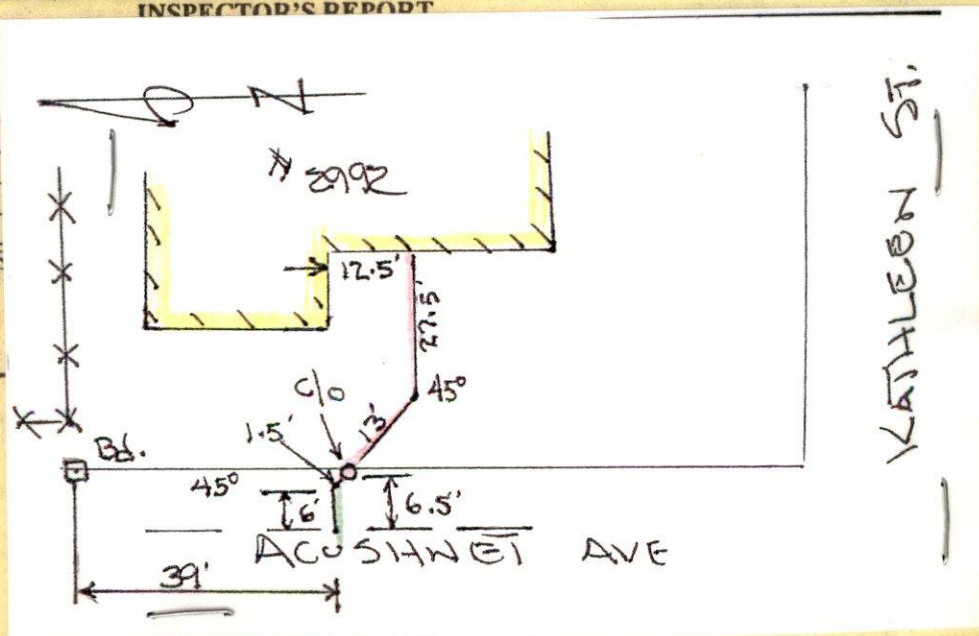



11/20/14
Thursday

Inspector
1:00 PM

Expires
10/29/15

PERMIT NO.

24411

CITY OF NEW BEDFORD
SEWER AND/OR STORM DRAIN PERMIT

DATE 10/29/14

This certifies that permission is granted to

Shawn Constant Property Owner 26 Rodney French Blvd Address N.B., MA 02744 (308) 965-2428 Tel.

To connect a sewer and/or storm drain located at Acushnet Ave (E.S.) 65' N x Kathleen Street

Assessor's Plot 132 Lot 510+912 to the sewer and/or storm drain in 2992 Old Acushnet Ave Street

To be laid in accordance with the conditions in this application and the City of New Bedford ordinances.

TYPE OF USE: RESIDENTIAL COMMERCIAL INDUSTRIAL FLOW 330 G.P.D.

If applicant other than actual property owner, attach Letter of Authorization from Property Owner.

Name N/A Tel.

Mailing Address N/A Tel.

The Bonded Contractor/Drain Layer authorized to perform this work is:

Name Address Tel.

Type of Pipe Required: 6" SDR 35

PERMIT EXPIRES ONE YEAR AFTER DATE OF ISSUE

- Requires separate connections for sewage and storm drain where applicable. Storm water cannot be discharged to a sanitary sewer.
 - All work must be inspected and approved by a D.P.I. inspector before backfilling.
 - If this connection is to be part of a private service shared jointly with other building owners, attach copy of Recorded Joint Maintenance Agreement.
 - Permits can be issued to Industrial and/or Commercial Applicants only upon receipt and approval by the Commissioner of Public Infrastructure of required plans and supplemental information.
 - In addition, a City-issued Industrial User Discharge Permit and/or a Sewer Extension/Connection Permit issued by the Commonwealth of Massachusetts D.E.P. shall be required by the City for Industrial Discharge into the sewer system.
- Industrial User Discharge Permit No. Date.

Comm. Mass. Sewer Conn./Ext. Permit No. N/A Date.

A Filing and Inspection Fee of \$....., plus an Entrance Fee of \$..... where applicable, must accompany this application.

Bank# Bank of America Check# 198 Date 10/29/14 Receipt# 26059

Other requirements: Please call ahead 24hr notice for inspection @

(508) 979-1592 ext. 502 testing witnessed by D.P.I.

Connection made to Sewer Part of jointly-shared private line YES NO

Storm Drain

Applicant agrees to abide by the above terms, as well as all pertinent ordinances of the City of New Bedford, and such other special rules as the Commissioner of Public Infrastructure and/or City Engineer may deem necessary.

City Engineer

Signature of Property Owner or Representative

INSPECTOR'S REPORT

INSPECTED BY: [Signature]


DATE: 11/21/14

COMMENTS:

APPROVED

DISAPPROVED

SIGNATURE

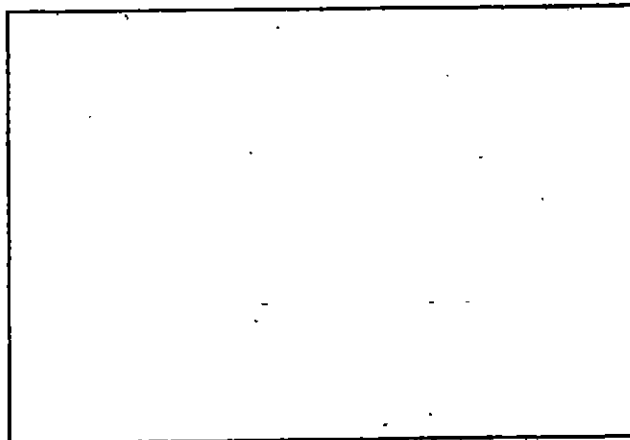

SKETCH PLAN

WW-19-33

Expires: 10/29/15



PERMIT NO.

CITY OF NEW BEDFORD
SEWER AND/OR STORM DRAIN PERMIT

DATE 10/29/14

2441-1

This certifies that permission is granted to

Shawn Constant 26 Rodney French Blvd (308) 965-2428
Property Owner Address N.B., MA 02744 Tel.

To connect a sewer and/or storm drain located at Acushnet Ave (E.S.) 65' N x Kathleen Street
2992 Acushnet Ave - Old address

Assessor's Plot 132 Lot 510+912 to the sewer and/or storm drain in Acushnet Ave Street
* new

To be laid in accordance with the conditions in this application and the City of New Bedford ordinances.

TYPE OF USE: RESIDENTIAL COMMERCIAL INDUSTRIAL FLOW 330 G.P.D.

If applicant other than actual property owner, attach Letter of Authorization from Property Owner.

Name MIA / CANESSA assisted Tel.
Mailing Address Private Contractor

The Bonded Contractor/Drain Layer authorized to perform this work is:

Name Address Tel.
Type of Pipe Required: 6" SDR 35

PERMIT EXPIRES ONE YEAR AFTER DATE OF ISSUE

- Requires separate connections for sewage and storm drain where applicable. Storm water cannot be discharged to a sanitary sewer.
 - All work must be inspected and approved by a D.P.I. inspector before backfilling.
 - If this connection is to be part of a private service shared jointly with other building owners, attach copy of Recorded Joint Maintenance Agreement.
 - Permits can be issued to Industrial and/or Commercial Applicants only upon receipt and approval by the Commissioner of Public Infrastructure of required plans and supplemental information.
 - In addition, a City-issued Industrial User Discharge Permit and/or a Sewer Extension/Connection Permit issued by the Commonwealth of Massachusetts D.E.P. shall be required by the City for Industrial Discharge into the sewer system.
- Industrial User Discharge Permit No. Date

Comm. Mass. Sewer Conn./Ext. Permit No. N/A Date
A Filing and Inspection Fee of \$450.00, plus an Entrance Fee of \$ where applicable, must accompany this application.

Bank# Bank of America Check# 198 Date 10/29/14 Receipt# 26059

Other requirements: Please call ahead 24hr notice for inspection @

(508) 979-1590 ext. 500 testing witnessed by D.P.I.
Sewer tested to maintain vertical & horizontal separation.

Connection made to Storm Drain Part of jointly-shared private line YES NO

Applicant agrees to abide by the above terms, as well as all pertinent ordinances of the City of New Bedford, and such other special rules as the Commissioner of Public Infrastructure and/or City Engineer may deem necessary.

City Engineer


Signature of Property Owner or Representative

INSPECTOR'S REPORT

INSPECTED BY:
DATE:
COMMENTS:

APPROVED DISAPPROVED

SIGNATURE

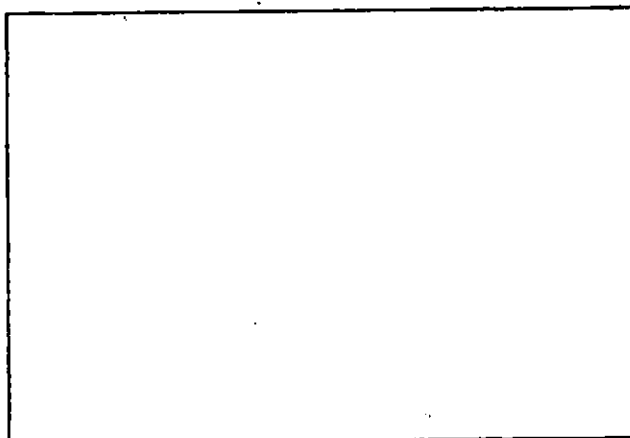

SKETCH PLAN

a241mp: Plumbing and gas permits required

eng: 1. Owner to reuse existing water service.

ASR-D.P.I. Engrg.: RE: TB-14-1902

Acushnet Ave. (E.S.) 65' N. x Kathleen St.
(Plot 132/Lots 510 & 912)

Requirements to be met by Owner/Developer for this project:

- 1.) Must provide 3 copies of site plan at the time of applying for permits at D.P.I., showing existing conditions and proposed grading/utilities (i.e. proposed water, sewer/storm drain (recharge structure) and driveway), a copy of the foundation permit and "stamped" foundation as-built plan. Any representative/agent pulling permits on behalf of the owner must provide D.P.I. with a permission slip. If property was recently acquired (within past 3 months), the new owner must provide a copy of the recorded deed showing property ownership.
- 2.) Must contact D.P.I.-Engineering to measure for building number (address) once front door is framed. The C.O. will not be signed unless the legal address assigned by the City is permanently affixed to, above, or next to, the entrance to which it was assigned such that it is highly visible from the street.

Please note the following:

- a.) The integrity of any previously existing water and/or sewer service being re-utilized must be determined, and said testing witnessed by a D.P.I. inspector, prior to connection. The owner/developer assumes all responsibility of re-utilizing said service(s). Contractor is responsible for meeting minimum required vertical and horizontal separation for water and sewer services.
- d.) The maximum width allowed for any residential driveway opening is 18'. Anything larger than 18' will have to go before Traffic Commission for approval prior to D.P.I. issuing a Driveway Permit.

ASR-D.P.I. Engrg.: RE: TB-14-1902

Acushnet Ave. (E.S.) 65' N. x Kathleen St.
(Plot 132/Lots 510 & 912)

Roof runoff to be recharged into ground. Site plan must show placement of infiltration structure & calculations on sizing of the system.

Sewer service must be 6" SDR 35, and where the required vertical and horizontal separation cannot be attained, the proper measures must be implemented as outlined in the D.P.I.'s "Construction Specifications". Sewer cleanout should be installed according to these specifications. The owner/developer assumes all responsibility of re-utilizing any previously existing water and/or sewer service. The integrity of the services being re-utilized must be determined, and said testing witnessed by a D.P.I. inspector, prior to connection.

The address of the previous structure that was demolished is not to be utilized for the new residence, unless deemed by Engineering.



Commonwealth of Massachusetts

CITY OF NEW BEDFORD

City Hall, Room 308, 133 William Street New Bedford, MA 02740 (508) 979-1540

FOUNDATION



No. **B-14-1902**

MSBC Sect. 111.8 - Any permit issued shall be deemed abandoned and invalid unless it has been commenced within six (6) months after its issuance.

14

\$100.00

This certifies that **Atnanasios Pitliangas**

owner/contractor has permission to: **NS KATHLEEN**

on: **Foundations Only 1-2 Family - 100.00**

Providing that the person accepting this permit shall in every respect conform to the terms of the statute of the Commonwealth and to the by-laws of the City of New Bedford relating to the erecting, repairing, or tearing down of a building.

to the provisions of the statute; to the provisions relating to the erecting, raising, moving,

Permit is issued subject to the following special requirements: (Restrictions)



Wiring Inspector



Plumbing Inspector



Building Inspector

YOUR AREA INSPECTOR IS: **Thomas Welch**

Tel. (508) 979-1540 Between 8:00am - 9:00am

NOTICE: NOTIFY INSPECTOR 48 HOURS IN ADVANCE OF APPLYING SHEATHING OR LATHING

OCCUPANCY PERMIT REQUIRED BEFORE OCCUPANCY

No Building or Structure shall be used or occupied until the Certificate of Use and Occupancy shall have been issued by the Building Commissioner - MSBC, Sect. 120.1

This Card Must Be Displayed in a Conspicuous Place on the Premises and Not Torn Down or Removed Until Completion of Work

SUBJECT TO MASSACHUSETTS
STATE BUILDING CODE

Danny O. Ronowicz

Building Inspector

Plan Review Comments:

Talk to
about
Menny's
Driveway
Partner needs
to be added
Both Transistor
Wants
lease.
Driveway
18'x

a241mp: Plumbing and gas permits required

eng: 1. Owner to reuse existing water service.

ASR-D.P.I. Engrg.: RE: TB-14-1902

Acushnet Ave. (E.S.) 65' N. x Kathleen St.
(Plot 132/Lots 510 & 912)

Requirements to be met by Owner/Developer for this project:

1.) Must provide 3 copies of site plan at the time of applying for permits at D.P.I., showing existing conditions and proposed grading/utilities (i.e. proposed water, sewer/storm drain (recharge structure) and driveway), a copy of the foundation permit and "stamped" foundation as-built plan. Any representative/agent pulling permits on behalf of the owner must provide D.P.I. with a permission slip. If property was recently acquired (within past 3 months), the new owner must provide a copy of the recorded deed showing property ownership.

2.) Must contact D.P.I.-Engineering to measure for building number (address) once front door is framed. The C.O. will not be signed unless the legal address assigned by the City is permanently affixed to, above, or next to, the entrance to which it was assigned such that it is highly visible from the street.

Please note the following:

a.) The integrity of any previously existing water and/or sewer service being re-utilized must be determined, and said testing witnessed by a D.P.I. inspector, prior to connection. The owner/developer assumes all responsibility of re-utilizing said service(s). Contractor is responsible for meeting minimum required vertical and horizontal separation for water and sewer services.

d.) The maximum width allowed for any residential driveway opening is 18'. Anything larger than 18' will have to go before Traffic Commission for approval prior to D.P.I. issuing a Driveway Permit.

ASR-D.P.I. Engrg.: RE: TB-14-1902

Acushnet Ave. (E.S.) 65' N. x Kathleen St.
(Plot 132/Lots 510 & 912)

Roof runoff to be recharged into ground. Site plan must show placement of infiltration structure & calculations on sizing of the system.

Sewer service must be 6" SDR 35, and where the required vertical and horizontal separation cannot be attained, the proper measures must be implemented as outlined in the D.P.I.'s "Construction Specifications". Sewer cleanout should be installed according to these specifications. The owner/developer assumes all responsibility of re-utilizing any previously existing water and/or sewer service. The integrity of the services being re-utilized must be determined, and said testing witnessed by a D.P.I. inspector, prior to connection.

The address of the previous structure that was demolished is not to be utilized for the new residence, unless deemed by Engineering.



Commonwealth of Massachusetts

City of New Bedford

133 William Street New Bedford, MA 02740

SEWER PERMIT



Date: **12/16/2014**

No. **WW-14-33**

Sewer Connection Fee: **\$450.00**

Pipe Size: **0.00**

Trench Length: **0.00**

Service Location: **NS KATHLEEN ST**

Owner Name: **CONSTANT BRADFORD**

Type of Occupancy: **Residential**

Type of Work: **Sewer - New Sewer Service**

Work Description: **SEWER PERMIT# 24411**

ACUSHNET AVE ES 65 X KATHLEEN ST

PREVIOUS ADDRESS 2992 ACUSHNET AVE

P.132

L. 510 + 912

CONNECTING SEWER INTO ACUSHNET AVE

No. of Units : **0**

Required Design Daily Flow : **0.00**

Provided Daily Flow : **0.00**

The undersigned petitions you to grant permission to ENTER INTO THE MAIN SEWER and, if such permission is granted, hereby agrees to the following:

1. To abide by the conditions and regulations imposed by the Commissioner of Public Works by statute or by ordinance now in force, or as amended from time to time.
2. That the connection of said sewer with the main sewer shall be inspected by an employee of the department of Public Works or by a designated agent of the Town before burial of said connection.
3. That the work shall at all times be under the direction and control of the Commissioner of Public Works or his authorized agent, and that any expense incurred by the Town shall be charged to the permittee, and said permittee agrees to reimburse the Town for said expense.

Installing Company Name: _____

License Type: _____

Address: _____ City/Town/State: _____

Call (781) 942-9077 For Inspection