

\*Subdivisions

TWW-15-16

exp 6/1/16



PERMIT NO.

24434

CITY OF NEW BEDFORD  
SEWER AND/OR STORM DRAIN PERMIT

DATE 6/1/15

This certifies that permission is granted to

Property Owner Lona Build + Homes Address 153 Charles McComb's Blvd Tel. 508-269-7782

To connect a sewer and/or storm drain located at 145 mate Drive

Assessor's Plot 1306 Lot 209, to the sewer and/or storm drain in mate Drive (8") Street

To be laid in accordance with the conditions in this application and the City of New Bedford ordinances.

TYPE OF USE: RESIDENTIAL COMMERCIAL INDUSTRIAL FLOW 330 G.P.D.

If applicant other than actual property owner, attach Letter of Authorization from Property Owner.

Name..... Tel.....

Mailing Address.....

The Bonded Contractor/Drain Layer authorized to perform this work is:

Mercury Heavy Equipment

Name..... Address..... Tel.....

Type of Pipe Required: RCS DR 35

PERMIT EXPIRES ONE YEAR AFTER DATE OF ISSUE

- Requires separate connections for sewage and storm drain where applicable. Storm water cannot be discharged to a sanitary sewer.
- All work must be inspected and approved by a D.P.I. inspector before backfilling.
- If this connection is to be part of a private service shared jointly with other building owners, attach copy of Recorded Joint Maintenance Agreement.
- Permits can be issued to Industrial and/or Commercial Applicants only upon receipt and approval by the Commissioner of Public Infrastructure of required plans and supplemental information.
- In addition, a City-issued Industrial User Discharge Permit and/or a Sewer Extension/Connection Permit issued by the Commonwealth of Massachusetts D.E.P. shall be required by the City for Industrial Discharge into the sewer system.

Industrial User Discharge Permit No..... Date.....

Comm. Mass. Sewer Conn./Ext. Permit No..... Date.....

A Filing and Inspection Fee of \$ 450, plus an Entrance Fee of \$..... where applicable, must accompany this application.

Bank# Bay Coast Check# 13370 Date 6/1/15 Receipt#.....

Other requirements: Please call 24 hrs in advance

for inspection

Connection made to Sewer Part of jointly-shared private line YES NO  
Storm Drain

Applicant agrees to abide by the above terms, as well as all pertinent ordinances of the City of New Bedford, and such other special rules as the Commissioner of Public Infrastructure and/or City Engineer may deem necessary

Manuel H. Silva

City Engineer

Supervising Civil Engineer

INSPECTOR'S

INSPECTED BY: SEE WHITE SHEET

DATE:.....

COMMENTS:.....

.....

.....

.....


APPROVED DISAPPROVED

.....

.....

.....

SIGNATURE

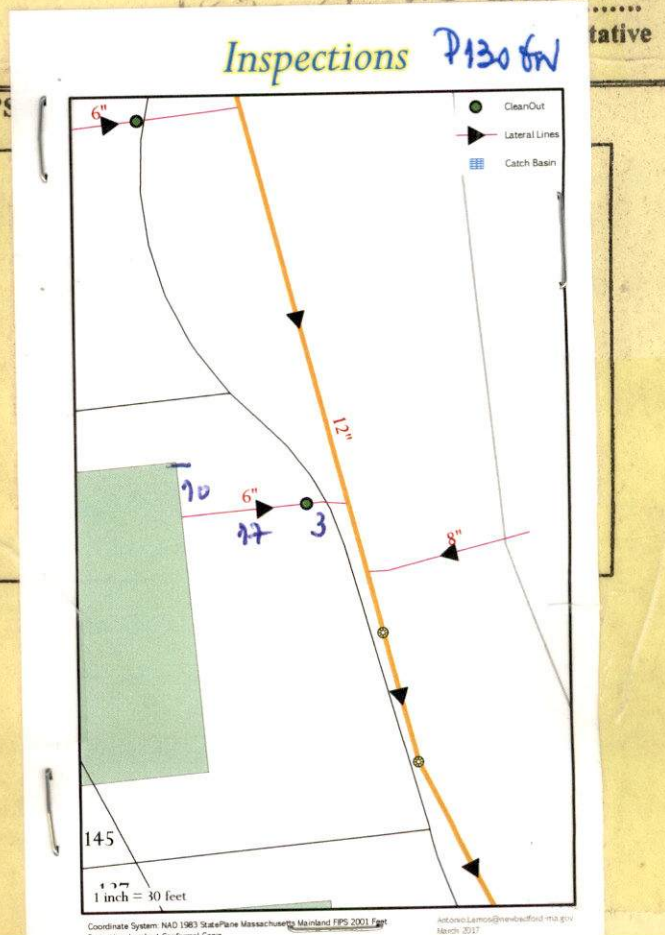



\*Subdivisions



Inspection

exp 6/1/16

6/2/15

DATE 6/1/15

@ 9am

PERMIT NO.

24434

CITY OF NEW BEDFORD  
SEWER AND/OR STORM DRAIN PERMIT

This certifies that permission is granted to

Long Built Homes 153 Charles McCombs Blvd 508-269-7782  
Property Owner Address Tel.

To connect a sewer and/or storm drain located at 145 mate Drive  
Assessor's Plot 1306 209 Lot to the sewer and/or storm drain in mate Drive (8") Street

To be laid in accordance with the conditions in this application and the City of New Bedford ordinances.  
TYPE OF USE RESIDENTIAL COMMERCIAL INDUSTRIAL FLOW 330 G.P.D.

If applicant other than actual property owner, attach Letter of Authorization from Property Owner.

Name Tel.  
Mailing Address

The Bonded Contractor/Drain Layer authorized to perform this work is:

Mercury Heavy Equipment  
Name Address Tel.  
Type of Pipe Required R/CSDR 35

PERMIT EXPIRES ONE YEAR AFTER DATE OF ISSUE

- Requires separate connections for sewage and storm drain where applicable. Storm water cannot be discharged to a sanitary sewer.
  - All work must be inspected and approved by a D.P.I. inspector before backfilling.
  - If this connection is to be part of a private service shared jointly with other building owners, attach copy of Recorded Joint Maintenance Agreement.
  - Permits can be issued to Industrial and/or Commercial Applicants only upon receipt and approval by the Commissioner of Public Infrastructure of required plans and supplemental information.
  - In addition, a City-issued Industrial User Discharge Permit and/or a Sewer Extension/Connection Permit issued by the Commonwealth of Massachusetts D.E.P. shall be required by the City for Industrial Discharge into the sewer system.
- Industrial User Discharge Permit No. Date

Comm. Mass. Sewer Conn./Ext. Permit No. Date  
A Filing and Inspection Fee of \$450, plus an Entrance Fee of \$ where applicable, must accompany this application.

Bank# Bay Coast Check# 13370 Date 6/1/15 Receipt#

Other requirements: Please call 24 hrs in advance for inspection

Connection made to Sewer Part of jointly-shared private line YES (NO)  
Storm Drain

Applicant agrees to abide by the above terms, as well as all pertinent ordinances of the City of New Bedford, and such other special rules as the Commissioner of Public Infrastructure and/or City Engineer may deem necessary

Manuel H. Silva  
City Engineer  
Supervising Civil Engineer

Signature of Property Owner or Representative

INSPECTOR'S REPORT

INSPECTED BY: Antonio P. Sena  
DATE: 6/2/2015  
COMMENTS:

APPROVED DISAPPROVED

Paula Silva

SIGNATURE

See Att.

SKETCH PLAN



\*Subdivisions

WW-15-16

exp 6/1/16



PERMIT NO.

24434

CITY OF NEW BEDFORD  
SEWER AND/OR STORM DRAIN PERMIT

DATE 6/1/15

This certifies that permission is granted to

Long Built Homes 153 Charles McComb's Blvd 508-269-7782  
Property Owner Address Tel.

To connect a sewer and/or storm drain located at 145 mate Drive

Assessor's Plot 1306 Lot 209, to the sewer and/or storm drain in mate Drive (8") Street

To be laid in accordance with the conditions in this application and the City of New Bedford ordinances.

TYPE OF USE RESIDENTIAL COMMERCIAL INDUSTRIAL FLOW 330 G.P.D.

If applicant other than actual property owner, attach Letter of Authorization from Property Owner.

Name Tel.

Mailing Address

The Bonded Contractor/Drain Layer authorized to perform this work is:

Mercury Heavy Equipment

Name Address Tel.

Type of Pipe Required PVCSDR 35

PERMIT EXPIRES ONE YEAR AFTER DATE OF ISSUE

- Requires separate connections for sewage and storm drain where applicable. Storm water cannot be discharged to a sanitary sewer.
- All work must be inspected and approved by a D.P.I. inspector before backfilling.
- If this connection is to be part of a private service shared jointly with other building owners, attach copy of Recorded Joint Maintenance Agreement.
- Permits can be issued to Industrial and/or Commercial Applicants only upon receipt and approval by the Commissioner of Public Infrastructure of required plans and supplemental information.
- In addition, a City-issued Industrial User Discharge Permit and/or a Sewer Extension/Connection Permit issued by the Commonwealth of Massachusetts D.E.P. shall be required by the City for Industrial Discharge into the sewer system.

Industrial User Discharge Permit No. Date

Comm. Mass. Sewer Conn./Ext. Permit No. Date

A Filing and Inspection Fee of \$450, plus an Entrance Fee of \$ where applicable, must accompany this application.

Bank Bay Coast Check# 13370 Date 6/1/15 Receipt#

Other requirements: Please call 24 hrs in advance

for inspection

Connection made to Sewer Part of jointly-shared private line YES (NO)  
Storm Drain

Applicant agrees to abide by the above terms, as well as all pertinent ordinances of the City of New Bedford, and such other special rules as the Commissioner of Public Infrastructure and/or City Engineer may deem necessary

Manuel H. Silva  
City Engineer  
Supervising Civil Engineer

Signature of Property Owner or Representative

INSPECTOR'S REPORT

INSPECTED BY:

DATE:

COMMENTS:

APPROVED

DISAPPROVED

SIGNATURE

SKETCH PLAN





Department of Public Infrastructure

Ronald H. Labelle  
Commissioner

CITY OF NEW BEDFORD

Jonathan F. Mitchell, Mayor

Water  
Wastewater  
Highways  
Engineering  
Cemetery

To Whom It May Concern:

Long Built Homes, Inc., having a mailing address of  
X 158 C. McCombs Blvd., New Bedford, MA 02745, being  
(Name) (Mailing Address)

Owner of property located at

145 MARY DRIVE

Plot 130G, Lot 209, hereby agree to allow Lee Castignetti and/or Tony Shardella  
c/o Long Built Homes, Inc.  
158 C. McCombs Blvd., to act on my behalf including affixing my  
(Mailing Address)  
New Bedford, MA 02745  
signature in securing permit for:

- ☒ Sewer/Drain Service Permits
- ☒ Water Service Permits
- ☒ Driveway Installation Permits
- ☒ Sidewalk Installation Permits

I further agree to conform to, and abide by, All City rules and ask regulations applicable to the permit (s) being applied for:

Long Built Homes, Inc.  
Name By: Robert F. Long  
Signature  
Robert F. Long, President  
158 C. McCombs Blvd., New Bedford, MA 02745  
Address  
6/1/15 Date  
508-245-3161 or 508-995-8240x13 Telephone number





Commonwealth of Massachusetts

# CITY OF NEW BEDFORD

City Hall, Room 308, 133 William Street New Bedford, MA 02740 (508) 979-1540



## FOUNDATION PERMIT

6/1/2015

No. **B-15-705**

MSBC Sect. 111.8 - Any permit issued shall be deemed abandoned and invalid unless the work authorized by it shall have been commenced within six (6) months after its issuance.

FEE PAID \$100.00

This certifies that **Robert F. Long**

owner/contractor has permission to:

WS

MATE DR

145 MATE DRIVE

on: **Foundations Only 1-2 Family - 100.00**

Providing that the person accepting this permit shall in every respect conform to the terms of application therefore on file in this office; to the provisions of the statute of the Commonwealth and to the by-laws of the City of New Bedford relating to the inspection, erection, enlarging, altering, raising, moving, repairing, or tearing down of a building.

Permit is issued subject to the following special requirements: (Restrictions)



**Wiring Inspector**

\_\_\_\_\_  
\_\_\_\_\_  
\_\_\_\_\_  
\_\_\_\_\_



**Plumbing Inspector**

\_\_\_\_\_  
\_\_\_\_\_  
\_\_\_\_\_  
\_\_\_\_\_



**Building Inspector**

\_\_\_\_\_  
\_\_\_\_\_  
\_\_\_\_\_  
\_\_\_\_\_

YOUR AREA INSPECTOR IS: **Thomas Welch**

Tel. (508) 979-1540 Between 8:00am - 9:00am

**NOTICE: NOTIFY INSPECTOR 48 HOURS IN  
ADVANCE OF APPLYING SHEATHING OR LATHING**

**OCCUPANCY PERMIT REQUIRED BEFORE OCCUPANCY**

No Building or Structure shall be used or occupied until the Certificate of Use and Occupancy shall have been issued by the Building Commissioner - MSBC, Sect. 120.1

**This Card Must Be Displayed in a Conspicuous Place on the Premises and Not Torn Down or Removed Until Completion of Work**

SUBJECT TO MASSACHUSETTS  
STATE BUILDING CODE

*Danny D. Romanowicz*

Building Inspector

Plan Review Comments:

City of New Bedford  
DPI  
1105 SHAWMUT AVENUE  
NEW BEDFORD, MA 02740  
508-979-1550

002520-0004 Erin I. 06/01/2015 12:13PM

MISCELLANEOUS

Description: DPI SEWER  
PERMITS AND EXTENSIONS  
(DPISEW)

Reference 1: 145 MATE  
DPI SEWER PERMITS AND  
EXTENSIONS

1 @ 450.00

DPI SEWER PERMITS AND  
EXTENSIONS

Principal	450.00
Interest	0.00

TW05-101009-	450.00D
--------------	---------

63906000-422185-	450.00C
------------------	---------

Payment Id: 35208

-----  
450.00

Subtotal	450.00
----------	--------

Total	450.00
-------	--------

TW05-CHECK	450.00
------------	--------

Check Number 13370

Change due	0.00
------------	------

Paid by: LONG BUILT HOMES

Thank you for your payment

CUSTOMER COPY  
DUPLICATE RECEIPT





Commonwealth of Massachusetts

# City of New Bedford

133 William Street New Bedford, MA 02740

## SEWER PERMIT



Date: **7/16/2015**

No. **WW-15-16**

Sewer Connection Fee: **\$450.00**

Pipe Size: **0.00**

Trench Length: **0.00**

Service Location: **WS MATE DR**

Owner Name: **CASTIGNETTI LEE JR**

Type of Occupancy: **Residential**

Type of Work: **Sewer - New Sewer Service**

Work Description: **8" SEWER CONNECTION IN MATE DRIVE  
PVC SDR 35**

**EXP 6/2/2015**

**P130G L209**

No. of Units : **0** Required Design Daily Flow : **0.00** Provided Daily Flow : **0.00**

The undersigned petitions you to grant permission to ENTER INTO THE MAIN SEWER and, if such permission is granted, hereby agrees to the following:


1. To abide by the conditions and regulations imposed by the Commissioner of Public Works by statute or by ordinance now in force, or as amended from time to time.
2. That the connection of said sewer with the main sewer shall be inspected by an employee of the department of Public Works or by a designated agent of the Town before burial of said connection.
3. That the work shall at all times be under the direction and control of the Commissioner of Public Works or his authorized agent, and that any expense incurred by the Town shall be charged to the permittee, and said permittee agrees to reimburse the Town for said expense.

Installing Company Name: \_\_\_\_\_ License Type: \_\_\_\_\_

Address: \_\_\_\_\_ City/Town/State: \_\_\_\_\_

**GRANTED WITH THE USUAL CONDITIONS**

**Call (781) 942-9077 For Inspection**

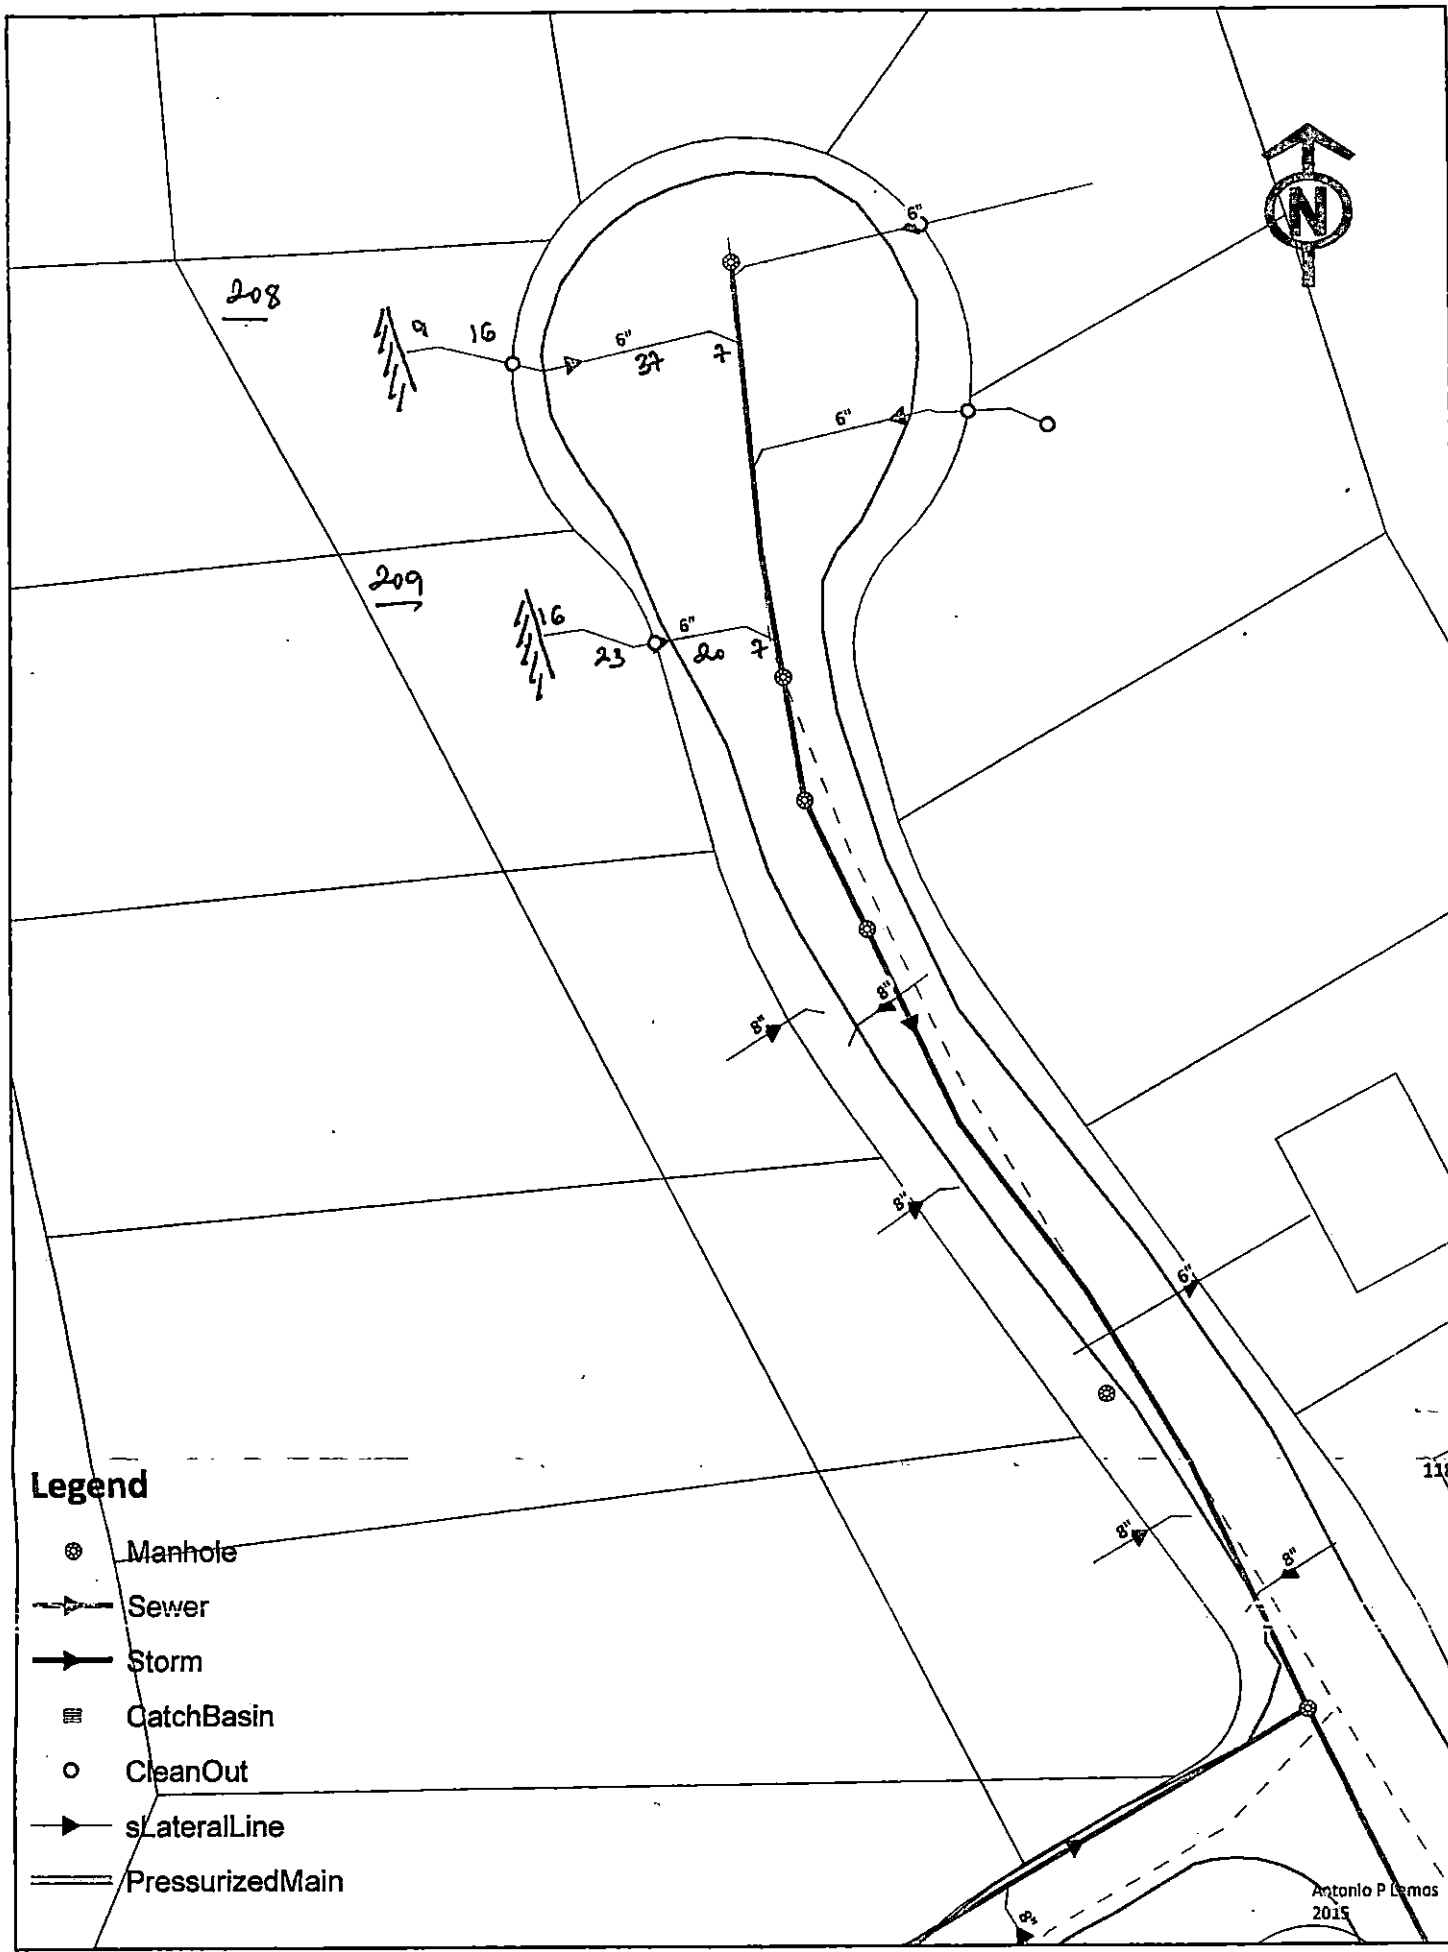

**Legend**

- Manhole
- Sewer
- Storm
- ▢ CatchBasin
- CleanOut
- sLateralLine
- == PressurizedMain