

PERMIT NO.

24437



CITY OF NEW BEDFORD
SEWER AND/OR STORM DRAIN PERMIT

DATE

6/23/15

This certifies that permission is granted to

Michael Rimpikas 133 Fawcett Corner Rd 508 728 8339
Property Owner Address Tel.

To connect a sewer and/or storm drain located at Cove St N.S. WxS Second St

Assessor's Plot 20 Lot 346 to the sewer and/or storm drain in S Second Street

To be laid in accordance with the conditions in this application and the City of New Bedford ordinances.

TYPE OF USE: RESIDENTIAL COMMERCIAL INDUSTRIAL FLOW 500 G.P.D. max

If applicant other than actual property owner, attach Letter of Authorization from Property Owner.

Name Mailing Address Tel.

The Bonded Contractor/Drain Layer authorized to perform this work is:

J. Blanton

Name Address Tel.

Type of Pipe Required: PVC SDP 35

PERMIT EXPIRES ONE YEAR AFTER DATE OF ISSUE

- Requires separate connections for sewage and storm drain where applicable. Storm water cannot be discharged to a sanitary sewer.
- All work must be inspected and approved by a D.P.I. inspector before backfilling.
- If this connection is to be part of a private service shared jointly with other building owners, attach copy of Recorded Joint Maintenance Agreement.
- Permits can be issued to Industrial and/or Commercial Applicants only upon receipt and approval by the Commissioner of Public Infrastructure of required plans and supplemental information.
- In addition, a City-issued Industrial User Discharge Permit and/or a Sewer Extension/Connection Permit issued by the Commonwealth of Massachusetts D.E.P. shall be required by the City for Industrial Discharge into the sewer system.

Industrial User Discharge Permit No. Date.

Comm. Mass. Sewer Conn./Ext. Permit No. Date.

A Filing and Inspection Fee of \$495, plus an Entrance Fee of \$ where applicable, must accompany this application.

Bank# Rockland Trust 11304478 Check# 6343 Date 6/23/15 Receipt#

Other requirements: 24 hour notice for inspection was per attached plan must call DPT to witness pressure test.

Connection made to Sewer Part of jointly-shared private line YES NO
Storm Drain

Applicant agrees to abide by the above terms, as well as all pertinent ordinances of the City of New Bedford, and such other special rules as the Commissioner of Public Infrastructure and/or City Engineer may deem necessary

Michael Rimpikas

City Engineer
Property Owner

INSPECTOR'S

INSPECTED BY:

DATE:


COMMENTS:

APPROVED

DISAPPROVED

SEE WHITE SHEET

SIGNATURE

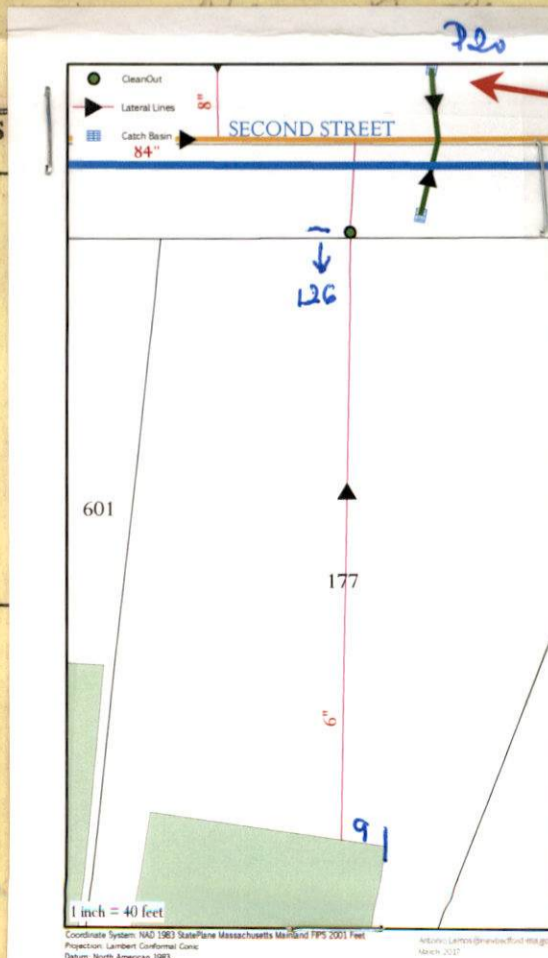

WW-15-19

exp. 01/23/16



PERMIT NO.

CITY OF NEW BEDFORD
SEWER AND/OR STORM DRAIN PERMIT

DATE 6/23/15

24437

This certifies that permission is granted to

Michael Panagiotas 133 Lawrence Corner Rd 508 728 8339
Property Owner Address Tel.

To connect a sewer and/or storm drain located at Cove St N.S. WxS Second St

Assessor's Plot 20 Lot 346 to the sewer and/or storm drain in S Second Street
72 357-358 (Sketch at property like) 5' sec - Steve 6' x 12"

To be laid in accordance with the conditions in this application and the City of New Bedford ordinances.
TYPE OF USE: RESIDENTIAL COMMERCIAL INDUSTRIAL FLOW 500 G.P.D. 2 Bedrooms

If applicant other than actual property owner, attach Letter of Authorization from Property Owner.

Name Mailing Address Tel.

The Bonded Contractor/Drain Layer authorized to perform this work is:

JP Laganan

Name Address Tel.

Type of Pipe Required: PVC SDR 35

PERMIT EXPIRES ONE YEAR AFTER DATE OF ISSUE

- Requires separate connections for sewage and storm drain where applicable. Storm water cannot be discharged to a sanitary sewer.
- All work must be inspected and approved by a D.P.I. inspector before backfilling.
- If this connection is to be part of a private service shared jointly with other building owners, attach copy of Recorded Joint Maintenance Agreement.
- Permits can be issued to Industrial and/or Commercial Applicants only upon receipt and approval by the Commissioner of Public Infrastructure of required plans and supplemental information.
- In addition, a City-issued Industrial User Discharge Permit and/or a Sewer Extension/Connection Permit issued by the Commonwealth of Massachusetts D.E.P. shall be required by the City for Industrial Discharge into the sewer system.

Industrial User Discharge Permit No. Date

Comm. Mass. Sewer Conn./Ext. Permit No. Date

A Filing and Inspection Fee of \$495., plus an Entrance Fee of \$ where applicable, must accompany this application.

Bank# Rockland Trust 11304478 Check# 6343 Date 6/23/15 Receipt# 87176

Other requirements: 24 hour notice for inspection per attached plan, must call DPT to witness pressure test.

Connection made to Sewer Part of jointly-shared private line YES NO
Storm Drain

Applicant agrees to abide by the above terms, as well as all pertinent ordinances of the City of New Bedford, and such other special rules as the Commissioner of Public Infrastructure and/or City Engineer may deem necessary


Michael Panagiotas City Engineer
Property Owner
Signature of Property Owner or Representative
Clerk at the Works

INSPECTOR'S REPORT

INSPECTED BY: _____
DATE: _____
COMMENTS: _____

APPROVED DISAPPROVED

SIGNATURE

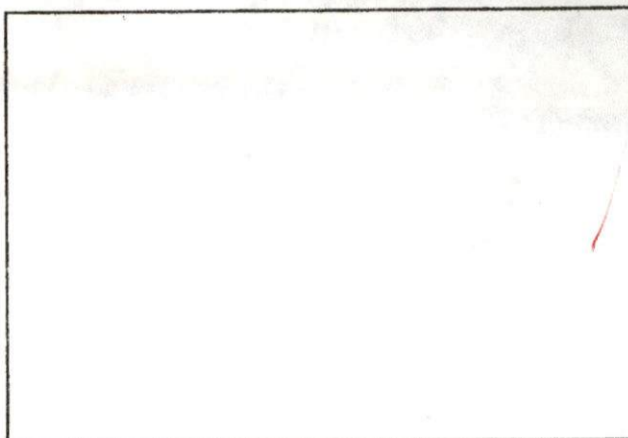

SKETCH PLAN

TWW-15-19

Inspector

exp 12/23/16



PERMIT NO.

CITY OF NEW BEDFORD
SEWER AND/OR STORM DRAIN PERMIT

DATE 12/23/15

24437

This certifies that permission is granted to

Michael Panagiotas 133 Fawcett Corner Rd 508 728 8339
Property Owner Address Tel.

To connect a sewer and/or storm drain located at Cove St N.S. WxS Second St

Assessor's Plot 20 Lot 346 to the sewer and/or storm drain in S Second Street

To be laid in accordance with the conditions in this application and the City of New Bedford ordinances.

TYPE OF USE: RESIDENTIAL COMMERCIAL INDUSTRIAL FLOW 500 G.P.D. 2 Bathrooms

If applicant other than actual property owner, attach Letter of Authorization from Property Owner.

Name Tel.

Mailing Address

The Bonded Contractor/Drain Layer authorized to perform this work is:

JR Lanagan

Name Address Tel.

Type of Pipe Required: PVC SDR 35

PERMIT EXPIRES ONE YEAR AFTER DATE OF ISSUE

- Requires separate connections for sewage and storm drain where applicable. Storm water cannot be discharged to a sanitary sewer.
 - All work must be inspected and approved by a D.P.I. inspector before backfilling.
 - If this connection is to be part of a private service shared jointly with other building owners, attach copy of Recorded Joint Maintenance Agreement.
 - Permits can be issued to Industrial and/or Commercial Applicants only upon receipt and approval by the Commissioner of Public Infrastructure of required plans and supplemental information.
 - In addition, a City-issued Industrial User Discharge Permit and/or a Sewer Extension/Connection Permit issued by the Commonwealth of Massachusetts D.E.P. shall be required by the City for Industrial Discharge into the sewer system.
- Industrial User Discharge Permit No. Date

Comm. Mass. Sewer Conn./Ext. Permit No. Date

A Filing and Inspection Fee of \$495., plus an Entrance Fee of \$ where applicable, must accompany this application.

Bank# 11304478 Check# 6343 Date 12/23/15 Receipt#

Other requirements: 24 hour notice for inspection, as per attached plan, must call D.P.I. to witness pressure test.

Connection made to Sewer Part of jointly-shared private line YES NO
Storm Drain

Applicant agrees to abide by the above terms, as well as all pertinent ordinances of the City of New Bedford, and such other special rules as the Commissioner of Public Infrastructure and/or City Engineer may deem necessary

Michael Panagiotas

City Engineer

Property Owner

Signature of Property Owner or Representative

Clerk of the Works

INSPECTOR'S REPORT

INSPECTED BY: Antonio P. Lima
DATE:
COMMENTS: OK

APPROVED

DISAPPROVED

SIGNATURE

12/23/2015

See Att.

SKETCH PLAN



Commonwealth of Massachusetts

City of New Bedford

133 William Street New Bedford, MA 02740

SEWER PERMIT



Date: **7/16/2015**

No. **WW-15-19**

Sewer Connection Fee: **\$495.00**

Pipe Size: **0.00**

Trench Length: **0.00**

Service Location: **177 COVE ST**

Owner Name: **PANAGAKOS MICHAEL W**

Type of Occupancy: **Commercial**

Type of Work: **Sewer - New Sewer Service**

Work Description: **N.S. WXS SECOND ST
EXISTING SEWER STUB AT PROPERTY LINE**

500 GPD

**SDR 35 PVC
SEWER PERMIT#24437**

**P 72
L 357+358**

No. of Units : **0** Required Design Daily Flow : **0.00** Provided Daily Flow : **0.00**

Installing Company Name: _____ License Type: _____

Address: _____ City/Town/State: _____

Call (781) 942-9077 For Inspection

24437

Work Order Number: 16-012296

12/2/2016
2:49 PM

Category: Service Lateral Gravity Priority: _____
 Problem: Contractor Inspection Crew: _____
 Cause: _____ Supervisor: MANUEL SILVA
 Main Task: Investigate / Inspect Status: New Work Order
 Work Order Start Date/Time: _____ Work Order End Date/Time: _____

Location (s) _____
 177 COVE ST

Comments from Request _____
 MONDAY 12/5/16 @ 12:30 SEWER INSPECTION (JB LANAGAN GARY 508 951 2115)

Task Start Date/Time: _____ Task End Date/Time: _____

Task Code: SWT220 Task Description: Investigate / Inspect

Employee Number	Employee Name	Time Type				Units
		Reg	OT	Normal	Type	
14950	ANTONIO LEMOS	0.00	0.00	0.00	REGULAR TIME	Hours
12/5/2016	1					
12/7/2016	1					
12/9/2016	1					

Equipment Code	Equipment Description	Units

Material Code	Material Description	Units

Fluid Code	Fluid Description	Units

Info: ok.

SEE map.

Antonio Silva

12/9/2016

Work Order Number: 15-001133

12/21/2015
12:00 PM

Category: Service Lateral Gravity Priority: _____
Problem: Contractor Inspection Crew: _____
Cause: _____ Supervisor: _____
Main Task: Investigate / Inspect Status: New Work Order
Work Order Start Date/Time: _____ Work Order End Date/Time: _____

Location (s) _____
COVE ST

Comments from Request
SEWER PERMIT # 24437- COVE ST NS W X S.SECOND ST 12/22/15 INSPECTION 9AM - JOHN 774-930-3872

Task Start Date/Time: _____ Task End Date/Time: _____

Task Code: SWT220 Task Description: Investigate / Inspect


Employee Number	Employee Name	Time Type				Units
		Reg	OT	Normal	Type	
14950	ANTONIO LEMOS	0.00	0.00	0.00	REGULAR TIME	Hours
_____	_____	_____	_____	_____	_____	_____
_____	_____	_____	_____	_____	_____	_____
_____	_____	_____	_____	_____	_____	_____

Equipment Code	Equipment Description	Units
_____	_____	_____
_____	_____	_____
_____	_____	_____

Material Code	Material Description	Units
_____	_____	_____
_____	_____	_____
_____	_____	_____

Fluid Code	Fluid Description	Units
_____	_____	_____
_____	_____	_____
_____	_____	_____

Inspections

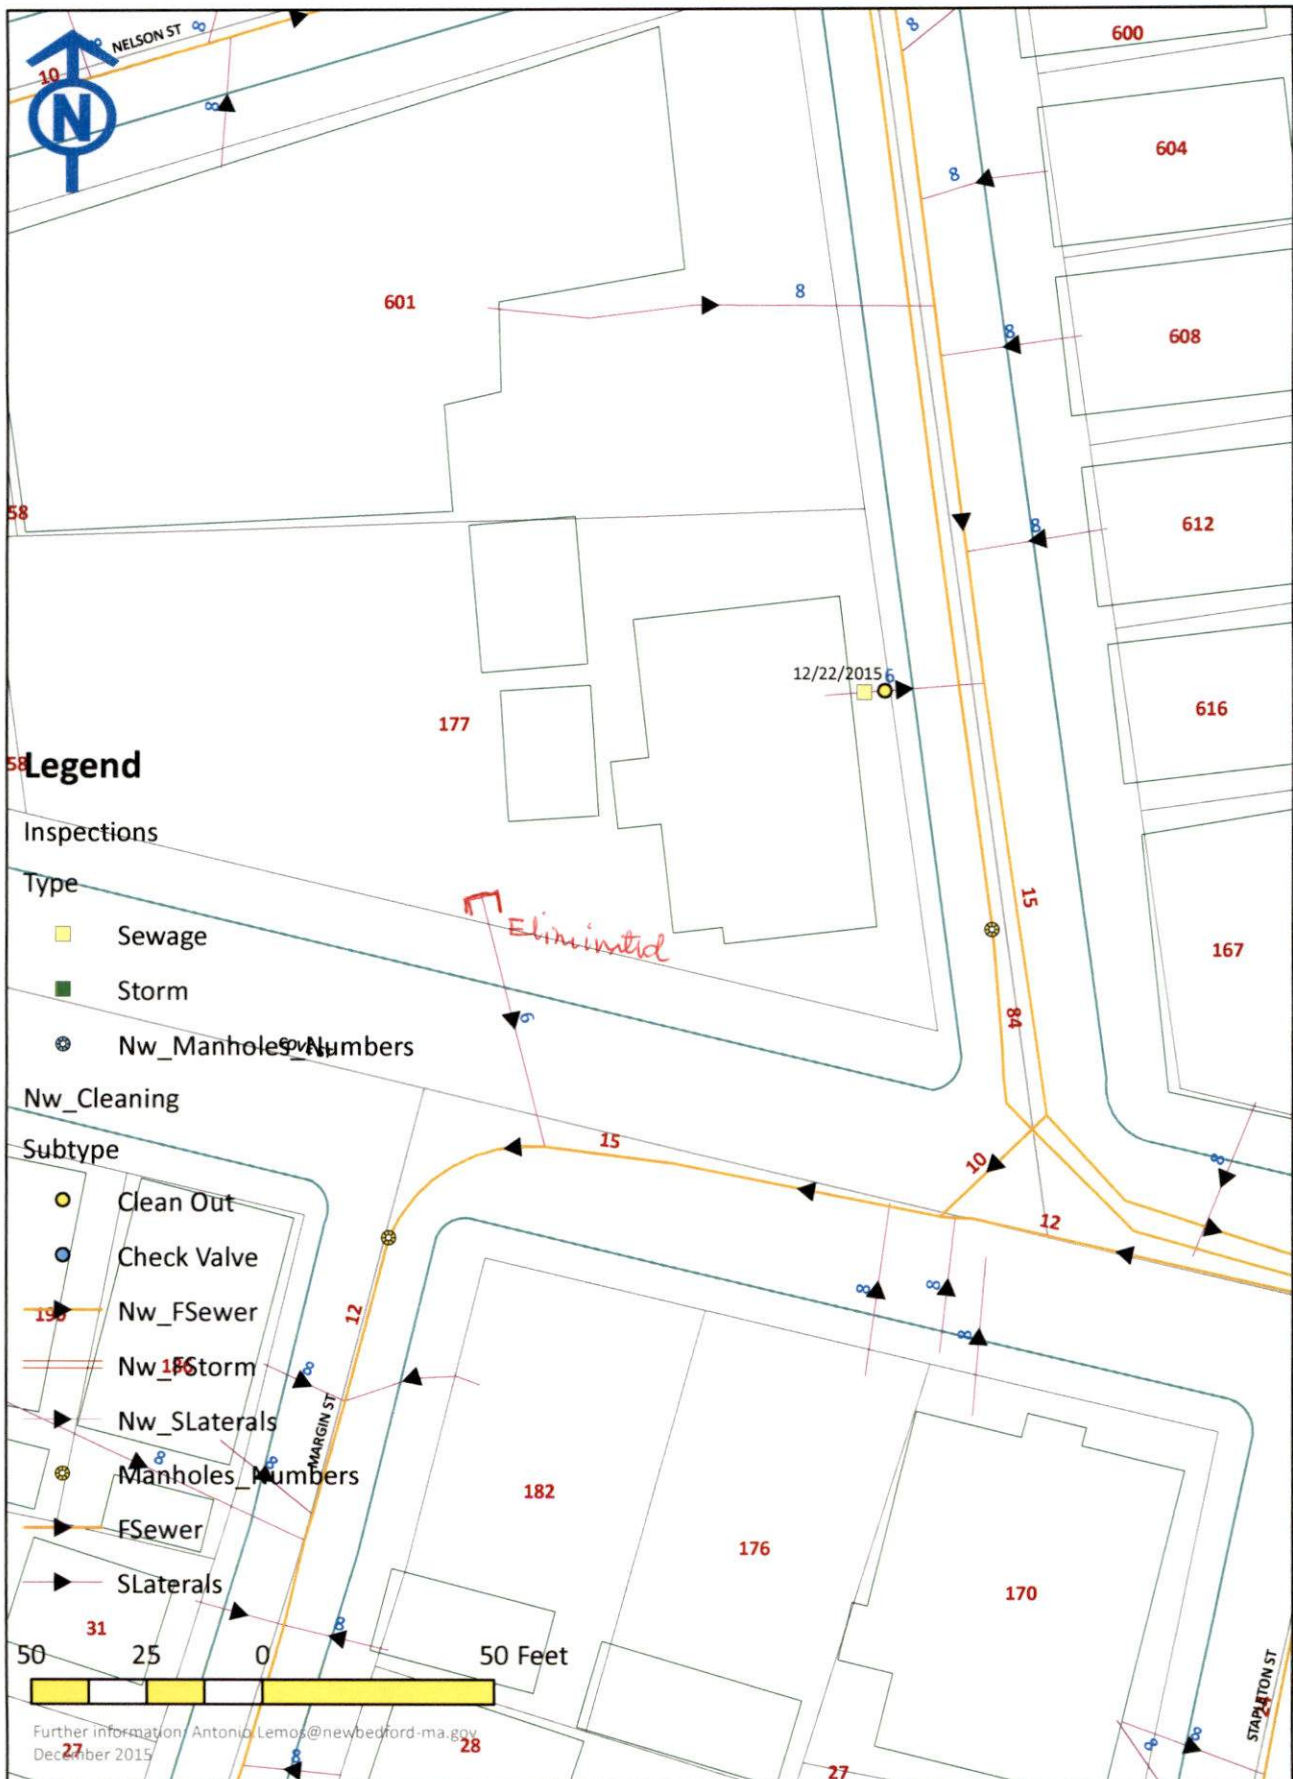

Coordinate System: NAD 1983 StatePlane Massachusetts Mainland FIPS 2001

Projection: Lambert Conformal Conic

Datum: North American 1983

Inspections

