



PERMIT NO.  
24461

CITY OF NEW BEDFORD  
SEWER AND/OR STORM DRAIN PERMIT

DATE 11/30/15

This certifies that permission is granted to

Property Owner MTD Bus Lines Address 1860 Fall River Ave Tel. Section 1A

To connect a sewer and/or storm drain located at 8 Costello Drive (MTD Bus Lines)

Assessor's Plot 84 Lot 8-17, to the sewer and/or storm drain in Street

To be laid in accordance with the conditions in this application and the City of New Bedford ordinances.

TYPE OF USE: RESIDENTIAL COMMERCIAL INDUSTRIAL FLOW G.P.D.

If applicant other than actual property owner, attach Letter of Authorization from Property Owner.

Name Farland Corp Tel. 508 717 3450

Mailing Address 398 County St

The Bonded Contractor/Drain Layer authorized to perform this work is:

Name Farland Corp Address 398 County St Tel. (508) 717-3450

Type of Pipe Required:

PERMIT EXPIRES ONE YEAR AFTER DATE OF ISSUE

- Requires separate connections for sewage and storm drain where applicable. Storm water cannot be discharged to a sanitary sewer.
- All work must be inspected and approved by a D.P.I. inspector before backfilling.
- If this connection is to be part of a private service shared jointly with other building owners, attach copy of Recorded Joint Maintenance Agreement.
- Permits can be issued to Industrial and/or Commercial Applicants only upon receipt and approval by the Commissioner of Public Infrastructure of required plans and supplemental information.
- In addition, a City-issued Industrial User Discharge Permit and/or a Sewer Extension/Connection Permit issued by the Commonwealth of Massachusetts D.E.P. shall be required by the City for Industrial Discharge into the sewer system.

Industrial User Discharge Permit No. Date

Comm. Mass. Sewer Conn./Ext. Permit No. Date

A Filing and Inspection Fee of \$400, plus an Entrance Fee of \$ where applicable, must accompany this application.

Bank# Bayeast Bank Check# 1984 Date 12/3/15 Receipt# 149218

Other requirements: Please call ahead 24 hr notice for inspection

(508) 929-1100 ext 62305

Connection made to Sewer Part of jointly-shared private line YES NO  
Storm Drain

Applicant agrees to abide by the above terms, as well as all pertinent ordinances of the City of New Bedford, and such other special rules as the Commissioner of Public Infrastructure and/or City Engineer may deem necessary


City Engineer David M. Amodeo Signature of Property Owner or Representative

INSPECTOR'S REPORT

INSPECTED BY:  
DATE:  
COMMENTS:

APPROVED DISAPPROVED

SIGNATURE

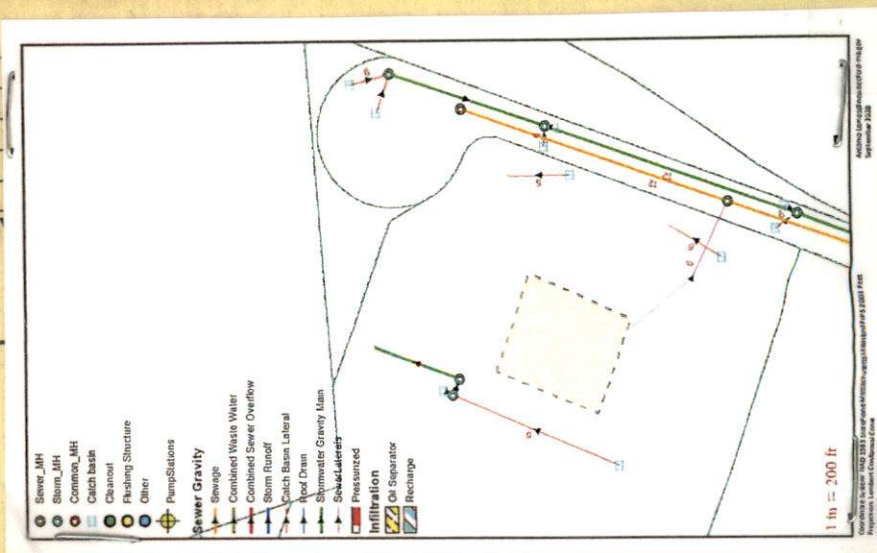





PERMIT NO.  
24461

CITY OF NEW BEDFORD  
SEWER AND/OR STORM DRAIN PERMIT

DATE 11/30/15

This certifies that permission is granted to

MTD Bus Lines 1860 Fall River Ave  
Property Owner Address Seekonk, MA Tel.

To connect a sewer and/or storm drain located at 8 Castaldi Drive (MTD Bus Lines)

Assessor's Plot 84 Lot 8 to the sewer and/or storm drain in Industrial Park Street

line at Town of Dornouth.

To be laid in accordance with the conditions in this application and the City of New Bedford ordinances.

TYPE OF USE: RESIDENTIAL COMMERCIAL INDUSTRIAL FLOW G.P.D.

208 I

If applicant other than actual property owner, attach Letter of Authorization from Property Owner.

Name Farland Corp Tel. 508 717-3450

Mailing Address 398 County St

The Bonded Contractor/Drain Layer authorized to perform this work is:

Name Farland Corp Address 398 County St Tel. (508) 717-3450

Type of Pipe Required:

PERMIT EXPIRES ONE YEAR AFTER DATE OF ISSUE

- Requires separate connections for sewage and storm drain where applicable. Storm water cannot be discharged to a sanitary sewer.
- All work must be inspected and approved by a D.P.I. inspector before backfilling.
- If this connection is to be part of a private service shared jointly with other building owners, attach copy of Recorded Joint Maintenance Agreement.
- Permits can be issued to Industrial and/or Commercial Applicants only upon receipt and approval by the Commissioner of Public Infrastructure of required plans and supplemental information.
- In addition, a City-issued Industrial User Discharge Permit and/or a Sewer Extension/Connection Permit issued by the Commonwealth of Massachusetts D.E.P. shall be required by the City for Industrial Discharge into the sewer system.

Industrial User Discharge Permit No. Date.

Comm. Mass. Sewer Conn./Ext. Permit No. Date.

A Filing and Inspection Fee of \$450.00, plus an Entrance Fee of \$ where applicable, must accompany this application.

Bank# Baycoast Bnk Check# 1984 Date 12/3/15 Receipt# 149218

Other requirements: Please call ahead 24hr notice for inspection

2(508) 979-1530 ext 67305

Connection made to Sewer Part of jointly-shared private line YES NO  
Storm Drain

Applicant agrees to abide by the above terms, as well as all pertinent ordinances of the City of New Bedford, and such other special rules as the Commissioner of Public Infrastructure and/or City Engineer may deem necessary

City Engineer Signature of Property Owner or Representative

INSPECTOR'S REPORT

INSPECTED BY: DATE: COMMENTS:

APPROVED DISAPPROVED

SIGNATURE

SKETCH PLAN





**CITY OF NEW BEDFORD**  
Jonathan F. Mitchell, Mayor

**Department of Public Infrastructure**

Ronald H. Labelle  
Commissioner

Water  
Wastewater  
Highways  
Engineering  
Cemetery

**To Whom It May Concern:**

I MARIO DINIS 1860 FALL RIVER AVE SEEKONK, MA, being  
(Name) (Mailing Address)

**Owner of property located at**

8 CASTALDI DRIVE, NEW BEDFORD INDUSTRIAL PARK, DARTMOUTH, MA

Plot 84, Lot 8-, hereby agree to allow FARLAND CORP  
(Name)

398 COUNTY RD NEW BEDFORD, to act on my behalf including affixing my  
(Mailing Address)

**signature in securing permit for:**

☐ Sewer/Drain Service Permits  
☒ Water Service Permits  
☐ Driveway Installation Permits  
☐ Sidewalk Installation Permits

**I further agree to conform to, and abide by, All City rules and ask regulations applicable to the permit (s) being applied for:**

Name Mario Dinis  
Signature

5 CASTALDI DR DARTMOUTH, MA  
Address

12-2-15 508-336-7111  
Date Telephone number

FC14-039



Inspector 11/30/16

PERMIT NO.  
24461

CITY OF NEW BEDFORD  
SEWER AND/OR STORM DRAIN PERMIT

DATE 11/30/15

This certifies that permission is granted to

Property Owner MTD Bus Lines Address 1800 Fall River Ave Tel. Seekonk, MA

To connect a sewer and/or storm drain located at 8 Castalds Drive (MTD Bus Lines)

Assessor's Plot 84 Lot 8-7, to the sewer and/or storm drain in Industrial Park Street line at Town of Dornmouth

To be laid in accordance with the conditions in this application and the City of New Bedford ordinances.

TYPE OF USE: RESIDENTIAL COMMERCIAL INDUSTRIAL FLOW \_\_\_\_\_ G.P.D.

If applicant other than actual property owner, attach Letter of Authorization from Property Owner.

Name Farland Corp Tel. 508 717-3480

Mailing Address 398 County St

The Bonded Contractor/Drain Layer authorized to perform this work is:

Name Farland Corp Address 398 County St Tel. (508) 717-3480

Type of Pipe Required: \_\_\_\_\_

PERMIT EXPIRES ONE YEAR AFTER DATE OF ISSUE

- Requires separate connections for sewage and storm drain where applicable. Storm water cannot be discharged to a sanitary sewer.
  - All work must be inspected and approved by a D.P.I. inspector before backfilling.
  - If this connection is to be part of a private service shared jointly with other building owners, attach copy of Recorded Joint Maintenance Agreement.
  - Permits can be issued to Industrial and/or Commercial Applicants only upon receipt and approval by the Commissioner of Public Infrastructure of required plans and supplemental information.
  - In addition, a City-issued Industrial User Discharge Permit and/or a Sewer Extension/Connection Permit issued by the Commonwealth of Massachusetts D.E.P. shall be required by the City for Industrial Discharge into the sewer system.
- Industrial User Discharge Permit No. \_\_\_\_\_ Date \_\_\_\_\_

Comm. Mass. Sewer Conn./Ext. Permit No. \_\_\_\_\_ Date \_\_\_\_\_

A Filing and Inspection Fee of \$ 450.00, plus an Entrance Fee of \$ \_\_\_\_\_ where applicable, must accompany this application.

Bank# Baycoast Bnk Check# 1984 Date 12/3/15 Receipt# 119218

Other requirements: Please call ahead 24hr notice for inspection

2(508) 991-1500 ext 67305

Connection made to Sewer Part of jointly-shared private line YES NO  
Storm Drain

Applicant agrees to abide by the above terms, as well as all pertinent ordinances of the City of New Bedford, and such other special rules as the Commissioner of Public Infrastructure and/or City Engineer may deem necessary

David M. Amodeo  
City Engineer


[Signature]  
Signature of Property Owner or Representative

INSPECTOR'S REPORT

INSPECTED BY: \_\_\_\_\_  
DATE: \_\_\_\_\_  
COMMENTS: \_\_\_\_\_

APPROVED \_\_\_\_\_ DISAPPROVED \_\_\_\_\_

SIGNATURE

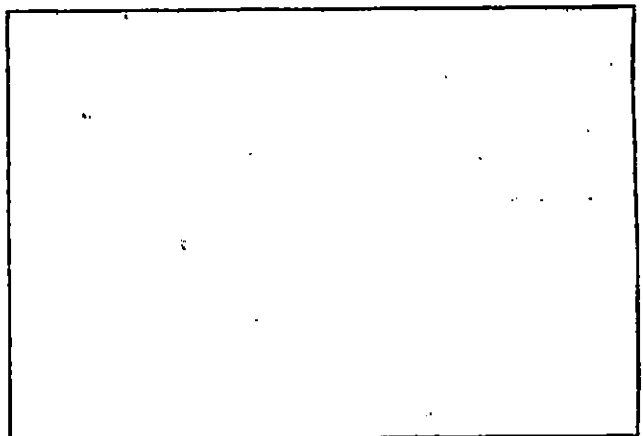

SKETCH PLAN