

TWW-16-10

Exp 5/19/17



PERMIT NO.
24476

CITY OF NEW BEDFORD
SEWER AND/OR STORM DRAIN PERMIT

DATE 5/18/16

This certifies that permission is granted to

DPM Development 7 Lambeth St New Bedford MA 02740 508 9930381
Property Owner Address Tel.

To connect a sewer and/or storm drain located at W.S. 30' (+/-) 11x Meadow Street

Assessor's Plot 137 Lot 279, to the sewer and/or storm drain in Meadow Street

To be laid in accordance with the conditions in this application and the City of New Bedford ordinances.

TYPE OF USE: RESIDENTIAL COMMERCIAL INDUSTRIAL FLOW 330 G.P.D.

If applicant other than actual property owner, attach Letter of Authorization from Property Owner.

Name Mailing Address Tel.

The Bonded Contractor/Drain Layer authorized to perform this work is:

Name Address Tel.

Type of Pipe Required: PVC SDR 35

PERMIT EXPIRES ONE YEAR AFTER DATE OF ISSUE

- Requires separate connections for sewage and storm drain where applicable. Storm water cannot be discharged to a sanitary sewer.
- All work must be inspected and approved by a D.P.I. inspector before backfilling.
- If this connection is to be part of a private service shared jointly with other building owners, attach copy of Recorded Joint Maintenance Agreement.
- Permits can be issued to Industrial and/or Commercial Applicants only upon receipt and approval by the Commissioner of Public Infrastructure of required plans and supplemental information.
- In addition, a City-issued Industrial User Discharge Permit and/or a Sewer Extension/Connection Permit issued by the Commonwealth of Massachusetts D.E.P. shall be required by the City for Industrial Discharge into the sewer system.

Industrial User Discharge Permit No. Date

Comm. Mass. Sewer Conn./Ext. Permit No. Date

A Filing and Inspection Fee of \$450, plus an Entrance Fee of \$ where applicable, must accompany this application.

Bank# Webster Bank Check# 6734 Date 5/19/16 Receipt# 4144634

Other requirements: Please call 24 hours in advance for inspection

Connection made to Sewer Storm Drain Part of jointly-shared private line YES NO

Applicant agrees to abide by the above terms, as well as all pertinent ordinances of the City of New Bedford, and such other special rules as the Commissioner of Public Infrastructure and/or City Engineer may deem necessary

David M. Amadio
City Engineer
Clerk of the Works


Rosa Mary
Signature of Property Owner or Representative

INSPECTOR'S REPORT


INSPECTED BY: DATE: COMMENTS:

APPROVED DISAPPROVED

SIGNATURE

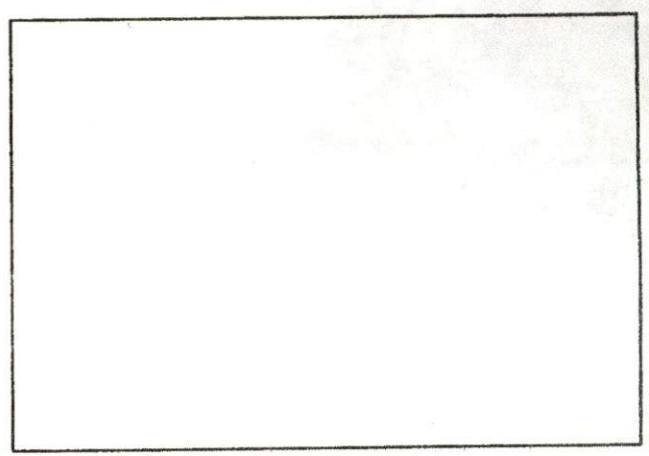


SKETCH PLAN

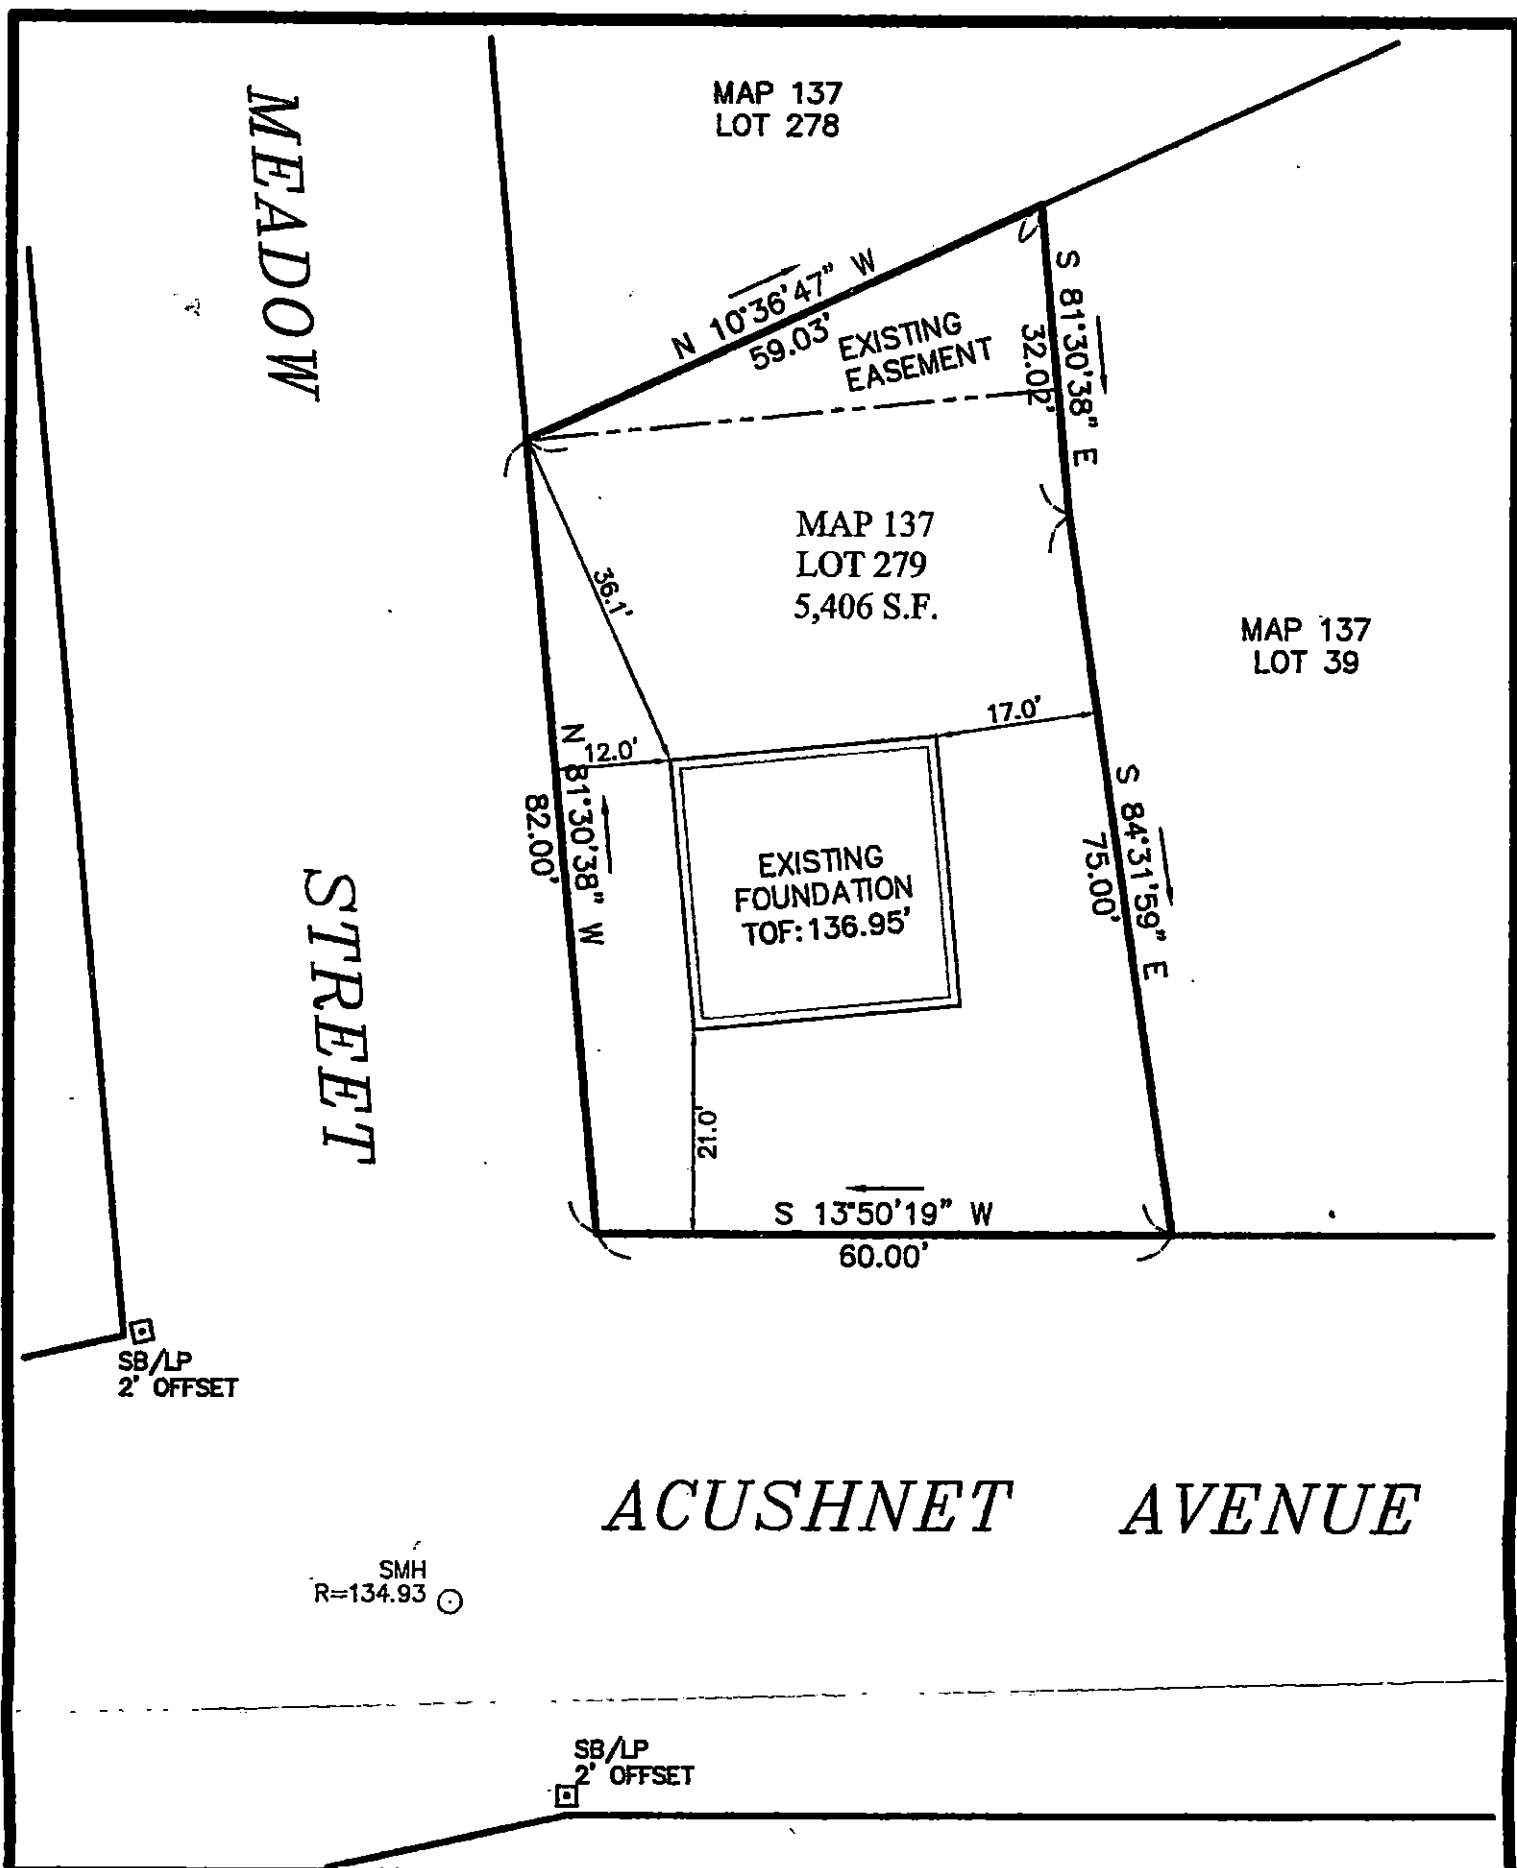

AS BUILT FOUNDATION PLAN - MAP 137 LOT 279

MEADOW ST. / ACUSHNET AVE.
IN
NEW BEDFORD, MA.

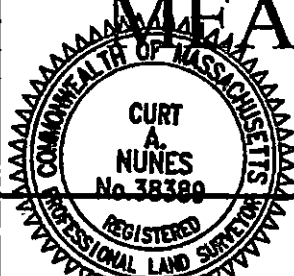

I CERTIFY THAT THE FOUNDATION SHOWN
HEREON, AS BUILT, CONFORMS TO THE CITY
OF NEW BEDFORD ZONING SETBACK
REQUIREMENTS, AND THAT SAID FOUNDATION,
AS BUILT, DOES NOT LIE IN A F.I.R.M. FLOOD
HAZARD ZONE.

PROFESSIONAL LAND SURVEYOR


5/16/16
DATE

DATE: MAY 16, 2016

SCALE: 1" = 20'

ROMANELLI ASSOCIATES INC.
PROFESSIONAL LAND SURVEYORS

1162 Rockdale Ave. New Bedford, MA 02740
Phone (508) 995-0100 - (508) 995-6678
WWW.ROMANELLI-INC.COM

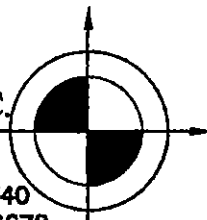

JN 16-071