



PERMIT NO.

24499

CITY OF NEW BEDFORD  
SEWER AND/OR STORM DRAIN PERMIT

DATE 12/16/17

This certifies that permission is granted to

Michael W. Pinagarakos 133 France corner RD - SDR-3210-875  
Property Owner Address Tel.

To connect a sewer and/or storm drain located at Belleville RD (W.S.) 87' W x Acushnet Ave

Assessor's Plot 108 Lot 42, to the sewer and/or storm drain in Belleville RD Street

To be laid in accordance with the conditions in this application and the City of New Bedford ordinances.

TYPE OF USE: RESIDENTIAL COMMERCIAL INDUSTRIAL FLOW G.P.D.

If applicant other than actual property owner, attach Letter of Authorization from Property Owner.

Name Tel.

Mailing Address

The Bonded Contractor/Drain Layer authorized to perform this work is:

Name Address Tel.

Type of Pipe Required: 24" (canagan)

## PERMIT EXPIRES ONE YEAR AFTER DATE OF ISSUE

- Requires separate connections for sewage and storm drain where applicable. Storm water cannot be discharged to a sanitary sewer.
  - All work must be inspected and approved by a D.P.I. inspector before backfilling.
  - If this connection is to be part of a private service shared jointly with other building owners, attach copy of Recorded Joint Maintenance Agreement.
  - Permits can be issued to Industrial and/or Commercial Applicants only upon receipt and approval by the Commissioner of Public Infrastructure of required plans and supplemental information.
  - In addition, a City-issued Industrial User Discharge Permit and/or a Sewer Extension/Connection Permit issued by the Commonwealth of Massachusetts D.E.P. shall be required by the City for Industrial Discharge into the sewer system.
- Industrial User Discharge Permit No. Date

Comm. Mass. Sewer Conn./Ext. Permit No. Date

A Filing and Inspection Fee of \$150, plus an Entrance Fee of \$ where applicable, must accompany this application.

Bank# Bay Coast Bank Check# 38409 Date 12/16/17 Receipt# 816555

Other requirements: Please contact A.S. with 24 hours for inspection

Connection made to Sewer Part of jointly-shared private line YES NO  
Storm Drain

Applicant agrees to abide by the above terms, as well as all pertinent ordinances of the City of New Bedford, and such other special rules as the Commissioner of Public Infrastructure and/or City Engineer may deem necessary

X: Norman Amadi  
City Engineer  
Clerk of the Works

Signature of Property Owner or Representative

## INSPECTOR'S REPORT


INSPECTED BY:

DATE:

COMMENTS:

APPROVED

DISAPPROVED

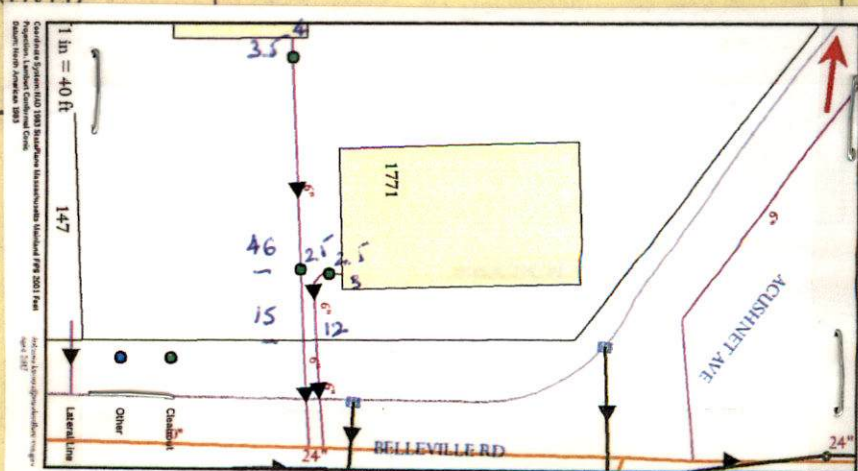SEE INSP. WORK ORDER  
SIGNATURE





PERMIT NO.  
24499

CITY OF NEW BEDFORD  
SEWER AND/OR STORM DRAIN PERMIT

exp: 12/16/17  
DATE 12/16/10

This certifies that permission is granted to

Michael W. Panagakos 133 Faunce corner ED - 508-326-875  
Property Owner Address Tel.

To connect a sewer and/or storm drain located at Belleville RD (N.S.) 87' W x acushnet ave

Assessor's Plot 108 Lot 42, to the sewer and/or storm drain in Belleville RD Street

To be laid in accordance with the conditions in this application and the City of New Bedford ordinances.

TYPE OF USE: RESIDENTIAL COMMERCIAL INDUSTRIAL FLOW G.P.D.

If applicant other than actual property owner, attach Letter of Authorization from Property Owner.

Name Tel.

Mailing Address

The Bonded Contractor/Drain Layer authorized to perform this work is:

Name Address Tel.

Type of Pipe Required: 36 Lanagan

PERMIT EXPIRES ONE YEAR AFTER DATE OF ISSUE

- Requires separate connections for sewage and storm drain where applicable. Storm water cannot be discharged to a sanitary sewer.
- All work must be inspected and approved by a D.P.I. inspector before backfilling.
- If this connection is to be part of a private service shared jointly with other building owners, attach copy of Recorded Joint Maintenance Agreement.
- Permits can be issued to Industrial and/or Commercial Applicants only upon receipt and approval by the Commissioner of Public Infrastructure of required plans and supplemental information.
- In addition, a City-issued Industrial User Discharge Permit and/or a Sewer Extension/Connection Permit issued by the Commonwealth of Massachusetts D.E.P. shall be required by the City for Industrial Discharge into the sewer system.

Industrial User Discharge Permit No. Date

Comm. Mass. Sewer Conn./Ext. Permit No. Date

A Filing and Inspection Fee of \$450, plus an Entrance Fee of \$ where applicable, must accompany this application.

Bank# Bay Coast Bank Check# 38409 Date 12/16/14 Receipt# 816555

Other requirements: Please contact us with 24 hours for inspection.

Connection made to Sewer Storm Drain Part of jointly-shared private line YES NO

Applicant agrees to abide by the above terms, as well as all pertinent ordinances of the City of New Bedford, and such other special rules as the Commissioner of Public Infrastructure and/or City Engineer may deem necessary

X: [Signature] City Engineer


[Signature] Signature of Property Owner or Representative

INSPECTOR'S REPORT

INSPECTED BY: DATE: COMMENTS:

APPROVED DISAPPROVED

SIGNATURE

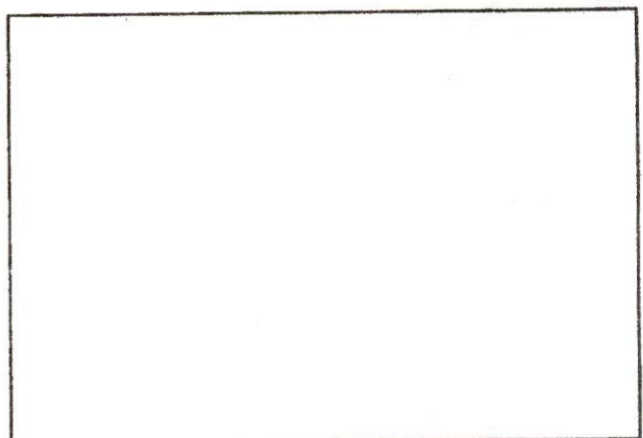

SKETCH PLAN

APPLICATION/AGREEMENT  
For Trench/Disturbance Permit within the City of New Bedford

Permit # 32-14  
Dig Safe # 2014-480-9107

Date 12/16/14

TO THE MAYOR AND CITY COUNCIL:

DISTURBANCE PERMIT

TRENCH SAFETY PERMIT

Permission is hereby requested to excavate the surface of: \_\_\_\_\_ City Property and/or ☒ Private Property  
Provide Sketch

Location of Work: 1771 Acushnet Ave

FOR INSPECTION ONLY A 24 HOUR  
NOTICE IS REQUIRED AND THE  
CONTRACTOR/APPLICANT IS  
REQUIRED TO NOTIFY THE D.P.I.  
@ 508 979-1550 Press 6 Repair

Substantially as per plan annexed, for the purpose of: Connect water,  
sewer and drainage

Work will begin (weather permitting) on: 12/16/14

Work will end (weather permitting) on: 3/16/14

ROADWAY CLOSURES WILL REQUIRE  
AUTHORIZATION FROM THE  
COMMISSIONER OF PUBLIC  
INFRASTRUCTURE. TRAFFIC MANAGEMENT  
PLANS MAY BE REQUIRED.

Applicant Name: Ann Church Excavator(s) Name: on file

Company Name: JB Lanagan + Company Hoisting Equipment License Number: \_\_\_\_\_  
Grade: \_\_\_\_\_ Expiration Date: \_\_\_\_\_

Contact Number: 508-984-1668 Name & Contact Number of Insurer: on file

Competent Person on Work Site: Ann Church APPROVED BY: Norman Amado DATE: 12/16/14

TITLE: Clerk of the Works

This permit shall be posted at the work site, and shall remain until the work is completed. It is subject to inspection at all times.



Work Order Number: 16-013064

12/22/2016  
8:16 AM

Category: Service Lateral Gravity Priority: \_\_\_\_\_  
Problem: Contractor Inspection Crew: \_\_\_\_\_  
Cause: \_\_\_\_\_ Supervisor: MANUEL SILVA  
Main Task: Investigate / Inspect Status: New Work Order  
Work Order Start Date/Time: \_\_\_\_\_ Work Order End Date/Time: \_\_\_\_\_

Location (s) \_\_\_\_\_  
1771 ACUSHNET AVE

Comments from Request \_\_\_\_\_  
sewer inspection-12/28 @10am

Task Start Date/Time: \_\_\_\_\_ Task End Date/Time: \_\_\_\_\_

Task Code: SWT220 Task Description: Investigate / Inspect

Employee Number	Employee Name	Time Type				Units
		Reg	OT	Normal	Type	
14950	ANTONIO LEMOS	0.00	0.00	0.00	REGULAR TIME	Hours

_____	_____	_____	_____	_____	_____	_____
_____	_____	_____	_____	_____	_____	_____
_____	_____	_____	_____	_____	_____	_____

Equipment Code	Equipment Description	Units
----------------	-----------------------	-------

_____	_____	_____
_____	_____	_____
_____	_____	_____

Material Code	Material Description	Units
---------------	----------------------	-------

_____	_____	_____
_____	_____	_____
_____	_____	_____

Fluid Code	Fluid Description	Units
------------	-------------------	-------

_____	_____	_____
_____	_____	_____
_____	_____	_____

Info: OK.  
See map.  
2 NEW SERVICE.  
Antonio Silva  
12/28/2016