



PERMIT NO.

24514

CITY OF NEW BEDFORD
SEWER AND/OR STORM DRAIN PERMIT

DATE 5/16/17

This certifies that permission is granted to

Property Owner Panagiotis Akelloropoulos Address 763 Hathaway Rd Tel. (508) 742-3267

To connect a sewer and/or storm drain located at 763 Hathaway Rd

Assessor's Plot 121 Lot 76, to the sewer and/or storm drain in Common 10' Sewer on Hathaway Rd Street

To be laid in accordance with the conditions in this application and the City of New Bedford ordinances.
TYPE OF USE: RESIDENTIAL COMMERCIAL INDUSTRIAL FLOW G.P.D.

If applicant other than actual property owner, attach Letter of Authorization from Property Owner.
Name N/A Tel. N/A
Mailing Address N/A

The Bonded Contractor/Drain Layer authorized to perform this work is:
Name MT CANESSA Address N/A Tel. N/A
Type of Pipe Required: N/A

PERMIT EXPIRES ONE YEAR AFTER DATE OF ISSUE

- Requires separate connections for sewage and storm drain where applicable. Storm water cannot be discharged to a sanitary sewer.
 - All work must be inspected and approved by a D.P.I. inspector before backfilling.
 - If this connection is to be part of a private service shared jointly with other building owners, attach copy of Recorded Joint Maintenance Agreement.
 - Permits can be issued to Industrial and/or Commercial Applicants only upon receipt and approval by the Commissioner of Public Infrastructure of required plans and supplemental information.
 - In addition, a City-issued Industrial User Discharge Permit and/or a Sewer Extension/Connection Permit issued by the Commonwealth of Massachusetts D.E.P. shall be required by the City for Industrial Discharge into the sewer system.
- Industrial User Discharge Permit No. N/A Date N/A

Comm. Mass. Sewer Conn./Ext. Permit No. N/A Date N/A
A Filing and Inspection Fee of \$ 450.00, plus an Entrance Fee of \$ N/A where applicable, must accompany this application.

Bank# Bank of America Check# 213 Date 5/16/17 Receipt# 1093727

Other requirements: N/A

Connection made to Sewer Part of jointly-shared private line YES NO
Storm Drain

Applicant agrees to abide by the above terms, as well as all pertinent ordinances of the City of New Bedford, and such other special rules as the Commissioner of Public Infrastructure and/or City Engineer may deem necessary


City Engineer Adm. Manager Signature of Property Owner or Representative Panagiotis Akelloropoulos

INSPECTOR'S REPORT

INSPECTED BY: SEE WHITE SHEET
DATE: N/A
COMMENTS: N/A

APPROVED N/A DISAPPROVED N/A

SIGNATURE N/A

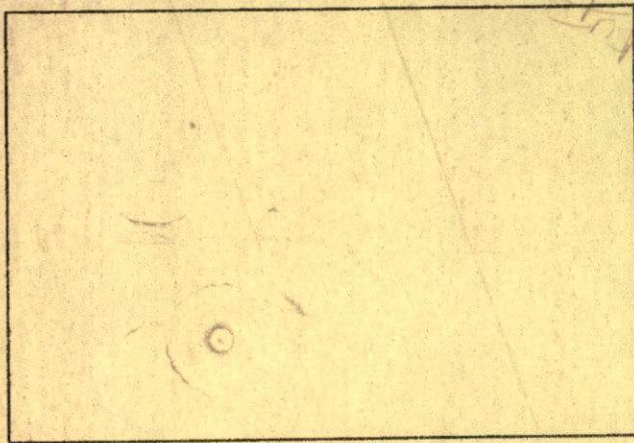

SKETCH PLAN



NW-17-14

Expires 5/16/18

MIT NO.
24514

CITY OF NEW BEDFORD
SEWER AND/OR STORM DRAIN PERMIT

DATE 5/16/17

This certifies that permission is granted to

Property Owner Paragiotis, Akellarios Address 763 Hathaway Rd Tel. (508) 742-3267
New Bedford

To connect a sewer and/or storm drain located at 763 Hathaway Rd

Assessor's Plot 121 Lot 76, to the sewer and/or storm drain in Connect 10' Sewer on Hathaway Rd
Sewer growthy flow, & eliminate E-1 pumps

To be laid in accordance with the conditions in this application and the City of New Bedford ordinances.

TYPE OF USE: RESIDENTIAL COMMERCIAL INDUSTRIAL FLOW _____ G.P.D.

If applicant other than actual property owner, attach Letter of Authorization from Property Owner.

Name _____ Tel. _____

Mailing Address _____

The Bonded Contractor/Drain Layer authorized to perform this work is:

Name P. J. CANESSA Address _____ Tel. _____

Type of Pipe Required: _____

PERMIT EXPIRES ONE YEAR AFTER DATE OF ISSUE

- Requires separate connections for sewage and storm drain where applicable. Storm water cannot be discharged to a sanitary sewer.
- All work must be inspected and approved by a D.P.I. inspector before backfilling.
- If this connection is to be part of a private service shared jointly with other building owners, attach copy of Recorded Joint Maintenance Agreement.
- Permits can be issued to Industrial and/or Commercial Applicants only upon receipt and approval by the Commissioner of Public Infrastructure of required plans and supplemental information.
- In addition, a City-issued Industrial User Discharge Permit and/or a Sewer Extension/Connection Permit issued by the Commonwealth of Massachusetts D.E.P. shall be required by the City for Industrial Discharge into the sewer system.

Industrial User Discharge Permit No. _____ Date _____

Comm. Mass. Sewer Conn./Ext. Permit No. _____ Date _____

A Filing and Inspection Fee of \$ 450.00, plus an Entrance Fee of \$ _____ where applicable, must accompany this application.

Bank# Bank of America Check# 213 Date 5/16/17 Receipt# 1093727

Other requirements: _____ FOR INSPECTION ONLY A 24 HOUR
NOTICE IS REQUIRED AND THE
CONTRACTOR/APPLICANT IS
REQUIRED TO NOTIFY THE D.P.I.
Se' @ 508 979-1550 Press 4 Repair

Connection made to _____ YES NO
Storm Drain

Applicant agrees to abide by the above terms, as well as all pertinent ordinances of the City of New Bedford, and such other special rules as the Commissioner of Public Infrastructure and/or City Engineer may deem necessary

City Engineer
Admin. Manager


X. _____
Signature of Property Owner or Representative

INSPECTOR'S REPORT

INSPECTED BY: _____
DATE: _____
COMMENTS: _____

APPROVED _____ DISAPPROVED _____

SIGNATURE

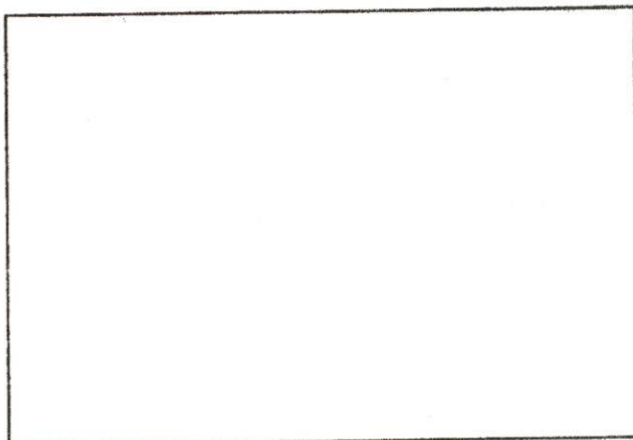

SKETCH PLAN



7-28-17
@ 1:00 PM

Inspector expires 5/16/18

PERMIT NO.
24514

CITY OF NEW BEDFORD
SEWER AND/OR STORM DRAIN PERMIT

DATE 5/16/17

This certifies that permission is granted to

Property Owner: Panagiotis Bakellaropoulos Address: 763 Hathaway Rd New Bedford Tel: (508) 742-3267

To connect a sewer and/or storm drain located at 763 Hathaway Rd

Assessor's Plot 121 Lot 76, to the sewer and/or storm drain in Connect 10' Sewer on Hathaway Rd
Sewer growthy flow, & eliminate E-1 pumps

To be laid in accordance with the conditions in this application and the City of New Bedford ordinances.

TYPE OF USE: RESIDENTIAL COMMERCIAL INDUSTRIAL FLOW _____ G.P.D.

If applicant other than actual property owner, attach Letter of Authorization from Property Owner.

Name: N/A Tel: _____

Mailing Address: _____

The Bonded Contractor/Drain Layer authorized to perform this work is:

Name: P. J. CANESSA Address: _____ Tel: _____

Type of Pipe Required: _____

PERMIT EXPIRES ONE YEAR AFTER DATE OF ISSUE

- Requires separate connections for sewage and storm drain where applicable. Storm water cannot be discharged to a sanitary sewer.
 - All work must be inspected and approved by a D.P.I. inspector before backfilling.
 - If this connection is to be part of a private service shared jointly with other building owners, attach copy of Recorded Joint Maintenance Agreement.
 - Permits can be issued to Industrial and/or Commercial Applicants only upon receipt and approval by the Commissioner of Public Infrastructure of required plans and supplemental information.
 - In addition, a City-issued Industrial User Discharge Permit and/or a Sewer Extension/Connection Permit issued by the Commonwealth of Massachusetts D.E.P. shall be required by the City for Industrial Discharge into the sewer system.
- Industrial User Discharge Permit No. _____ Date: _____

Comm. Mass. Sewer Conn./Ext. Permit No. _____ Date: _____

A Filing and Inspection Fee of \$ 450.00, plus an Entrance Fee of \$ _____ where applicable, must accompany this application.

Bank# Bank of America Check# 213 Date 5/16/17 Receipt# 1093727

Other requirements: _____
FOR INSPECTION ONLY A 24 HOUR
NOTICE IS REQUIRED AND THE
CONTRACTOR/APPLICANT IS
REQUIRED TO NOTIFY THE D.P.I.
Se: @ 508 979-1550 Press 4 Repair

Connection made to _____ YES NO
Storm Drain

Applicant agrees to abide by the above terms, as well as all pertinent ordinances of the City of New Bedford, and such other special rules as the Commissioner of Public Infrastructure and/or City Engineer may deem necessary

City Engineer: Admin. Manager Signature of Property Owner or Representative: [Signature]


INSPECTOR'S REPORT

INSPECTED BY: Antonio Lemor
DATE: 7/28/2017
COMMENTS: _____

APPROVED

DISAPPROVED

Antonio Lemor
SIGNATURE

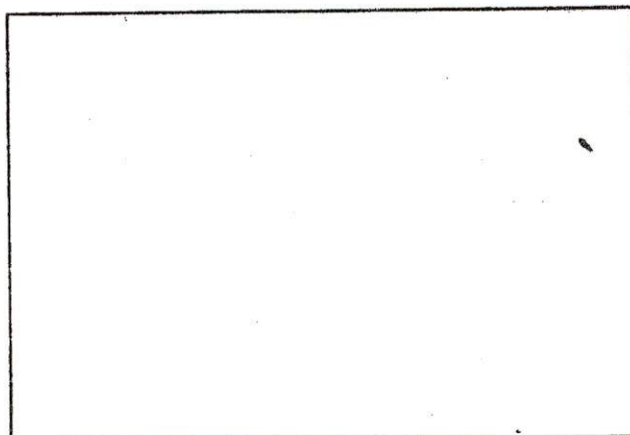

SKETCH PLAN

DISPLAY PERMIT IN A CONSPICUOUS PLACE ON THE PREMISES



Commonwealth of Massachusetts

City of New Bedford

133 William Street New Bedford, MA 02740

SEWER PERMIT



Date: **6/7/2017**

No. **WW-17-14**

Sewer Connection Fee: **\$450.00**

Pipe Size: **0.00**

Trench Length: **0.00**

Service Location: **763 HATHAWAY RD**

Owner Name: **VELIKA REALTY TRUST**

Type of Occupancy: **Residential**

Type of Work: **Sewer - New Sewer Service**

Work Description: **sewer #24514**

**P.121
L.76**

**763 Hathaway Rd
connecting 10; sewer on Hathaway Rd.**

No. of Units : **0** Required Design Daily Flow : **0.00** Provided Daily Flow : **0.00**

The undersigned petitions you to grant permission to ENTER INTO THE MAIN SEWER and, if such permission is granted, hereby agrees to the following:

1. To abide by the conditions and regulations imposed by the Commissioner of Public Works by statute or by ordinance now in force, or as amended from time to time.
2. That the connection of said sewer with the main sewer shall be inspected by an employee of the department of Public Works or by a designated agent of the Town before burial of said connection.
3. That the work shall at all times be under the direction and control of the Commissioner of Public Works or his authorized agent, and that any expense incurred by the Town shall be charged to the permittee, and said permittee agrees to reimburse the Town for said expense.

Installing Company Name: **Robert J. Canessa**

License Type: **DPI - Other**

Address: **P. O. Box 51643**

City/Town/State: **New Bedford**

MA

Call (781) 942-9077 For Inspection

Work Order Number: 17-009037

7/27/2017
11:44 AM

Category: Water Service Priority: _____
Problem: Locate Request Crew: _____
Cause: _____ Supervisor: DANIEL PERRY
Main Task: Inspect Status: New Work Order
Work Order Start Date/Time: _____ Work Order End Date/Time: _____

Location (s) _____
763 HATHAWAY RD

Comments from Request
SEWER INSPECTION FOR 7/28/17 @1:00PM CANESSA

Task Start Date/Time: _____ Task End Date/Time: _____

Task Code: WDT300 Task Description: Inspect

Employee Number	Employee Name	Time Type				Units
		Reg	OT	Normal	Type	
14950	ANTONIO LEMOS	0.00	0.00	0.00	REGULAR TIME	Hours

_____	_____	_____	_____	_____	_____	_____
_____	_____	_____	_____	_____	_____	_____
_____	_____	_____	_____	_____	_____	_____

Equipment Code	Equipment Description	Units
_____	_____	_____
_____	_____	_____
_____	_____	_____

Material Code	Material Description	Units
_____	_____	_____
_____	_____	_____
_____	_____	_____

Fluid Code	Fluid Description	Units
_____	_____	_____
_____	_____	_____
_____	_____	_____

10 : MANNY SILVA

The Purpose of This Plan is to RAISE EXISTING Plumbing By Plumber SO THAT sewer CAN GRAVITY FLO And ELIMINATE E-1 Pumps THAT HAVE BEEN A PROBLEM

Existing E-1 Pump to Be Eliminated

For Landlord,

Bob CANESSA
Cell # 508-916114

Existing E-1 Pump to Be Eliminated

HATHAWAY Road

Existing Gravel Drive

7 Pine Ridge

12' FORMER ALN EXISTING

PROPOSED 6" GRAVITY STUB

2% slope

45' PROPOSED 6" GRAVITY STUB 2% slope

Existing 6" Gravity stub approx 4' FT. Deep

Pine Ridge St.

Proposed Cleanout with Cover



763 HATHAWAY Rd.

BOB CANESSA # 508-416-1144

Hathaway Rd.

E-1 Pump
to Be
Removed

PROPERTY
LINE

Proposed 6" Gravity line
To Replace 1 1/2" Force Main

Proposed
6" PVC
Gravity Service

E-1 Pump to Be
Removed

#7 Pine Ridge St.

Proposed
CLEANOUT

Currently SHARED
Existing 6" STUB
To Be dedicated to 763
HATHAWAY Rd.

Proposed CLEANOUT

New 6" PVC STUB TO
service #7 Pine Ridge
Existing 8" sewer MAIN

Pine
Ridge St.