

CITY OF NEW BEDFORD.
STREET DEPARTMENT.

DRAIN

Permit

No. 376 B

April 6 1908

lay drain from premises of Hermitas Bergeron

No. Tallman Street S. S. west of Conditche

to connect with Tallman Street sewer

Bill to Hermitas Bergeron

145 Tallman St.

C. F. Lawton
Supt. of Streets.
per A. T. S.

paid
O. H.

Return of Foreman.

Entered April 10 1908

Time 11 A.M.

By Frank B. DeMello


COST.

Labor	341 hours @ 25	8	50
	8 1/2 " 28	2	38
	8 " 38	1	14
	"	12	02
	"		
	"		
	"		
	"		

Stock Cement 15
Antone & Sylvia
Channel Slaton

Carting 50

Total Cost \$ 12 77
 Deposit \$ 15 00
 Balance due

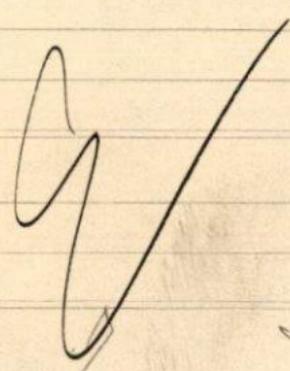

Pieces pipe to curb h. W
 " " curb to house 5
 Cut at Sewer 9 ft
 Cut at curb 7 ft
 Size of pipe 6 in
 Correct

Frank B. DeMello
Foreman.

DRAIN.

CITY OF NEW BEDFORD.

PAID.

Property assessed.
Property not assessed charged \$10.00.
~~Property not assessed entering a trunk sewer~~
Estimated cost of drain \$15.00 Paid

Permit No. 3763

OFFICE OF CITY CLERK.

BOARD OF HEALTH.

Permit to Drain. No. 8157

New Bedford, April 6, 1908.

I hereby request that a drain be laid from premises Annidas Bergeron south side, Sallman street, west of Bonditch street.

to connect with the Sallman street sewer

The same to be laid in such manner and location in the street and the surface replaced, as shall be directed by the Superintendent of Streets.

And I hereby agree to pay at the office of the City Treasurer all cost of performing the above work in the manner specified, in excess of the deposit made herewith, within 10 days of the completion of the work.

G. Sherman Witness.

Annidas Bergeron Applicant. 145 Sallman

DUPLICATE

It is understood and agreed that the deposit of \$15.00 made with this application shall be applied to the payment of the cost of performing the work done thereunder.

New Bedford, 190 .

To the City Clerk of the City of New Bedford:

I hereby grant.....

the privilege of draining his premises.....street.....side

..... of

.....

through the private drain owned by me connecting with the sewer in.....

street.....

.....

Owner.