
CITY OF NEW BEDFORD.

DRAIN

STREET DEPARTMENT.

Permit No. 3 938.

Supt. of Streets.

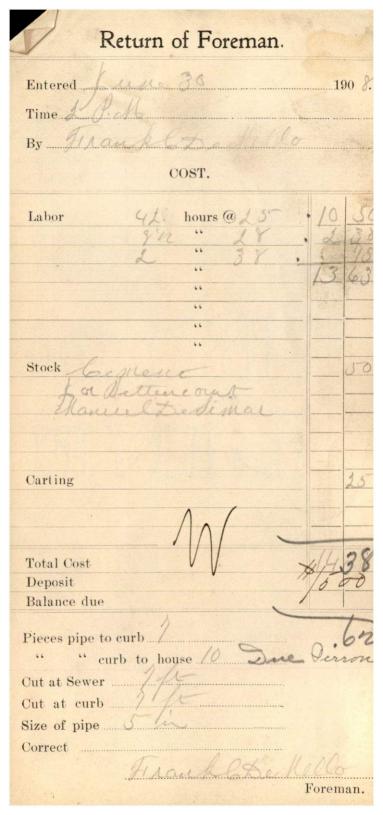

DRAIN.

CITY OF NEW BEDFORD.

Permit

OFFICE OF CITY CLERK.

PAID.

Property not assessed charged \$10,00.

une 22, 1908.

Property not assessed entering a trunk

Estimated cost of drain ... 45

BOARD OF HEALTH.

Permit to Drain.

I hereby request that a drain be

to connect with the The same to be laud

replaced, as shall be directed by the Superintendent of Streets.

And I hereby agree to pay at the off the City Treasurer all cost of performing the above work in

Witness.

New Bedford,

from premises

.....in such manner and location in the street and the surface

the manner specified, in excess of the deposit made herewith, within 10 days of the completion of the work.

	New Bedford,	190 .
To the City Clerk of the City of New Bedford:		
I hereby grant		
the privilege of draining his premises	street	side
of		
through the private drain owned by me connecting	with the sewer in	
street	4 (2/11)	
		Owner.