

CITY OF NEW BEDFORD.
STREET DEPARTMENT.

DRAIN

Permit

No.

3973

Clear drain from premises of Frank J. Rose
No. 329 So. First Street W. S. Grinnell & Cornwall
July 1908.

to connect with

sewer

Bill to

Frank J. Rose
116 So. Water St.

C. F. Lawton
Supt. of Streets.
per D.

Return of Foreman.

Entered July 7 1908

Time 3 P.M.

By Frank L. Meller

COST.

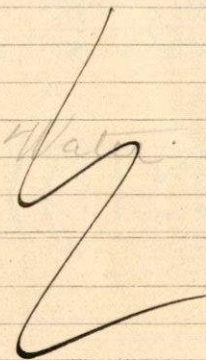
Labor

3 hours @ 25
1 " 38
 " "
 " "
75
38
113

Stock

Carting

Water


50
50

Total Cost

Deposit

Balance due

\$2.13

Pieces pipe to curb.....

" " curb to house.....

Cut at Sewer

Cut at curb

Size of pipe

Correct

Frank L. Meller

Foreman.

DRAIN.

CITY OF NEW BEDFORD.

PAID.

Property assessed.

Property not assessed charged \$10.00.

Property not assessed entering a trunk sewer.

Estimated cost of drain.....

Permit

No. **3973**

OFFICE OF CITY CLERK.

BOARD OF HEALTH.

Permit to Drain.

No.

New Bedford, *July 7*, 190*8*.

I hereby request that a drain be *changed* from premises *Frank G. Rose*

329 So. First Street, west side, between
Gunnell and Scotland

to connect with the

The same to be *changed* in such manner and location in the street and the surface replaced, as shall be directed by the Superintendent of Streets.

And I hereby agree to pay at the office of the City Treasurer all cost of performing the above work in the manner specified, in excess of the deposit made herewith, within 10 days of the completion of the work.

G. J. Sherman
Witness.

Frank G. Rose
Applicant.
111 So. Water St.

It is understood and agreed that the deposit of \$ made with this application shall be applied to the payment of the cost of performing the work done thereunder.

To soon as possible

New Bedford, 190 .

To the City Clerk of the City of New Bedford:

I hereby grant

the privilege of draining his premises.....street side

..... of

.....

through the private drain owned by me connecting with the sewer in.....

street.....

.....

Owner.