

CITY OF NEW BEDFORD.  
STREET DEPARTMENT.

DRAIN

Permit

No. 3982

July 11, 1908.  
Cloger drain from premises of John Farlin Est  
No. 680 S. First Street E. S., Blackmer & Delano  
to connect with sewer  
Bill to J. L. Kenealy & Franklin St.  
C. T. Lantieri  
Supt. of Streets.

# Return of Foreman.

Entered July 13 190 8

Time 7 A.M.

By Frank L. DeHeller


## COST.

Labor	4 hours @ 25	1 00
	2 " 38	73
	"	73
	"	
	"	
Stock

Carting

Water

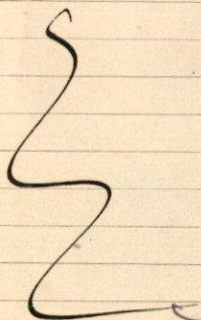

Total Cost

Deposit

Balance due

\$ 2.73

Pieces pipe to curb.....

" " curb to house .....

Cut at Sewer .....

Cut at curb .....

Size of pipe .....

Correct .....

Frank L. DeHeller  
Foreman.



**DRAIN.**

**CITY OF NEW BEDFORD.**

**PAID.**

Property assessed.

Property not assessed charged \$10.00.

Property not assessed entering a trunk sewer

Estimated cost of drain.....

Permit

**3982**

No.....

**OFFICE OF CITY CLERK.**

**BOARD OF HEALTH.**

Permit to Drain.

New Bedford,

July 11, 1908.

No.....

I hereby request that a drain be cleaned from premises

680 So First street, east side, between  
Blackman and Delano

to connect with the

The same to be cleaned in such manner and location in the street and the surface replaced, as shall be directed by the Superintendent of Streets.

And I hereby agree to pay at the office of the City Treasurer all cost of performing the above work in the manner specified, in excess of the deposit made herewith, within 10 days of the completion of the work.

E. J. Sherman

Witness.

L. H. Kenealy S. Franklin  
Applicant.

It is understood and agreed that the  
deposit of \$ ..... made with this  
application shall be applied to the  
payment of the cost of performing the  
work done thereunder.

New Bedford, ..... 190 .

To the City Clerk of the City of New Bedford:

I hereby grant .....

the privilege of draining his premises..... street ..... side

..... of .....

.....  
through the private drain owned by me connecting with the sewer in.....

street.....

.....  
Owner.