

CITY OF NEW BEDFORD.

STREET DEPARTMENT.

DRAIN

Permit

No. 4003

Clear drain from premises of Mmanuel D. Alves July 20 1908.  
No. 73 Mosher Street N. S. Peter. County & Crapo  
to connect with \_\_\_\_\_ sewer

Bill to Mmanuel M. Alves,  
73 Mosher St.

C. F. Lawton  
Supt. of Streets  
per D.

# Return of Foreman

Entered July 21 1908


Time 3 P.M.

By Frank L. DeMello

## COST.

Labor	2	hours @	25		50
	1	"	38		38
		"			88

Stock

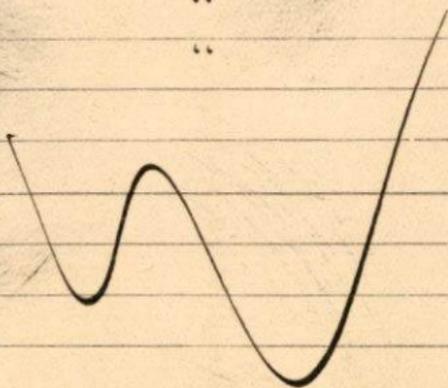

Carting

Water

Total Cost

Deposit

Balance due

50
38
88
50
50
1.88

Pieces pipe to curb.....

“ “ curb to house.....

Cut at Sewer.....

Cut at curb.....

Size of pipe.....

Correct.....

Frank L. DeMello

Foreman.

DRAIN.

CITY OF NEW BEDFORD.

PAID.

Property assessed.  
Property not assessed charged \$10.00.  
Property not assessed entering a trunk sewer  
Estimated cost of drain.....

Permit No. 4003

OFFICE OF CITY CLERK.

BOARD OF HEALTH.

Permit to Drain.

New Bedford, July 20, 1908.

No.

I hereby request that a drain be closed from premises Manuel A. Altes

73 North St. north side, between County  
and Crapo

to connect with the

The same to be closed in such manner and location in the street and the surface replaced, as shall be directed by the Superintendent of Streets.

And I hereby agree to pay at the office of the City Treasurer all cost of performing the above work in the manner specified, in excess of the deposit made herewith, within 10 days of the completion of the work.

G. J. Sherman  
Witness.

Manuel A. Altes  
Applicant.  
73 North St.

DUPLICATE

It is understood and agreed that the deposit of \$ ..... made with this application shall be applied to the payment of the cost of performing the work done thereunder.

New Bedford, ..... 190 .

To the City Clerk of the City of New Bedford:

I hereby grant .....

the privilege of draining his premises..... street ..... side

..... of .....

..... through the private drain owned by me connecting with the sewer in.....

street.....

.....

Owner.