

CITY OF NEW BEDFORD.

STREET DEPARTMENT.

DRAIN

Permit

No. 4042

has drain from premises of Jesse Costa Aug 5 1908.

No. 4 Fair Street N. E. cor. Grape

to connect with Fair Street sewer

Bill to Jesse Costa
408 First St.

C. F. Sawton
Supt. of Streets.
per

Card
C. H.

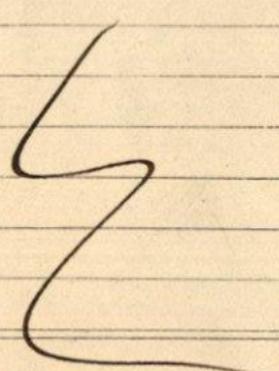
Return of Foreman

Entered August 15 1908

Time 10 AM

By Frank B. DeMille

COST.

Labor	17	hours @	25		4	25
	8 ^{1/2}	"	28		2	38
	3	"	38		1	14
		"			7	77
		"				
		"				
		"				
Stock	<u>Cement</u>					25
	<u>Antone's Portland</u>					
	<u>John's Portland</u>					
Carting						50
Total Cost						852
Deposit						1500
Balance due						

Pieces pipe to curb 7 Due 6.48
 " " curb to house 4 Cost
 Cut at Sewer 5 ft
 Cut at curb 5 ft
 Size of pipe 6 in
 Correct.....

Frank B. DeMille
Foreman.

DRAIN.

CITY OF NEW BEDFORD.

PAID

Property assessed.
Property not assessed charged \$10.00.
Property not assessed entering a trunk sewer
Estimated cost of drain. \$15.00

Permit No. 4042

OFFICE OF CITY CLERK.

BOARD OF HEALTH.

Permit to Drain.

New Bedford, Aug. 5, 1908.

No. 8331

I hereby request that a drain be laid from premises Jesse Costa N. E. corner Fair and Temple streets.

to connect with the Fair street sewer

The same to be laid in such manner and location in the street and the surface replaced, as shall be directed by the Superintendent of Streets.

And I hereby agree to pay at the office of the City Treasurer all cost of performing the above work in the manner specified, in excess of the deposit made herewith, within 10 days of the completion of the work.

J. Sherman Witness.

Jesse Costa 408 Fair st Applicant.

DUPLICATE

It is understood and agreed that the deposit of \$15.00 made with this application shall be applied to the payment of the cost of performing the work done thereunder.

New Bedford,..... 190 .

To the City Clerk of the City of New Bedford:

I hereby grant.....

the privilege of draining his premises.....street.....side

.....of.....

through the private drain owned by me connecting with the sewer in.....

street.....

.....

Owner.