

CITY OF NEW BEDFORD.
STREET DEPARTMENT.

DRAIN

Permit

No. 6016

July 1, 1910

19

Lay drain from premises of Mary L. Nolan

No. No. Front Street N. W. Cor. Hathaway

to connect with Hathaway street sewer

Bill to Pierre Nolan,
180 Davis st.

C. F. Lawton

Supt. of Streets.

(D)

CARD

O. K.

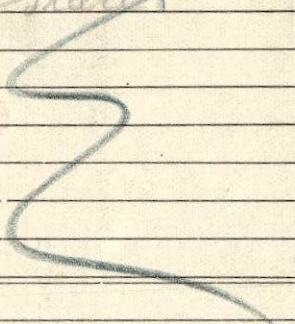
Return of Foreman.

Entered July 6 1910.

Time 1 P.M.

By Frank B. Keller

COST.

Labor	34	hours @	28	.9	52
	8 1/2	"	31	.2	66
	2	"	44	'	88
		"		13	05
		"			
		"			
		"			
Stock	Cement Antoni H. Kato Manuel Gross				20
Carting					50
Total Cost					13 80
Deposit					\$ 20 00
Balance due					6 20

Pieces pipe to curb..... 7

" " curb to house..... 4

Cut at Sewer..... 8 ft

Cut at curb..... 6 ft

Size of pipe..... 6 in

Correct.....

Due
Adams

Frank B. Keller

Foreman.