

7
CITY OF NEW BEDFORD.
STREET DEPARTMENT.

DRAIN

Permit

No. 6195

August 26 1910.

Land W. K. Lay drain from premises of Edward Geary

No. 55 Earle Street east of Acushnet Avenue

to connect with Earle Street sewer

Bill to Edward Geary, 200 Earle Street

C. F. Lawton
per m.

Supt. of Streets.

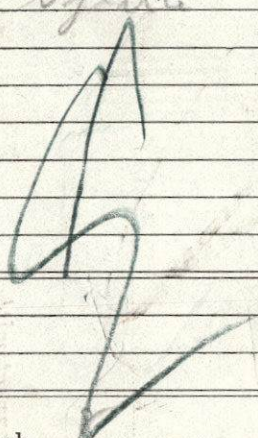
Return of Foreman.

Entered Sept 24 1900.

Time 1 P.M.

By Frank B DeKello

COST.

Labor	36	hours @	28	10	13
	9	"	31	2	81
	3	"	44	1	31
		"		14	25
		"			
		"			
		"			
		"			
Stock	Cement Plaster John Tyler's				25
Carting					50
Total Cost				15	00
Deposit				20	00
Balance due				5	00

Pieces pipe to curb _____
 " " curb to house 5
 Cut at Sewer 10 ft
 Cut at curb 8 ft
 Size of pipe 6 in
 Correct _____

Frank B DeKello

Foreman.