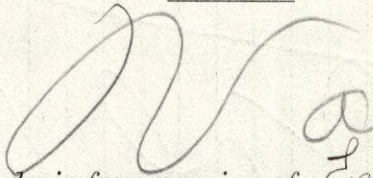


CITY OF NEW BEDFORD.
STREET DEPARTMENT.

DRAIN

Permit

No. 6231

 On September 12, 1910.
clear drain from premises of Edward J. Weeks
No. 148 Maxfield Street corner Walden Street
to connect with sewer

Bill to H. C. Vaughan, 23 Borden Street

C. F. Lawton

per M.

Supt. of Streets.

Return of Foreman.

Entered 19 .

Time

By

COST.

Labor

hours (@)

“

“

Stock

Carting

Total Cost

Deposit

Balance due

Pieces pipe to curb

“ “ curb to house

Cut at Sewer

Cut at curb

Size of pipe

Correct

Foreman.