

CITY OF NEW BEDFORD.
PUBLIC WORKS.

DRAIN

SUPERINTENDENT'S OFFICE,

Permit

No. 6489

May 9 1902

To J. C. De Mello

FOREMAN IN CHARGE OF DRAIN.

Clear drain to connect with Fourth St Sewer

From premises of Manuel V. Sylvia
No. 280 Fourth street east side south of Potomaska

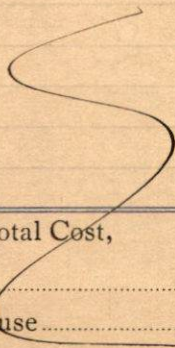
Bill to above

C. F. Lantieri
Superintendent of Public Works.

Return of Foreman.

Entered May 9 190 2
 Time 2 P.M.
 By Frank B. De Kello

COST.

Labor	2	hours @	22 1/2	45
	1	"	31	31
		"		76
		"		
		"		
Stock	<u>Cement</u>			10
Carting				25

Total Cost, 111

Pieces pipe to curb.....
 " " curb to house.....
 Cut at Sewer.....
 Cut at Curb.....
 Size of pipe.....
 Correct.

Frank B. De Kello

Foreman.