

CITY OF NEW BEDFORD.
STREET DEPARTMENT.

DRAIN

Permit

No. 6670

Mar 8, 1911.

lay drain from premises of E. B. MacLeod
No. S. S. Clinton Street bet. Rotch + James Street
to connect with Clinton Street sewer

Bill to E. B. MacLeod, 92 1/2 Purchase Street
C. F. Lawton

Supt. of Streets.

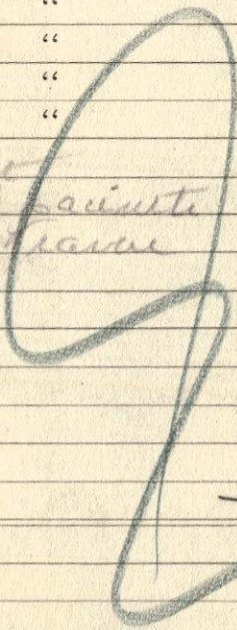
per "Sm"

Cord
OK

Return of Foreman.

Entered March 28 191/ .
 Time 2 P.M.
 By Frank B. DeMello

COST.

Labor	23	hours @ 28	6	47.
	11 1/2	" 31	4	36
	3	" 44	3	60
		"	1	31
		"	11	38
		"		
		"		
		"		
		"		
Stock				25
Carting				25
Total Cost			77	88
Deposit			20	00
Balance due				8 12

Pieces pipe to curb 7
 " " curb to house 8
 Cut at Sewer 8 ft
 Cut at curb 4 1/2 ft
 Size of pipe 5 in
 Correct

Frank B. DeMello

Foreman.