

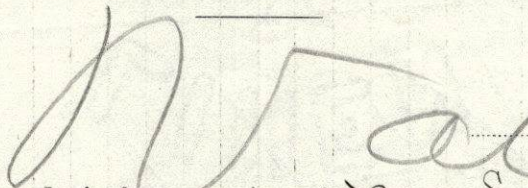
CITY OF NEW BEDFORD.

STREET DEPARTMENT.

DRAIN

Permit

No. 7002

 July 26, 1910.

Clear drain from premises of Mrs Sarah Arigan,
No. 64 Hazard Street between County + State Sts
to connect with sewer

Bill to Mrs Sarah Arigan, 587 Purchase Street.

C. F. Lawton,
Supt. of Streets.

Return of Foreman.

Entered 19 ..

Time

By

COST.

Labor

hours @

“

“

Stock

Carting

Total Cost

Deposit

Balance due

Pieces pipe to curb

“ “ curb to house

Cut at Sewer

Cut at curb

Size of pipe

Correct

Foreman.