

DRAIN

CITY OF NEW BEDFORD.

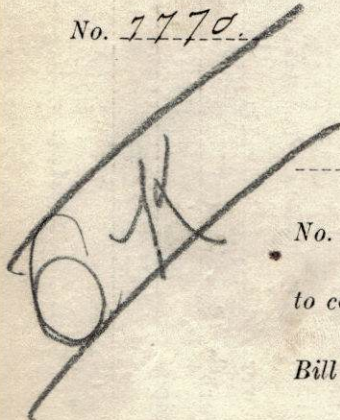
STREET DEPARTMENT.

Permit

No. 7770

May 3

1912.

 Lay drain from premises of Frederick W. Ternilegar
No. Parker Street S. E. part of Summer
to connect with Parker Street sewer
Bill to Frederick W. Ternilegar

C. F. Stanton

Supt. of Streets.

Return of Foreman.

Entered May 20 191 2

Time 10 A.M.

By Frank B. DeMello

COST.

Labor	hours	@		
28 1/2		28	8	02
8 1/2	"	31	2	66
3	"	44	1	31
	"		11	99
	"			
	"			
	"			
	"			

Stock Cement 25
for Belthurst
House, Belmont

Carting 50

Total Cost 274

Deposit \$ 20.00

Balance due 7.26

Pieces pipe to curb 10

" " curb to house 5

Cut at Sewer 6 ft

Cut at curb 5 ft

Size of pipe 6 in

Correct

Frank B. DeMello

Foreman.