

214
NOTICE TO SUPERINTENDENT OF STREETS.

Drain Permit No. 7786

City of New Bedford,

Office of City Clerk, **MAY 13 1912** 191

To Superintendent of Streets.

Permission has this day been issued to

Name John Tarans Address 536 So. Water st.

to lay drain from premises So. side Switz-st, between Bolton
& Hemlock,

to connect with sewer in Switz- street.

James Dignam
Asst. City Clerk.

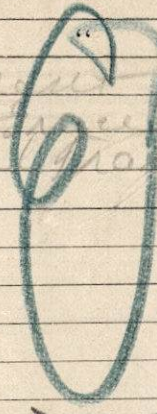
Return of Foreman.

Entered May 24 191 2

Time 1 P.M.

By Frank B. De Mello

COST.

Labor	56	hours @	28	15	75
	14	"	31	4	38
	4	"	44	1	75
		"		21	88
		"			
		"			
		"			
Stock					25
Carting					25
Total Cost				22	38
Deposit				\$ 20.	-
Balance due					

Pieces pipe to curb 9 2.38
 " " curb to house 7 True
 Cut at Sewer 1 1/2 City
 Cut at curb 2 1/2
 Size of pipe 2 in
 Correct _____

Frank B. De Mello
 For n.