

C. R.

NOTICE TO SUPERINTENDENT OF STREETS.

Drain Permit No. 8145

City of New Bedford,

JAN 2 1913

Office of City Clerk, _____ 191

To Superintendent of Streets.

Permission has this day been issued to

Name Joseph Blies Address 8 Roosevelt St.

to lay drain from premises north side Roosevelt St.
near Cove St

to connect with sewer in Roosevelt street.

James Dignam
Asst. City Clerk.

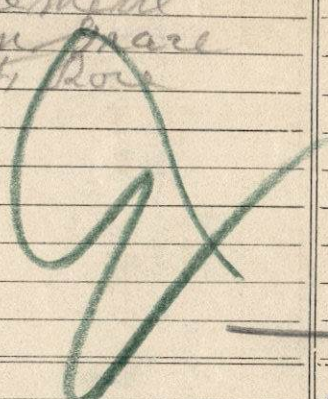
Return of Foreman.

Entered Jan 13 1913

Time 11 A.M.

By Frank B. DeMello

COST.

Labor	34	hours @	31	10	63
	8 ¹ / ₂	"	34	2	92
	3	"	50	1	50
		"		15	05
		"			
		"			
		"			
Stock	Genuine John Fare Wm. H. Rose				25
Carting					50
Total Cost				15	80
Deposit				4	20 00
Balance due					

Pieces pipe to curb 8

" " curb to house 6

Cut at Sewer 8 ft

Cut at curb 6 ft

Size of pipe 6 in

Correct

Frank B. DeMello

For n.