

C. R.

NOTICE TO SUPERINTENDENT OF STREETS.

Drain Permit No. 8363

City of New Bedford,

Office of City Clerk, JUL 14 1913 191

To Superintendent of Streets.

Permission has this day been issued to

Name Park Dept. Address F. W. Cook, Supt

to lay drain from premises Brooklawn Park, two
houses

to connect with sewer in Perry street.

James Dignass
City Clerk.

Return of Foreman.

Entered July 18 191 3

Time 3 P.M.

By Frank B. DeHelle

COST.

Labor	311	hours @ 31	96	41-
	73	" 34	24	82
	14	" 50	7	00
		"	1	28 23
		"		
	2642	" 31	82	00
	432	" 34	14	61
	12	" 50	6	00
Stock			1	02 61
	126	31	39	06
	14	34	4	81
	5	50	2	50
			277	21
Carting			1	00
			278	21
Material per attached slip			130	26
Total Cost			408	47
Deposit	<u>No deposit</u>			
Balance due				

Pieces pipe to curb-----

" " curb to house-----

Cut at Sewer-----

Cut at curb-----

Size of pipe-----

Correct-----

Frank B. DeHelle

Foreman.




32 1/4
12 1/2
16 1/2
8

404
20
80.80

1-6" Band - 58
1-6" Band - 77

6" = 14¢
8" = 20¢

4 bags cement @ 35¢
2 lbs dynamite @ 25¢
1 box powder
9 bricks
3 1/2 ft wire pipe - 14¢ ft.
40¢ 11 8 in pipe - @ 20¢
1-6" 8" branch
1-5" band

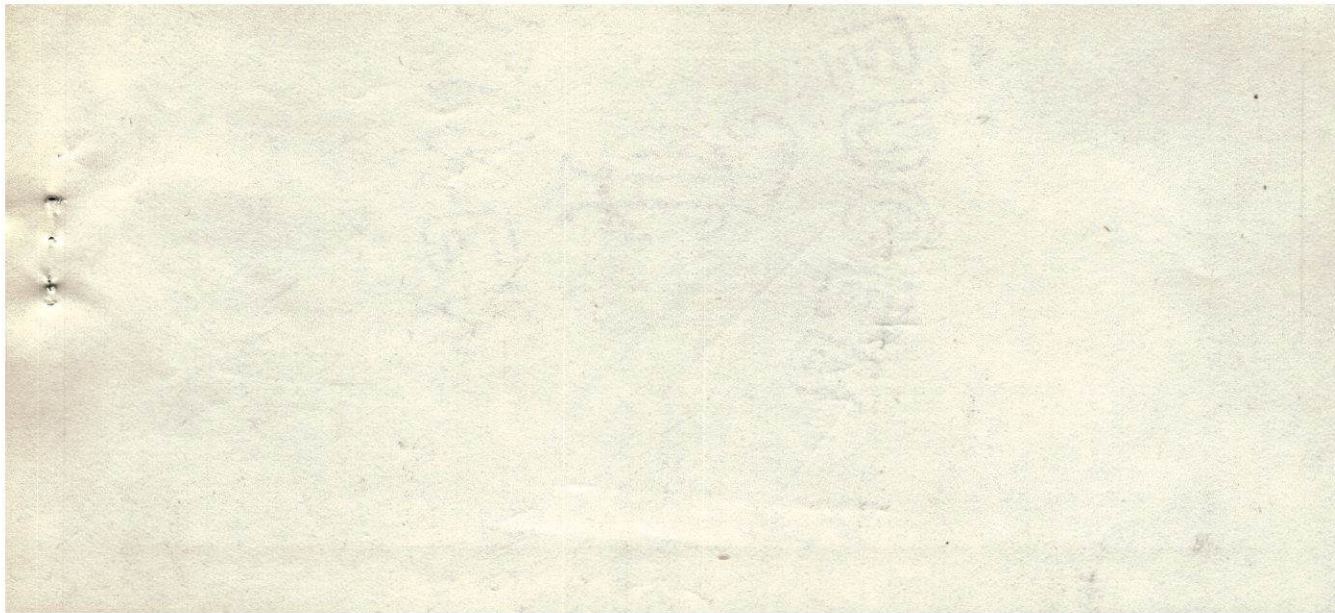

4 Bags Cement @ 35¢	=	1.40
2 lb. Dynamite @ 25¢		.50
7 Exploders @ 5¢		.35
9 Drills sharpening @ 5¢		.45
322 ft. 6" pipe @ 14¢	=	45.08
404 ft. 8" " @ 20¢		80.80
1-6 in 8" Branch		1.10
1-6 " Bend		.58
		130.26

Total cost \$ 408.47

11