

OK.
NOTICE TO SUPERINTENDENT OF STREETS.

Drain Permit No. 85-77

City of New Bedford,

Office of City Clerk,

NOV 25 1913 191

To Superintendent of Streets.

Permission has this day been issued to

Name Mannel E. Baptista Address 34 Page st.

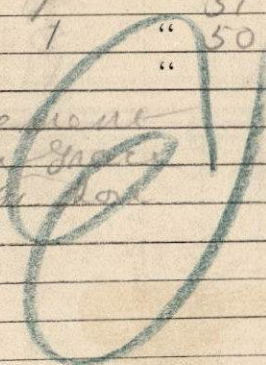
to lay drain from premises Mannel E. Baptista, on the east-
side of Page st. between Allen & Isape sts.
to connect with sewer in Page street.

James Dignam
City Clerk.

Return of Foreman.

Entered Dec 5 1913
 Time 3 P.M.
 By Frank B DeHeller

COST.

Labor	57	hours @	31	17	81.
	14	"	34	4	81.
	5	"	50	2	50
		"		25	12
		"			
Dec 8	9	"	31	2	81.
	1	"	50		50.
		"		28	43
Stock					25
Carting					50
Total Cost				29	18
Deposit				20	00
Balance due					

Pieces pipe to curb 9
 " " curb to house 4
 Cut at Sewer 12 ft
 Cut at curb 7 ft
 Size of pipe 6 in
 Correct _____

Frank B DeHeller

Fore